

PUMPING ARRANGEMENT.
 S. S. Nos. 480, 481, & 482
 Scale 1/4 inch = 1 Foot
 Under Deck Tonnage = 3660-966

Dumping plan
for

Mess. Russell 163 h^o 480-1-498.


No 480

S.S. Gibraltar

Grk report No 13245

No 481 S.S. British Monarch

Grk report No 13384

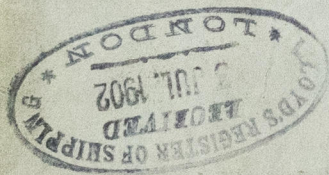

© 2020

Lloyd's Register
Foundation

GRK317-0163