


Longitudinal. Plan. S. S. N^o 33. +34
Scale $\frac{3}{8}$ Inch = One Foot.

"H. Wicander."

Greenock Report No.

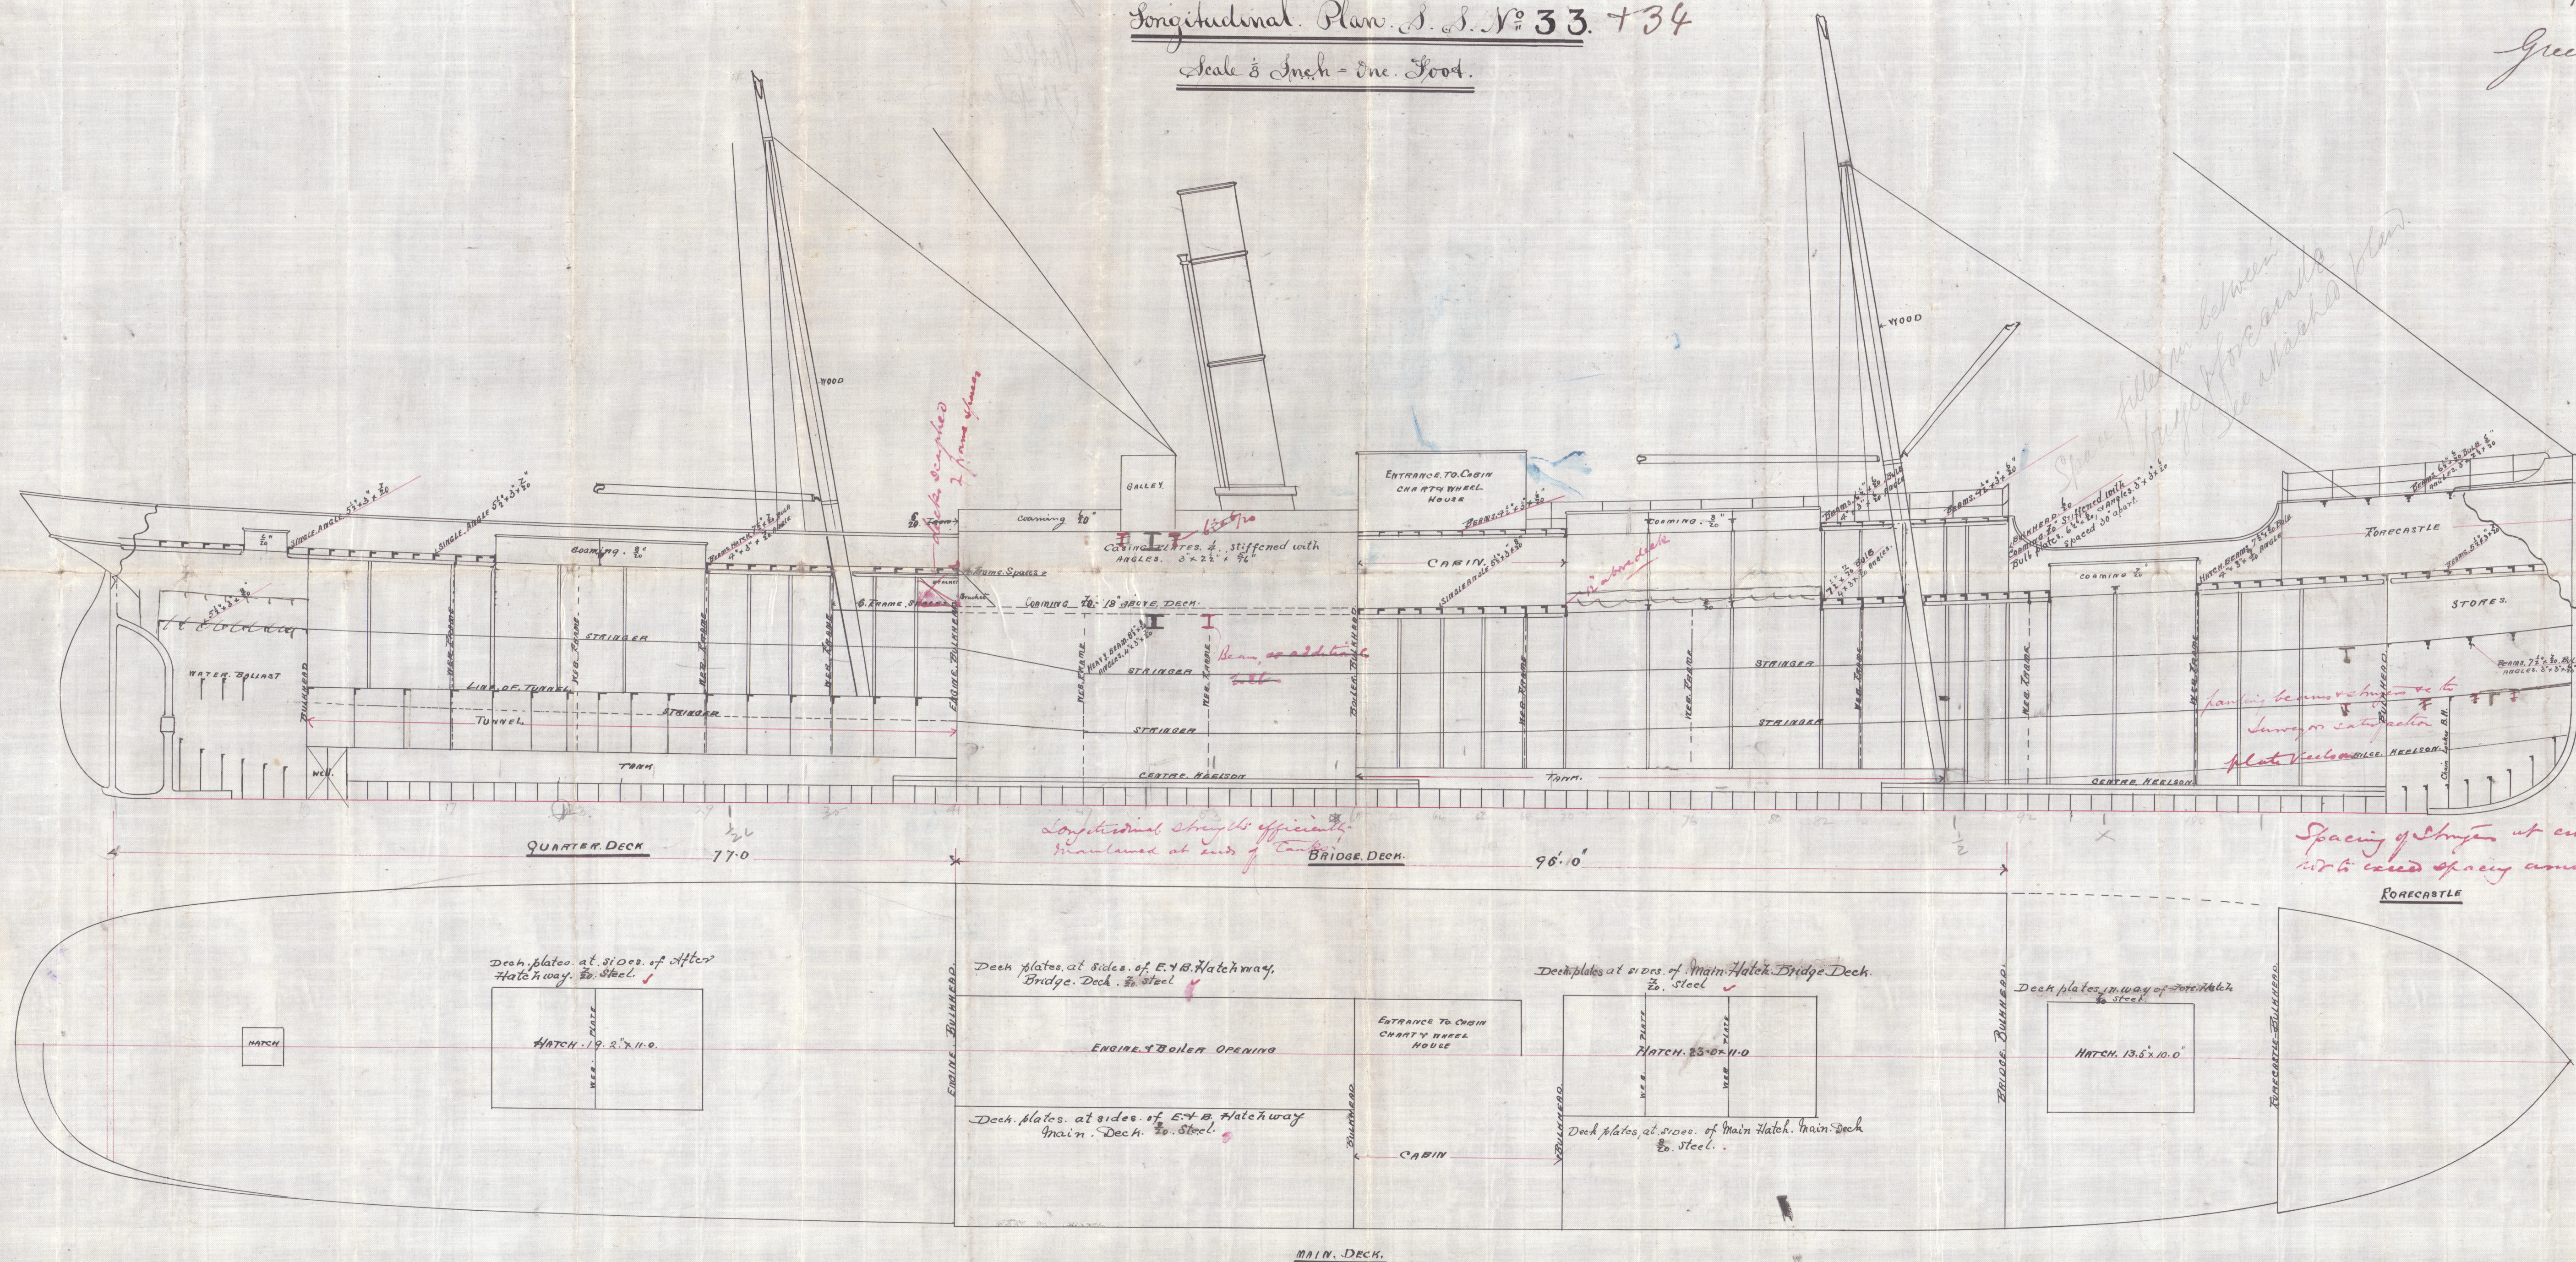

Spacing of strings at ends
not to exceed spacing amid life

12 SEP 90
CAMPBELTOWN SHIPBUILDING
CAMPBELTOWN

C.F.
1/17/90

"Brio."
Greenock Rept.
No. 10261.

"H. Wreander?"
Greenock Report No...

Profile
gdd plan }

© 2020

Lloyd's Register
Foundation

GRK317-0183