

s.s. "Brio"

Received at

Office,

18

Lloyd's Register of British and Foreign Shipping.

Greenock

(Report on Vessel No. 10261 Port of Greenock.)

No. 1860.a.

SHIP FORGINGS OR CASTINGS.

I have to report that the undermentioned Iron or Steel Forgings or Castings, manufactured by

Imp^r C O Reed & Co of Sunderland

for the Vessel No. 33, being built by The Campbeltown Sh Co.

of Campbeltown have been inspected by me as set forth below, and found to be, so far as can be seen, sound.


Mark on Forgings.

Lloyd's
No. 1860.a
Sh Co.

[Signature]
Sunderland

| | STERN FRAME. | RUDDER FRAME. | STEM. |
|------------------------|---|-----------------------------|----------------------|
| Material* | <u>Scrap iron</u> | <u>Scrap iron</u> | <u>Scrap iron</u> |
| How made | <u>Forged</u> | <u>Forged</u> | <u>Forged</u> |
| Dimensions | <u>7 1/2 x 12 3/4</u> | <u>5 1/2 - 8</u> | <u>7 1/4 x 2 3/8</u> |
| Progress on Inspection | <u>Forged & Smithed</u> | <u>Forged & Smithed</u> | <u>Forged</u> |
| Dates when Inspected | <u>Dec 27/90 Jan 10-19-26-30</u> <u>July 12/91</u> | <u>March 7-13-14/91</u> | <u>Dec 27/90</u> |

SKETCHES OF FRAMES SHEWING POSITION AND DESCRIPTION OF WELDS OF FORGINGS, OR PARTICULARS OF TESTS APPLIED TO CASTINGS.

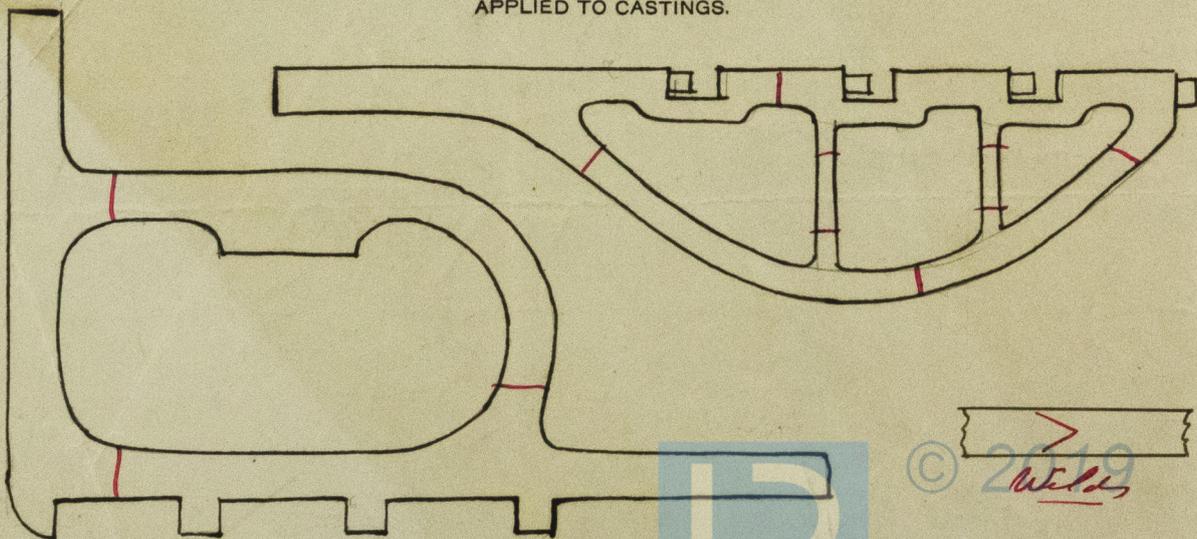

[Handwritten note]
© 2019
Welds

* If of Iron, state whether scrap or puddled Iron.

1860

s.s. "A. B. Rio."
Greenock Report
no. 10 261.