

"I overrased"

Received at

Office,

18

Lloyd's Register of British and Foreign Shipping.

(Report on Vessel No. 10284 Port Greenock)

Greenock

No. 16789

SHIP FORGINGS OR CASTINGS.

I have to report that the undermentioned Iron or Steel Forgings or Castings, manufactured by

The Breach Quay Forge Co. of Sunderland
for the Vessel No. 251, being built by Wm. Russell & Co.
of Greenock have been inspected by me as set forth below, and found
to be, so far as can be seen, sound

Mark on Forgings.

Lloyd's

No. 16789


86 C

Wm. Russell

Sunderland
16-5-91

	STERN FRAME.	RUDDER FRAME.	STEM.
Material*	<u>Scrap iron</u>	<u>Scrap iron</u>	<u>Scrap iron</u>
How made	<u>Forged</u>	<u>Forged</u>	<u>Forged</u>
Dimensions	<u>8 1/2" x 2 1/2"</u>	<u>6" x 3"</u>	<u>8 1/2" x 2 1/2"</u>
Progress on Inspection	<u>Forged & smithed</u>	<u>Forged & smithed</u>	<u>Forged</u>
Dates when Inspected	<u>June 21 July 8-12-24-31</u> <u>Aug 7/90</u>	<u>July 12-19-24-27</u> <u>17-24 April 2-18-24-28/91</u>	<u>Aug 7/90</u>

SKETCHES OF FRAMES SHEWING POSITION AND DESCRIPTION OF WELDS OF FORGINGS, OR PARTICULARS OF TESTS APPLIED TO CASTINGS.

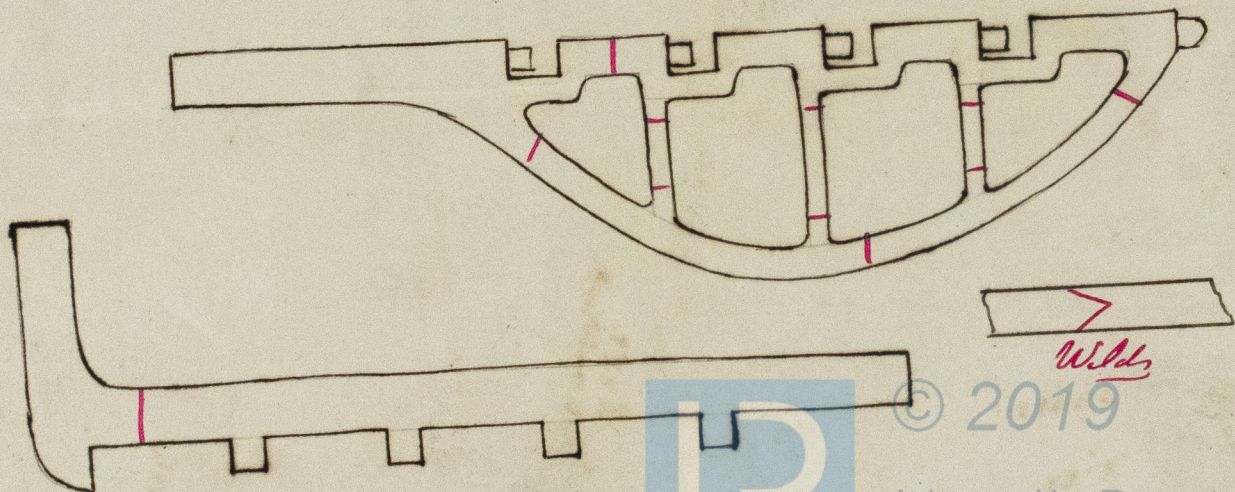

* If of Iron, state whether scrap or puddled Iron.