

"Villander"

Received at

Office

18

# Lloyd's Register of British and Foreign Shipping.

(Report on Vessel No. 10406 Port Greenock)

No. 618

## SHIP FORGINGS OR CASTINGS.

The words FORGINGS or CASTINGS, IRON or STEEL, should be struck out as may be required.

I have to report that the undermentioned Iron or Steel Forgings or Castings, manufactured by The Garrow Forge Co of Garrow for the Vessel No. 280, being built by Messrs Russell & Co of Greenock have been inspected by me as set forth below, and found to be, so far as can be seen, sound

Mark on Forgings.


Lloyd's  
No. 2540  
86

John Craig  
Newcastle

16/5/91

	STERN FRAME.	RUDDER FRAME.	STEM.
Material* . . . .	<u>Scrap iron</u>	<u>Scrap iron</u>	<u>Scrap iron</u>
How made . . . .	<u>Forged</u>	<u>Forged</u>	<u>Forged</u>
Dimensions . . . .	<u>9 - 2 1/4</u>	<u>6 1/4 - 3 1/4</u>	<u>9 1/2 - 2 1/4</u>
Progress on Inspection . . . .	<u>Forged &amp; Smithed</u>	<u>Forged &amp; Smithed</u>	<u>Smithed</u>
Dates when Inspected	<u>Feb 16-26 March 4</u> <u>10 April 3/91</u>	<u>March 25 April 3+5</u> <u>17 May 1-5/91</u>	<u>April 4 91</u>

SKETCHES OF FRAMES SHEWING POSITION AND DESCRIPTION OF WELDS OF FORGINGS, OR PARTICULARS OF TESTS APPLIED TO CASTINGS.

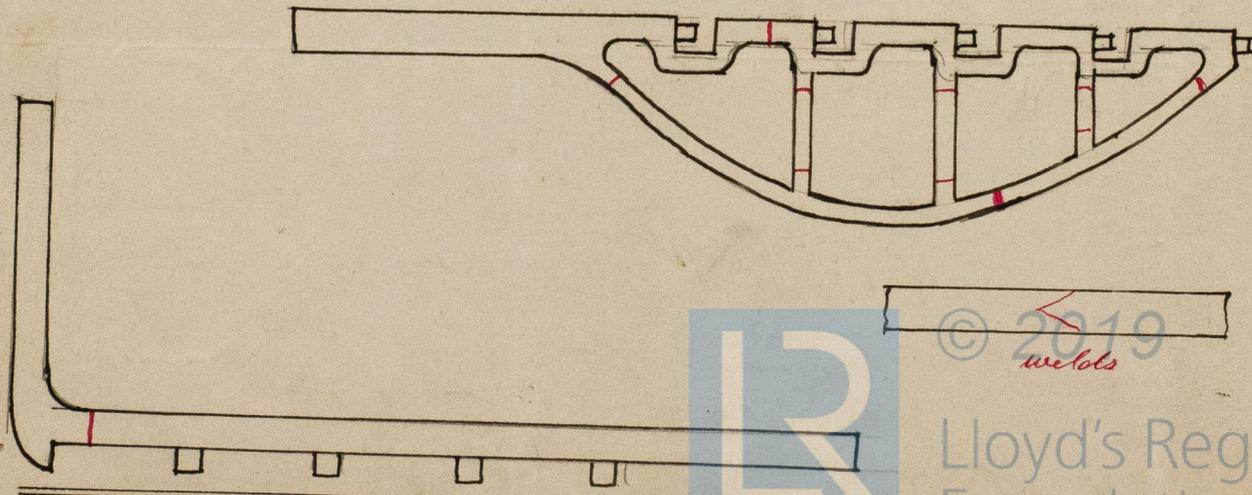

© 2019  
welds

Lloyd's Register  
Foundation