

"Dunbridge"

Received at

Office

12

Lloyd's Register of British and Foreign Shipping.

(Report on Vessel No. 10441 Port Greenock)

No. 866

SHIP FORGINGS OR CASTINGS.

I have to report that the undermentioned Iron or Steel Forgings or Castings, manufactured by

The Jarrow Forge & Co of Jarrow  
for the Vessel No. 77, being built by Messrs W Hamilton & Co  
of Greenock have been inspected by me as set forth below, and found  
to be, so far as can be seen, sound

Mark on Forgings.

Lloyd's

No. 311B

JB


John C Craig

Newcastle

17/10/91

	STERN FRAME.	RUDDER FRAME.	STEM.
Material* - - -	<u>Scrap Iron</u>	<u>Scrap Iron</u>	
How made - - -	<u>Forged</u>	<u>Forged</u>	
Dimensions - - -	<u>10 - 2 5/8</u>	<u>7 - 3 1/2</u>	
Progress on Inspection -	<u>Forged &amp; Smithed</u>	<u>Forged &amp; Smithed</u>	<u>not seen</u>
Dates when Inspected	<u>June 8-11-18 July 3</u> <u>9-14-17/91</u>	<u>September 9-17-22</u> <u>28 October 14/91</u>	

SKETCHES OF FRAMES SHEWING POSITION AND DESCRIPTION OF WELDS OF FORGINGS, OR PARTICULARS OF TESTS APPLIED TO CASTINGS.

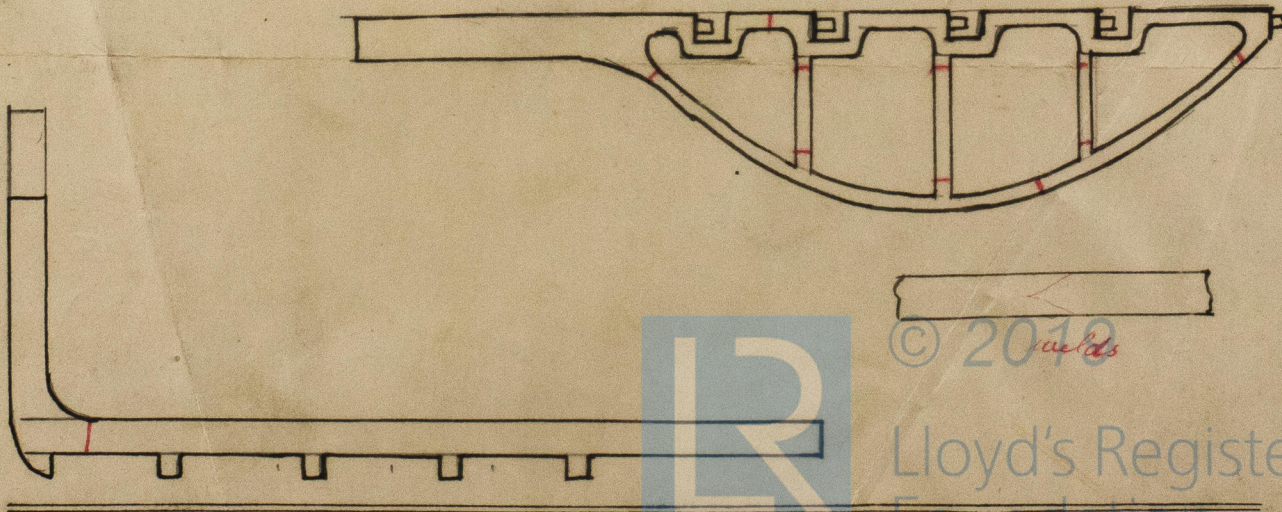



W<sup>m</sup> Hamilton & Co  
L no 77.  
Rpt. Longue S. F. R. H.

ENCLOSURE OR REVENUE STAMP REQUIRED



© 2019

Lloyd's Register  
Foundation