


*Revised plan of  
deck  
(Greenock Report No. 10457)*

*'Maria Rickmers'*  
Greenock Report No. 10457

*Note, Trimming scuttles to have plate covers bolted on  $\frac{1}{2}$ " thick*

*Arrangement of Trimming Scuttles  
in seven decks 77-267  
- Deck to deck = one foot -*

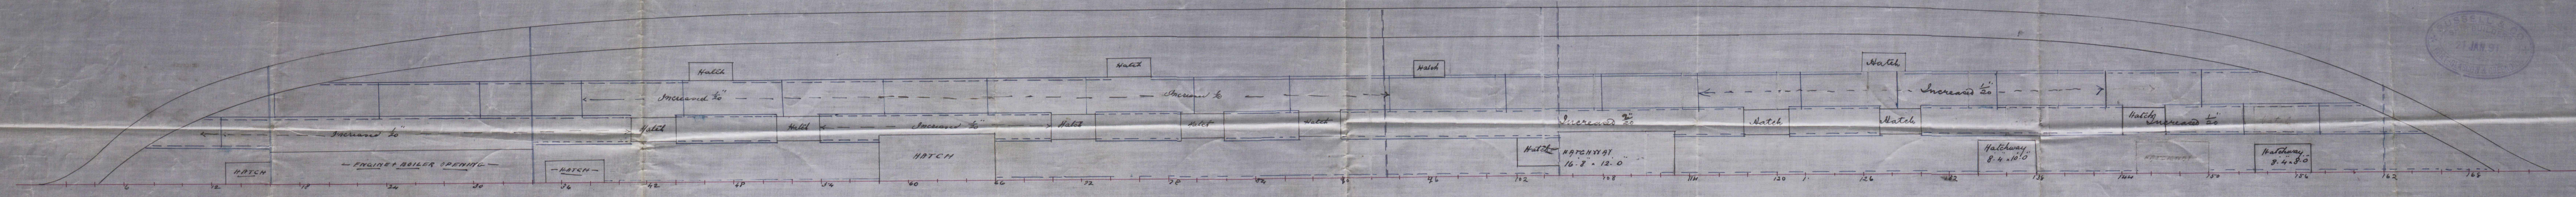

*RUSSELL & CO  
SHIPBUILDERS  
21 JAN 91  
GREENOCK & GLASGOW*

*GREENOCK REPORT NO. 10457*



Russell & Co. No 264  
Amended lower deck plan.  
(Maria Rickmers)

"Maria Rickmers"  
Greenock Report  
No. 10457.



© 2019

Lloyd's Register  
Foundation

GRK319-0201