



25.8.91.

— SKETCH SHEWING STIFFENING —
— IN WAY OF MAIN RIGGING —
— A. S. N^o 264 —

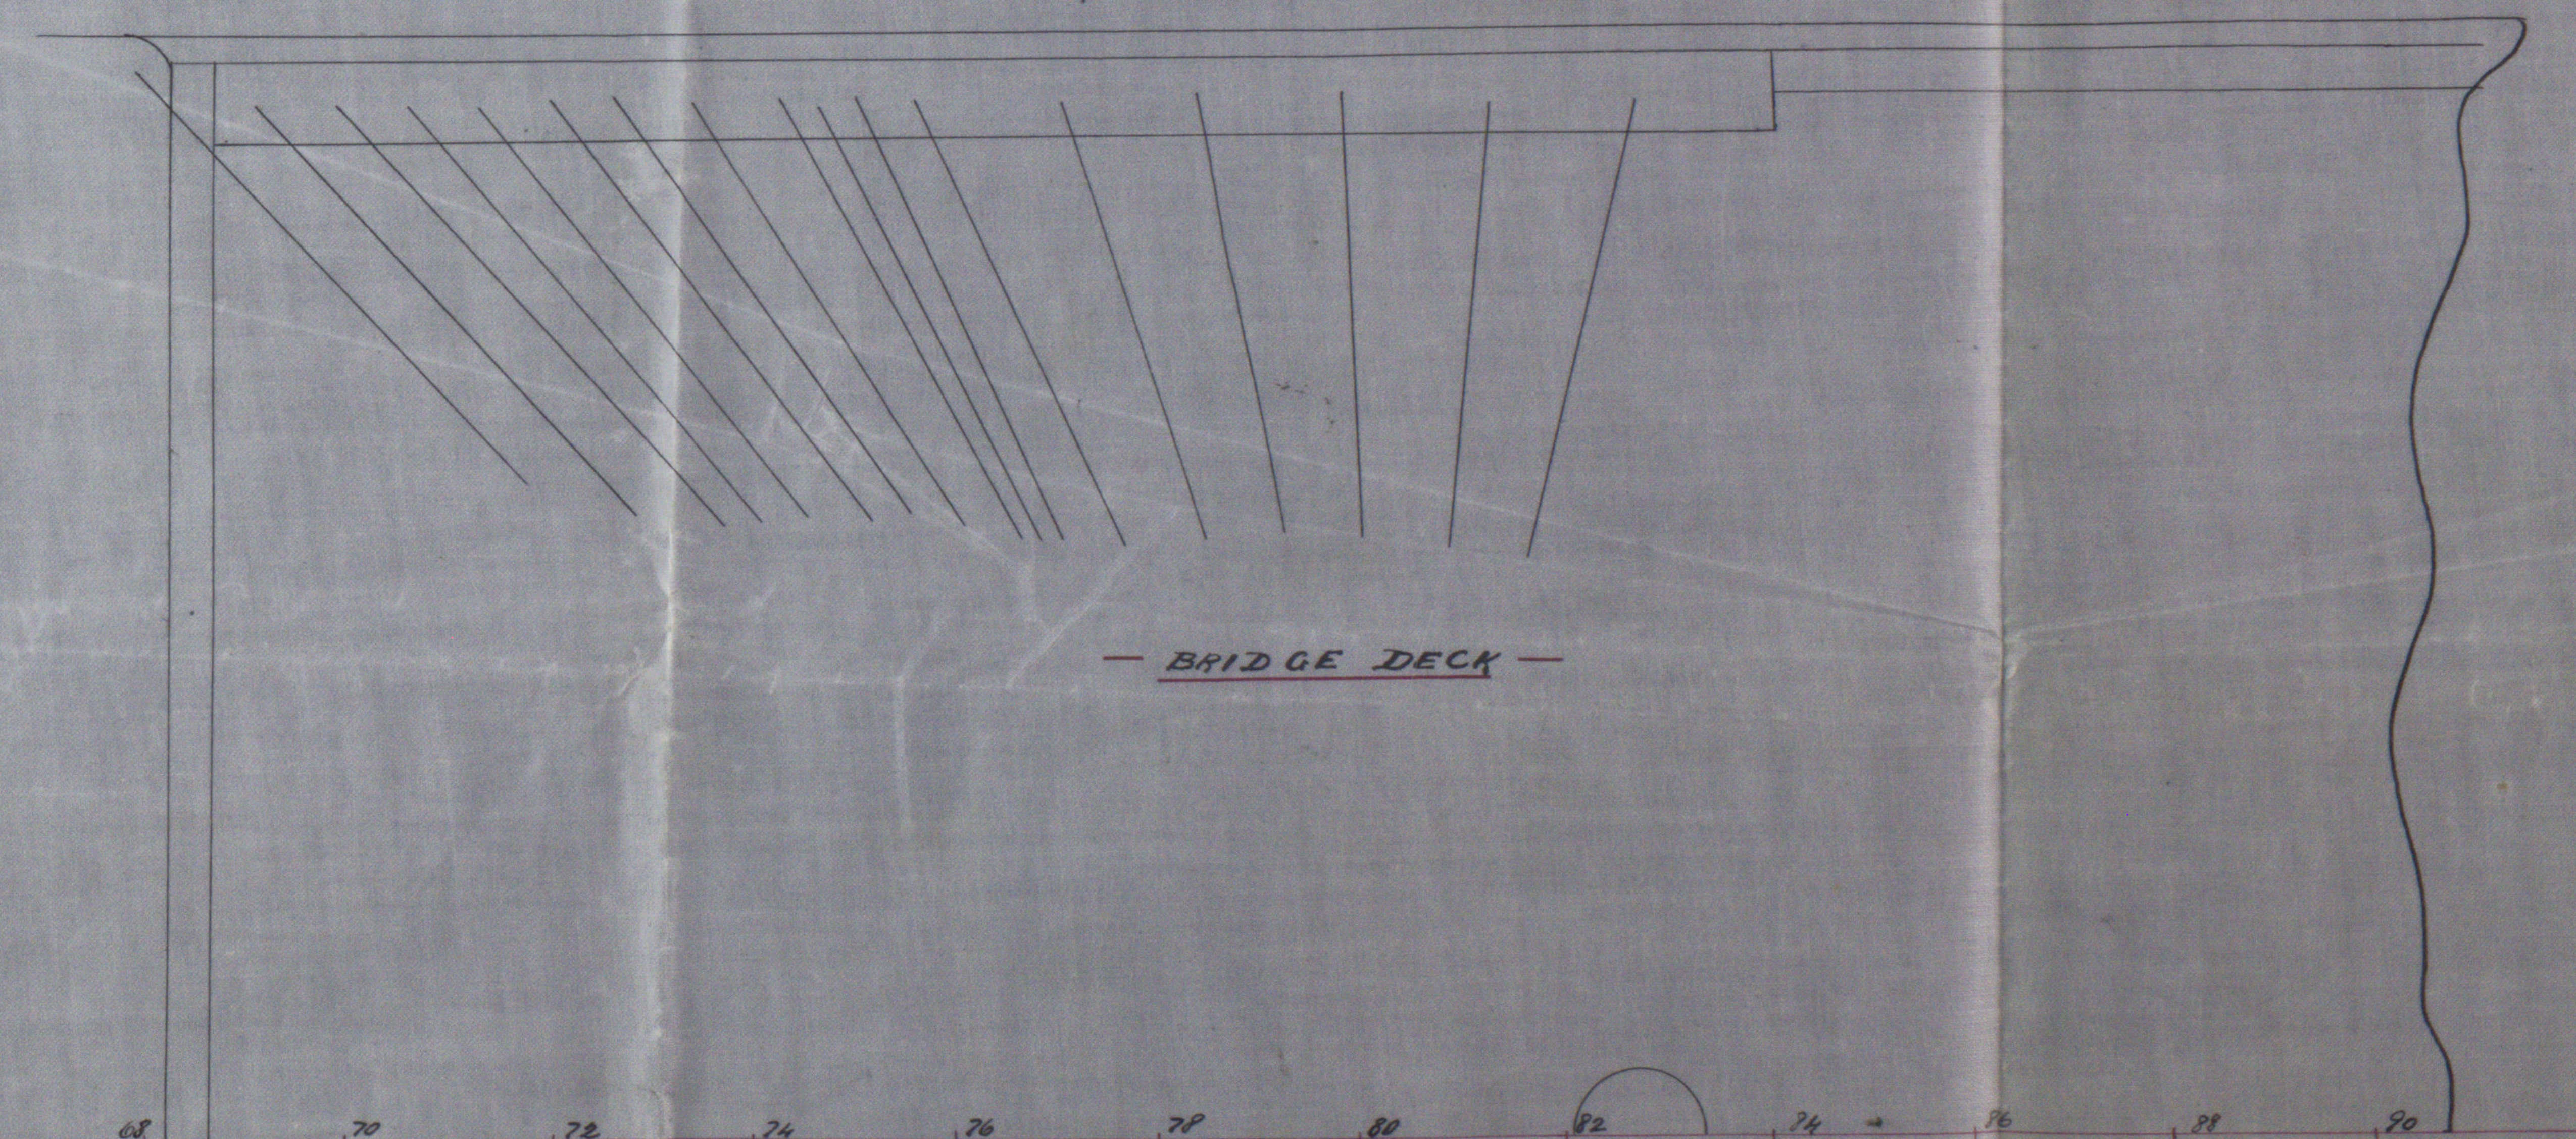


— BRIDGE DECK —

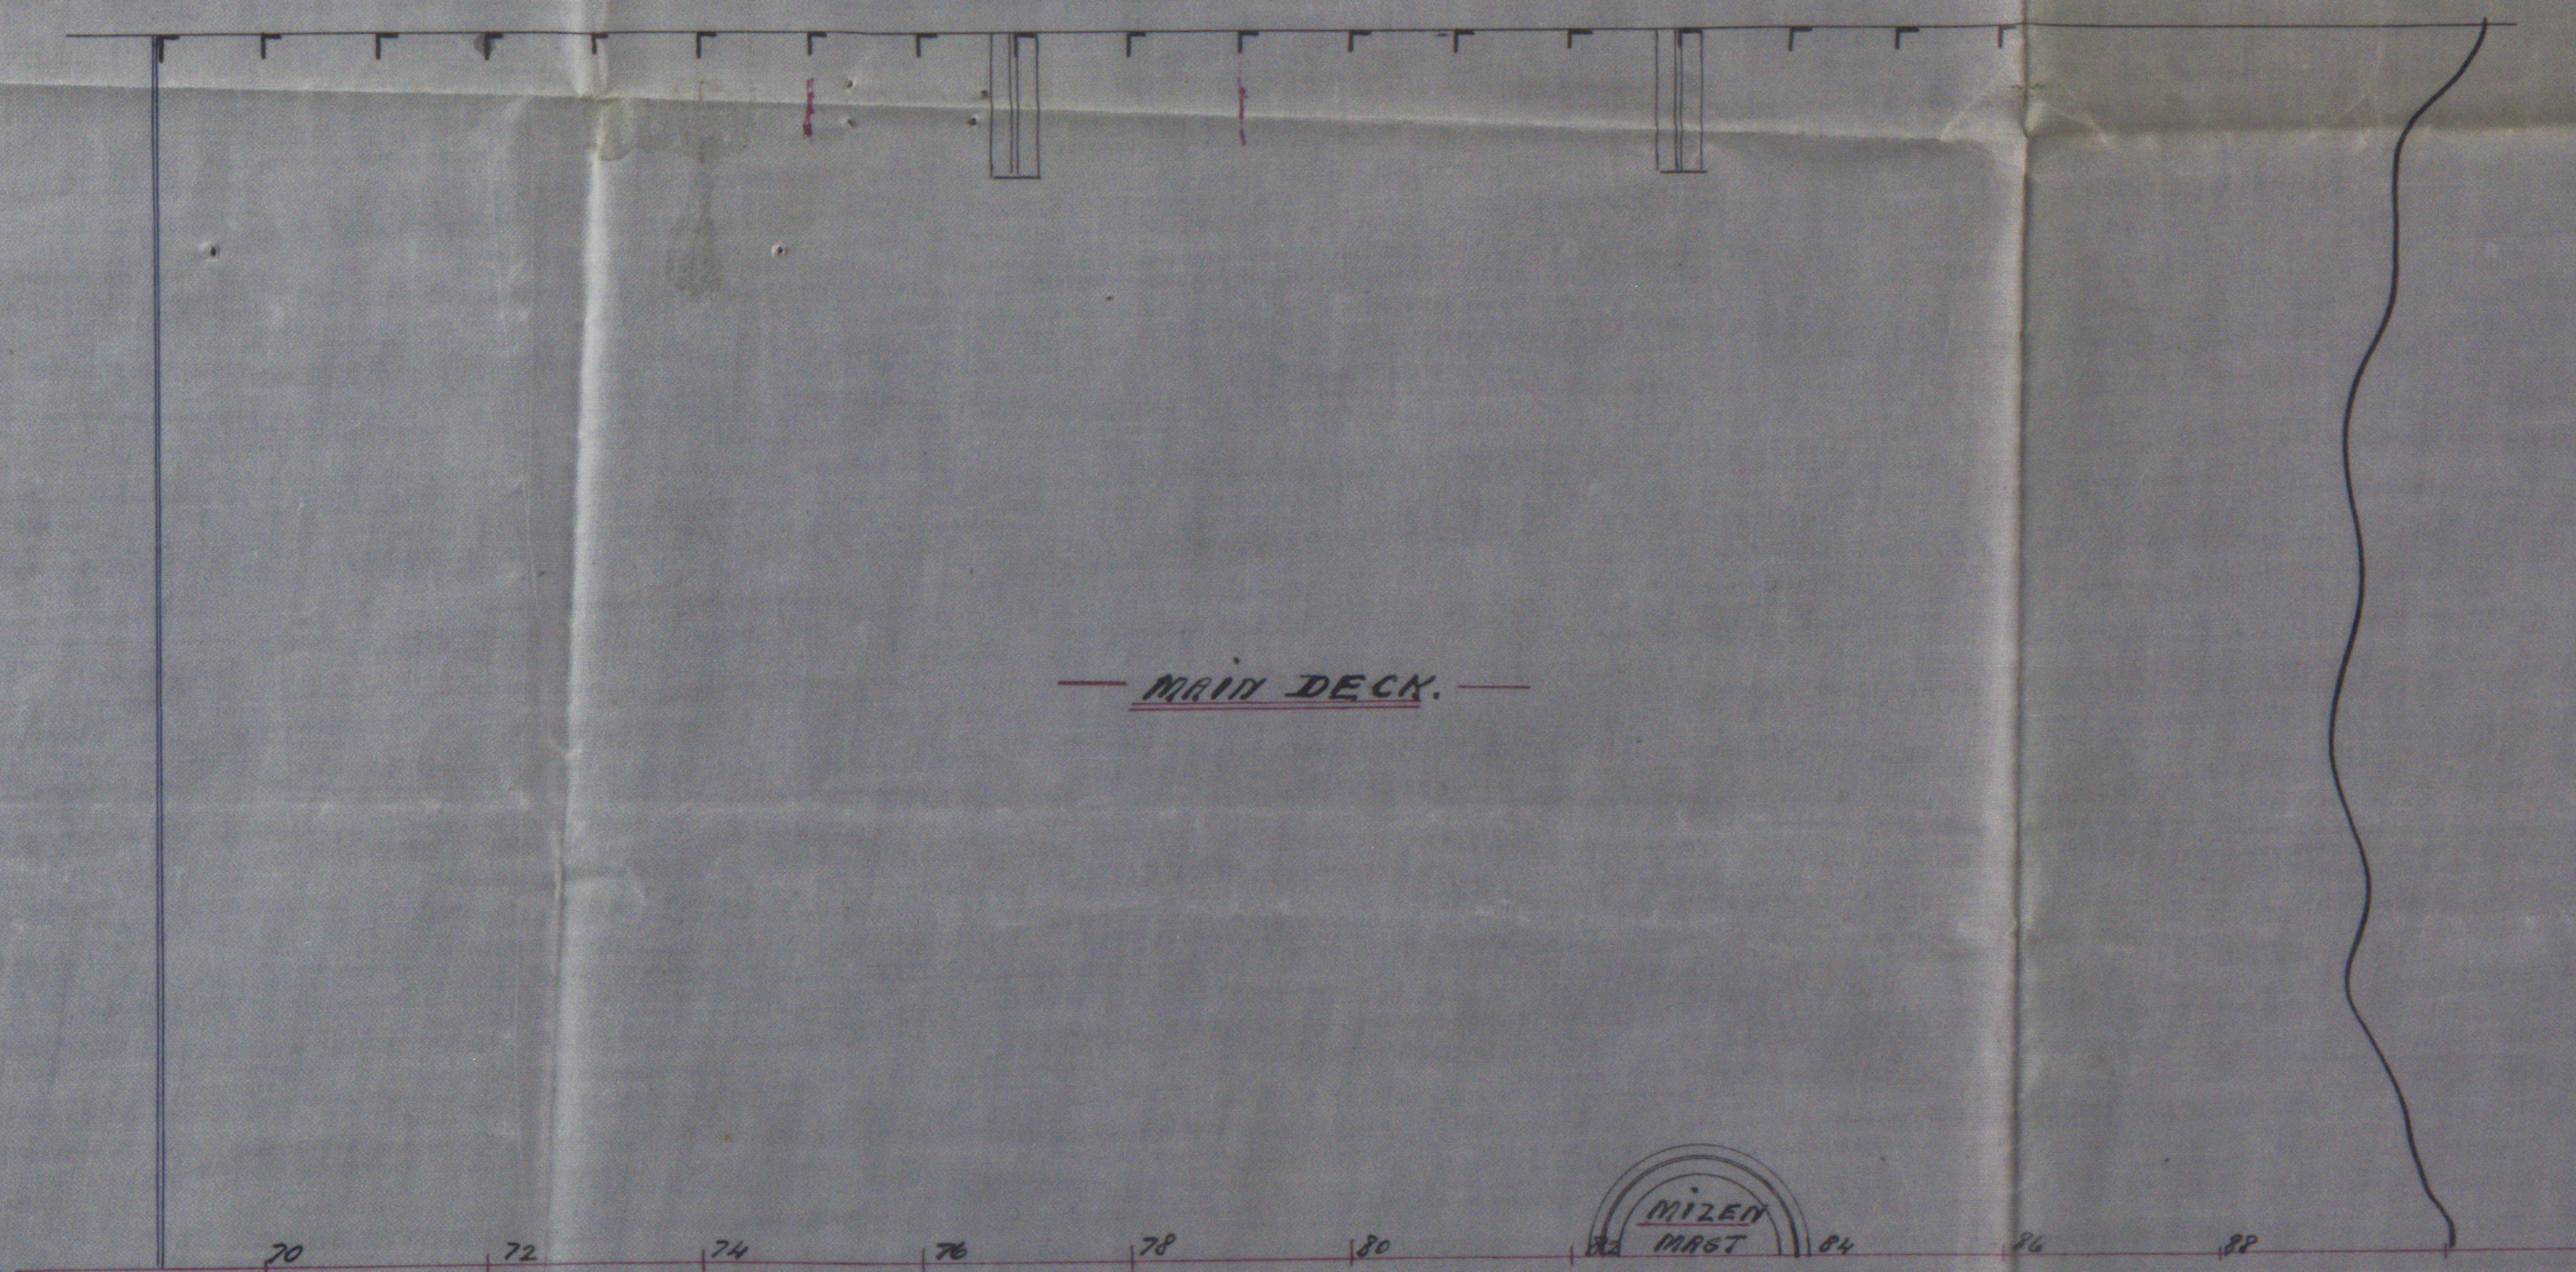


— MAIN DECK —

— DECK PLAN —
— SCALE 1/2 INCH = 1 FT. —

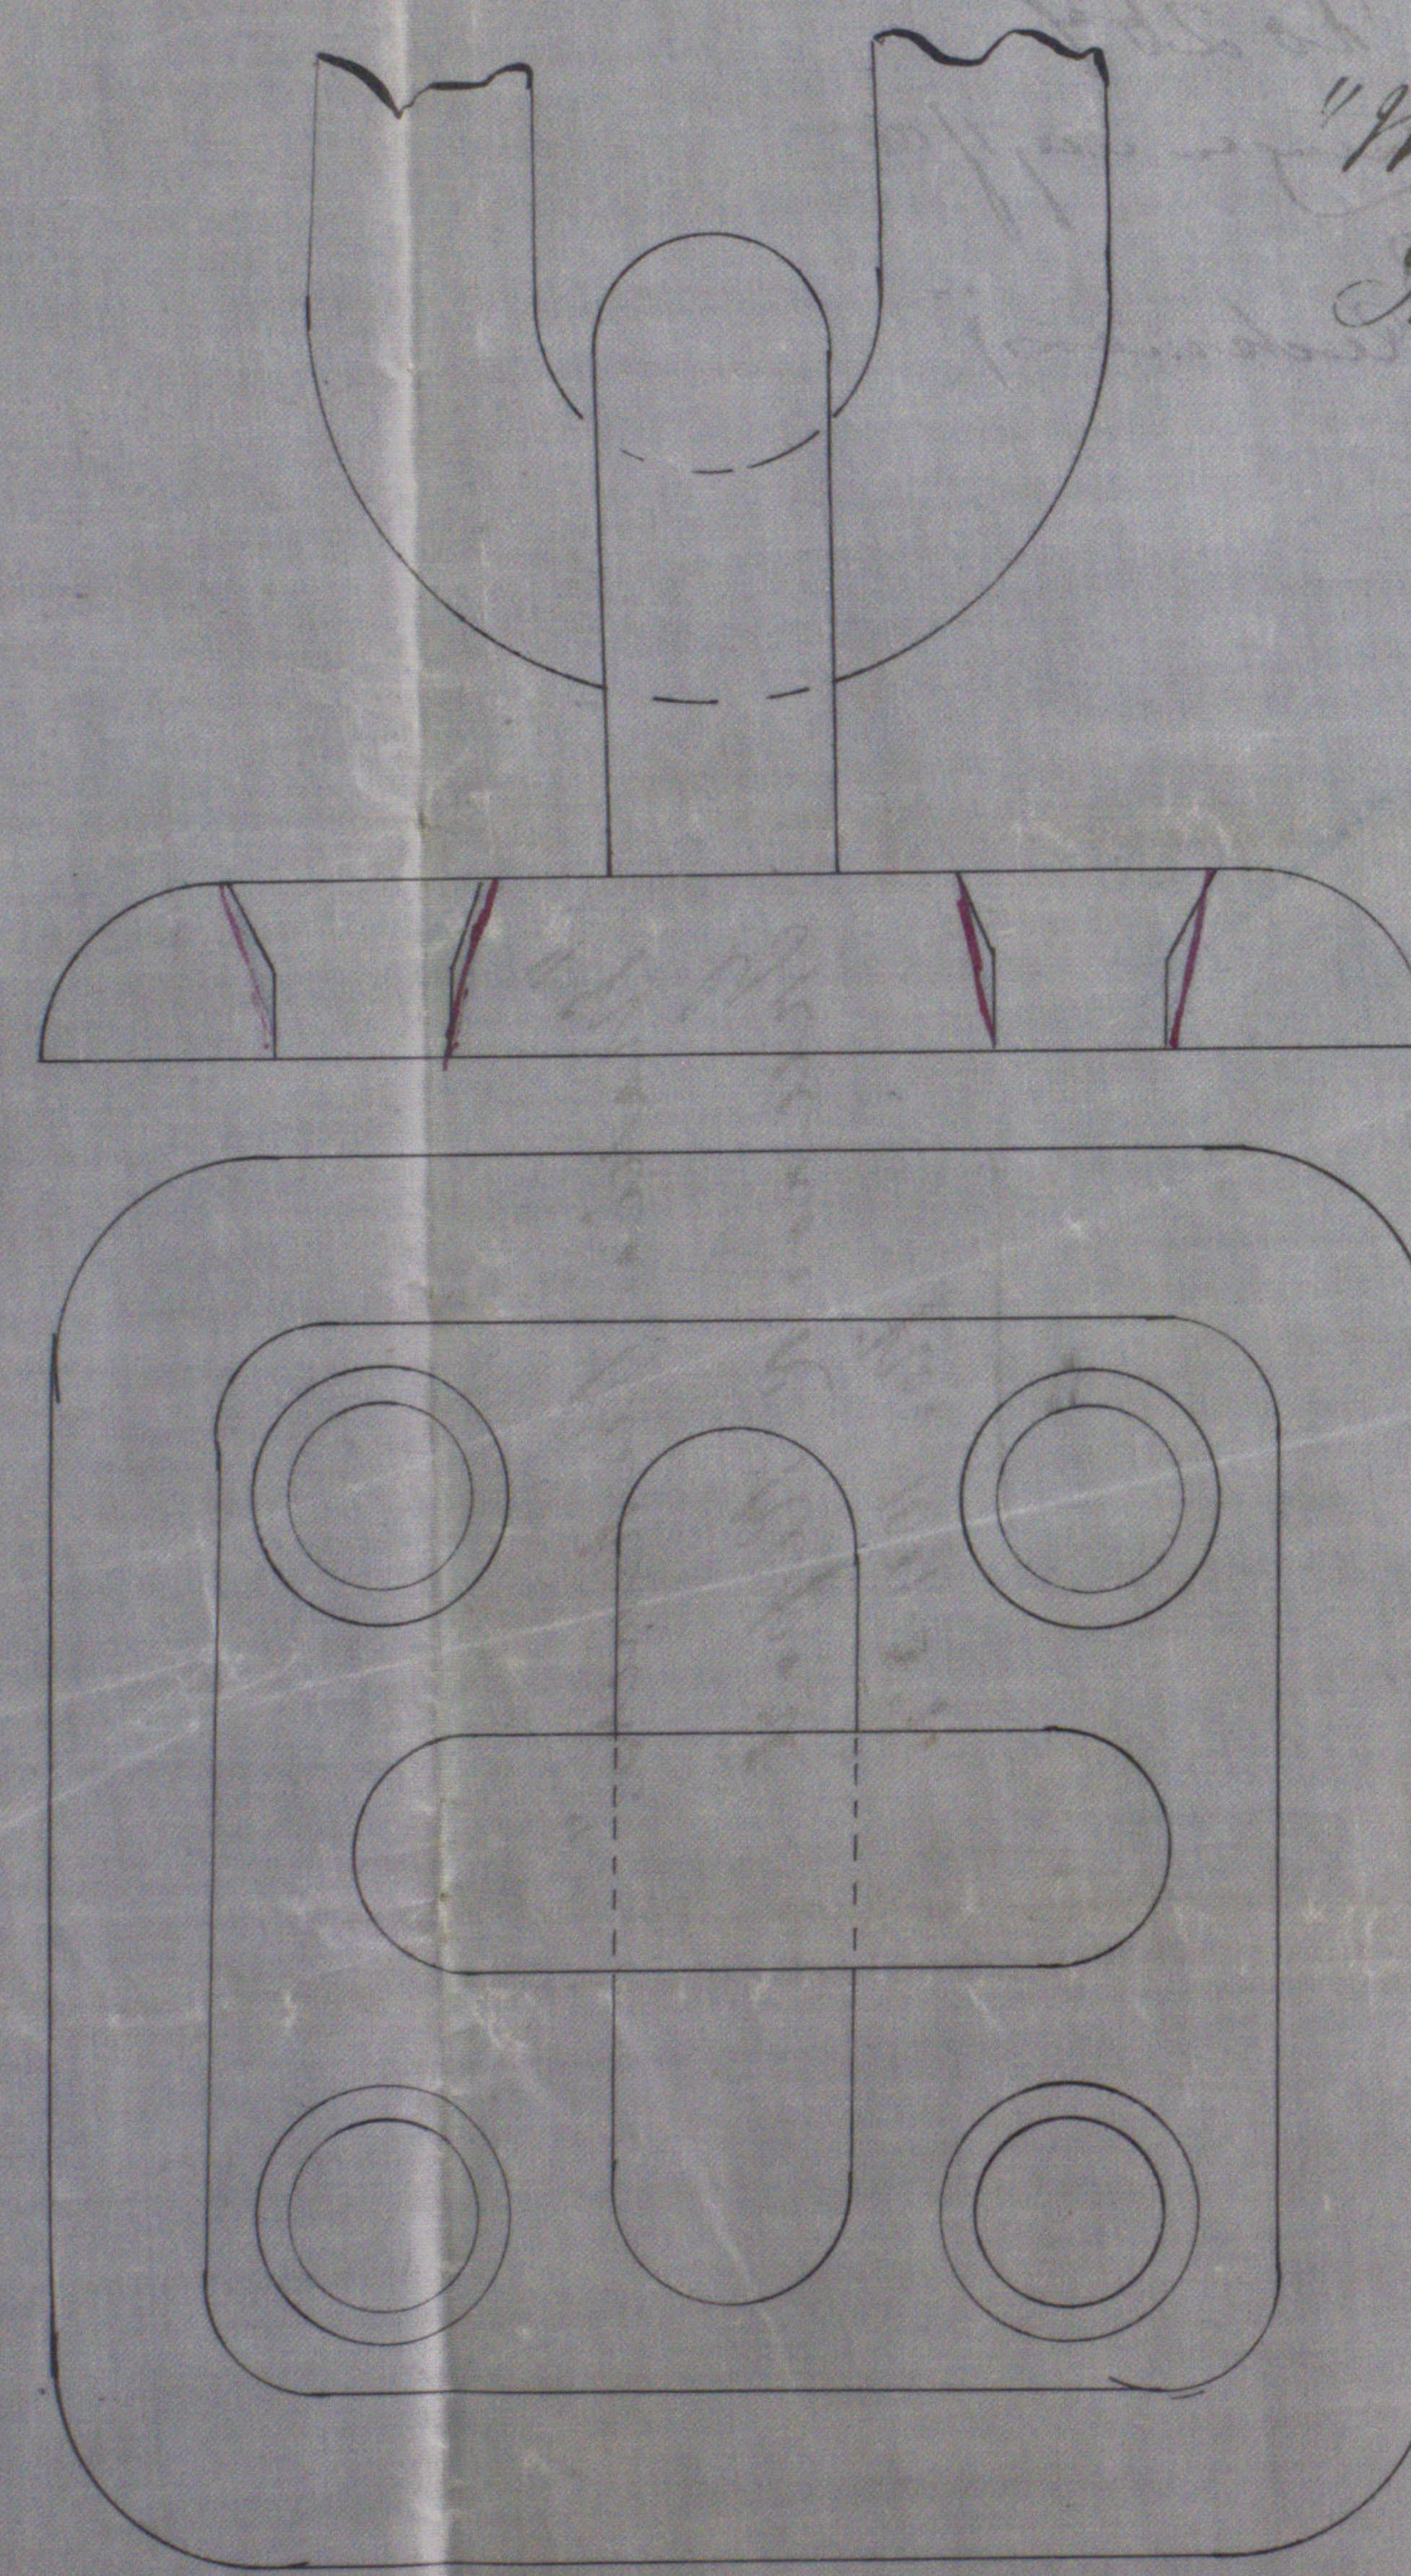

— SKETCH OF CHAIN PLATE —
— HALF SIZE —

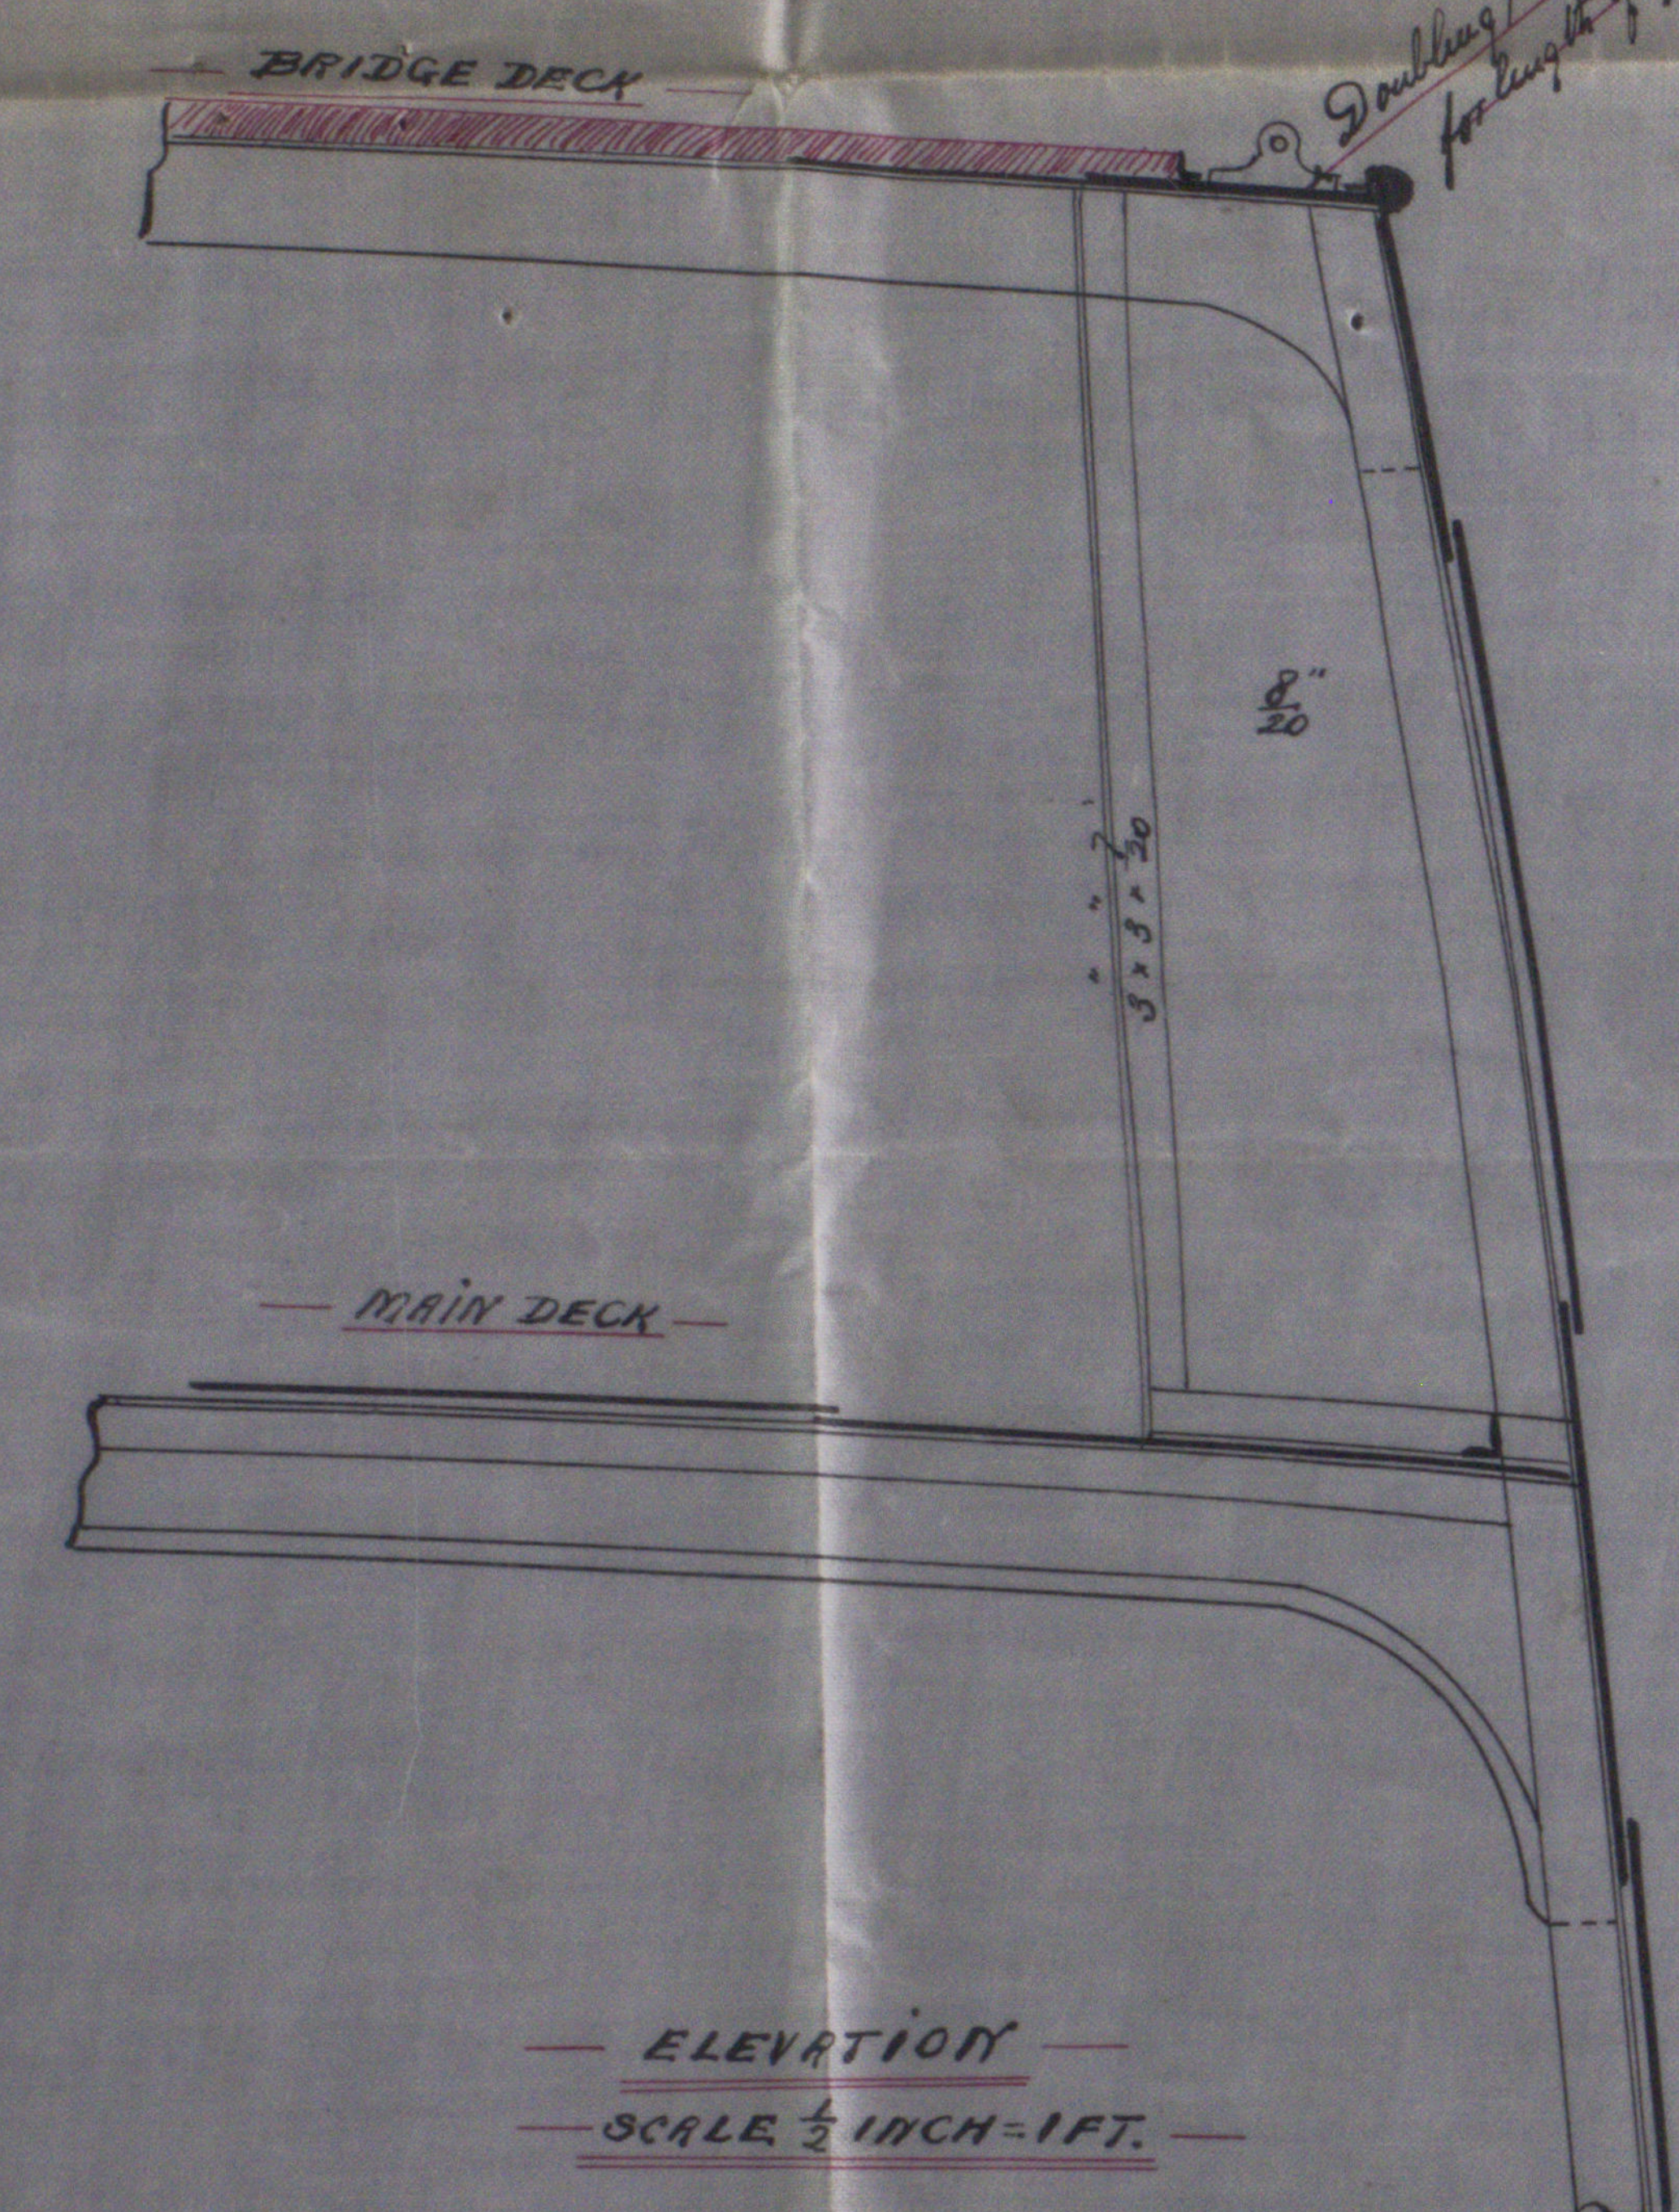

— ELEVATION —
— SCALE 1/2 INCH = 1 FT. —

"Maria Rickmers".
Greenock Report
No. 10457.


9/11/91
15/91
GRN 319-0207

Manila No 264

Sketch of stiffening way for
man rigging
(Manila Ruckmets)



"Manila Ruckmets."
Greenock No. 104-57.

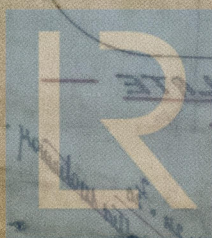

© 2019

Lloyd's Register
Foundation
GRK319-0207