
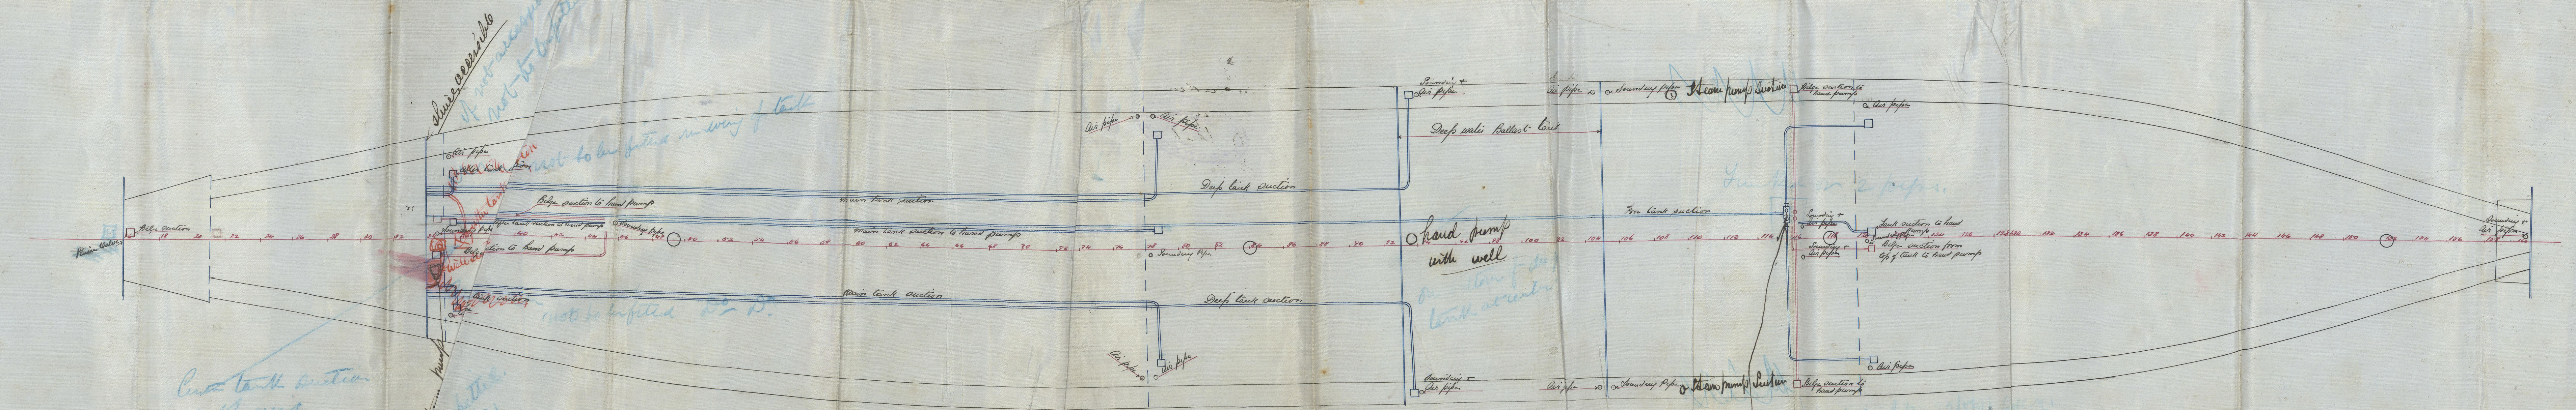


Ltr 16.5.91  
 22.5.91  
 29.5.91

"Maria Rickmers."  
 Greenock Report No. 10457.

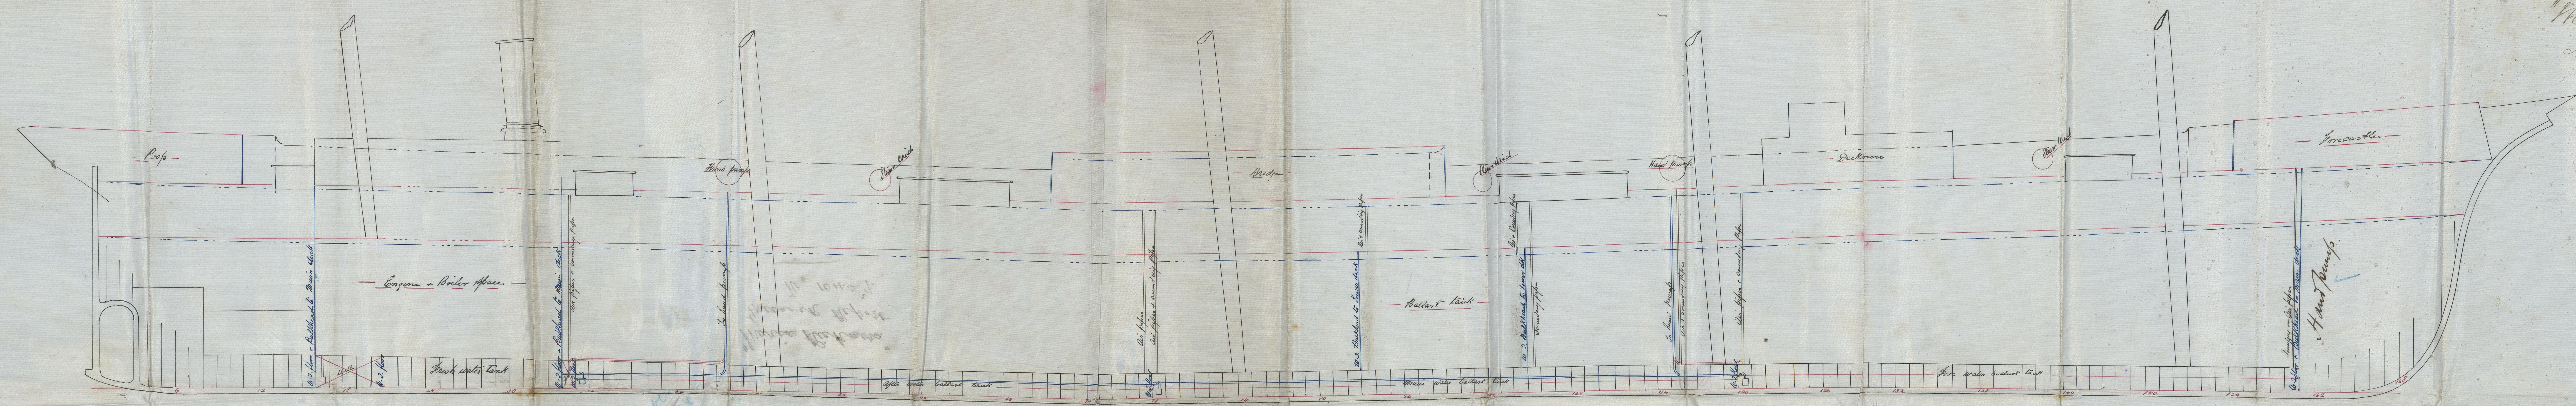

Pumping Arrangement  
 R. & W. 267  
 Scale 3 inch = one foot.

J. J. M.  
 16/5/91

Cross tank section  
 sufficient.

Air pipes  
 not to be put in wing of tank  
 not to be put in tank

not to be put in tank

M.A.  
 16.5.91  
 29.5.91

These valves to be always available

16/5/91