

"Maria Riekme" 18

Received at

Office

Lloyd's Register of British and Foreign Shipping.

(Report on Vessel No. 10457 Port Greenock.)

No. 2982 SHIP FORGINGS OR CASTINGS.

I have to report that the undermentioned Iron ~~or Steel~~ Forgings ~~or Castings~~, manufactured by The Portland Forge Coy of Kilmarnock for the Vessel No. 267, being built by Messrs Russell & Coy of Port Glasgow have been inspected by me as set forth below, and found to be, so far as can be seen, Sound & efficient

The words FORGINGS or CASTINGS, IRON or STEEL, should be struck out as may be required.


Mark on Forgings.

Lloyd's
No. 2982
W.H.

William Hamilton
Glasgow
7/4/91

	STERN FRAME.	RUDDER FRAME.	STEM.
Material*	Scrap iron	/	Scrap iron
How made	Forged		Forged
Dimensions	11 x 4 1/2		11 x 3
Progress on Inspection	Forging & smithing		Forging
Dates when Inspected	{ 31/12/90. 9. 14/1/91. 10. 16. 13 17/2/91. 4. 6. 10. 18. 19. 25. 27 21/3/91 2. 16/4/91		

SKETCHES OF FRAMES SHEWING POSITION AND DESCRIPTION OF WELDS OF FORGINGS, OR PARTICULARS OF TESTS APPLIED TO CASTINGS.

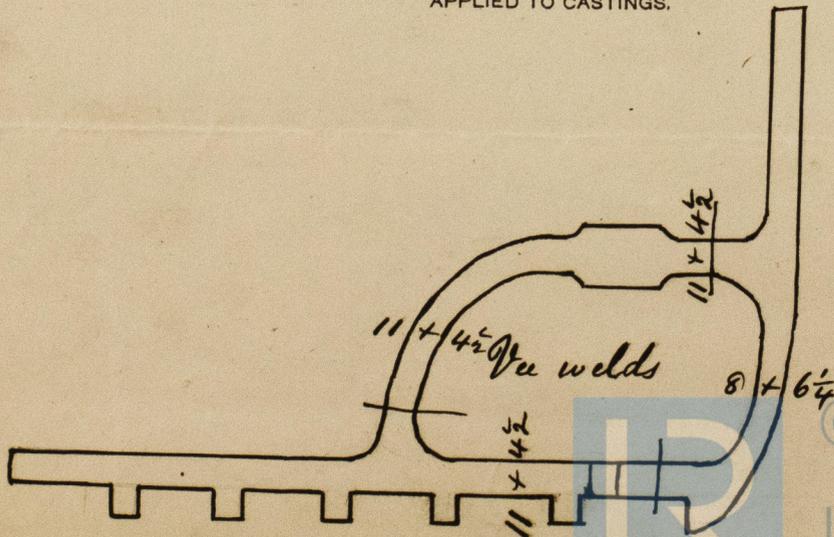

* If of Iron, state whether scrap or puddled Iron.