

*Marica Rick*

Received at

Office

# Lloyd's Register of British and Foreign Shipping.

(Report on Vessel No. *10457* Port *Greenock.*)

The words FORGINGS or CASTINGS, IRON or STEEL, should be struck out as may be required.

## No. *2982* SHIP FORGINGS ~~OR CASTINGS.~~

I have to report that the undermentioned Iron or ~~Steel~~ Forgings or Castings, manufactured by *The Portland Forge Coy* of *Kilmarnock* for the Vessel No. *267*, being built by *Messrs Russell & Coy* of *Port Glasgow* have been inspected by me as set forth below, and found to be, so far as can be seen, *Sound & efficient*

Mark on Forgings.


Lloyd's  
No. *2982*  
*W. H.*

*William Hamilton*

*Glasgow*  
*3/12/91*

	STERN FRAME.	RUDDER FRAME.	STEM.
Material* . . . . .	/	<i>Scrap iron</i>	/
How made . . . . .		<i>Forged</i>	
Dimensions . . . . .		<i>9 to 4 1/2</i>	
Progress on Inspection . . . . .		<i>Forging &amp; smithing</i>	
Dates when Inspected		<i>9.11.91. 12.9.91. 1.5.91. 15.9.91 1.5.10.91. 13.17.23.26.30.11.91</i>	

SKETCHES OF FRAMES SHEWING POSITION AND DESCRIPTION OF WELDS OF FORGINGS, OR PARTICULARS OF TESTS APPLIED TO CASTINGS.

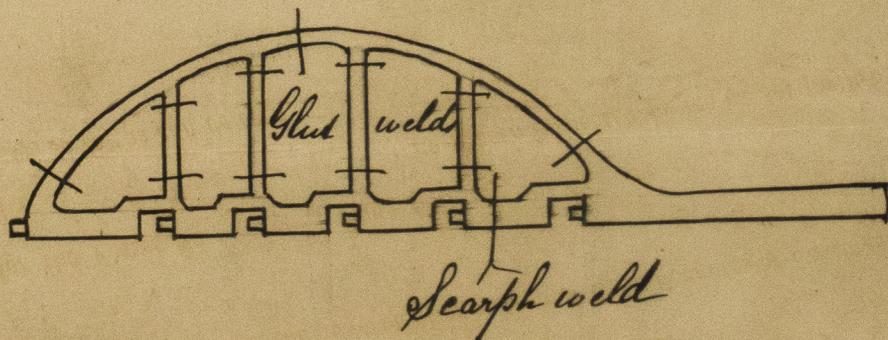

© 2019

Lloyd's Register

FORN319-0215

\* If of Iron, state whether scrap or puddled Iron.