


# Longitudinal Section & Deck Plan

N<sup>o</sup> 213 S.S.

Scale 1/8 inch = 1 foot


es Blue Bell  
Gen. Rep<sup>t</sup> No. 10587.

7.12.91.  
2.5.92

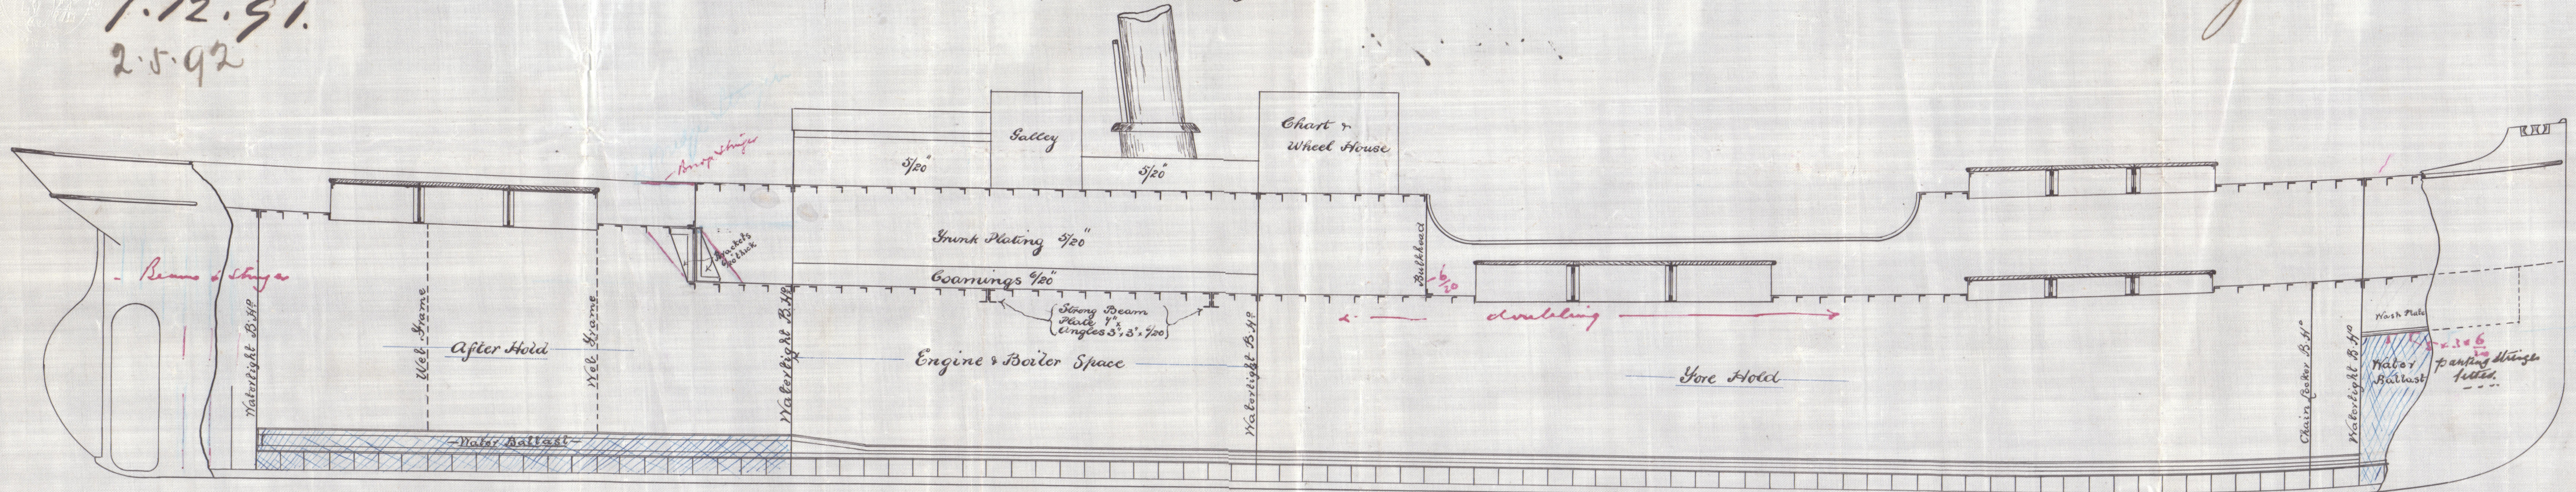

Bracket Plates 1/20 thick  
2 in way of each Hatch  
in lieu of Pillars  
carried down to side stringer

Steel Deck Plating 1/20 thick all fore & aft

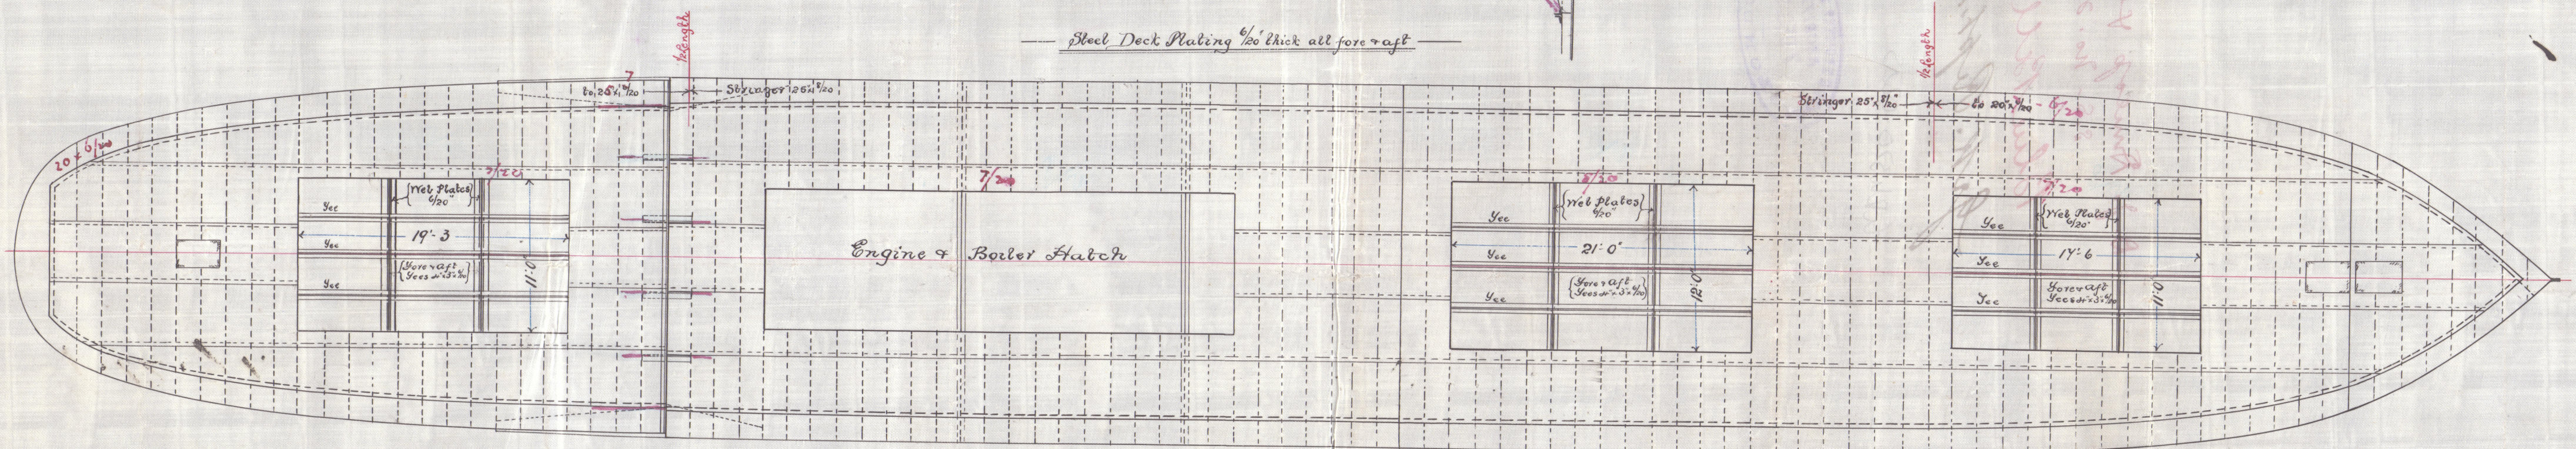

DAVID J. DUNLOP & CO.

ENGINEERS & SHIPBUILDERS

PORT CLASGOW



Lloyd's Register  
Foundation