


"Blue Bell"
Greenock Report No.

Quarter Deck = 42'-0"; Bridge = 52'-6"; Forecastle = 45'-6".

=class "100 A" at Lloyds

Scale $\frac{1}{2}$ " = 1 foot

¹⁴
 7. 12. 91.
 24. 3. 92.
 2. 5. 92

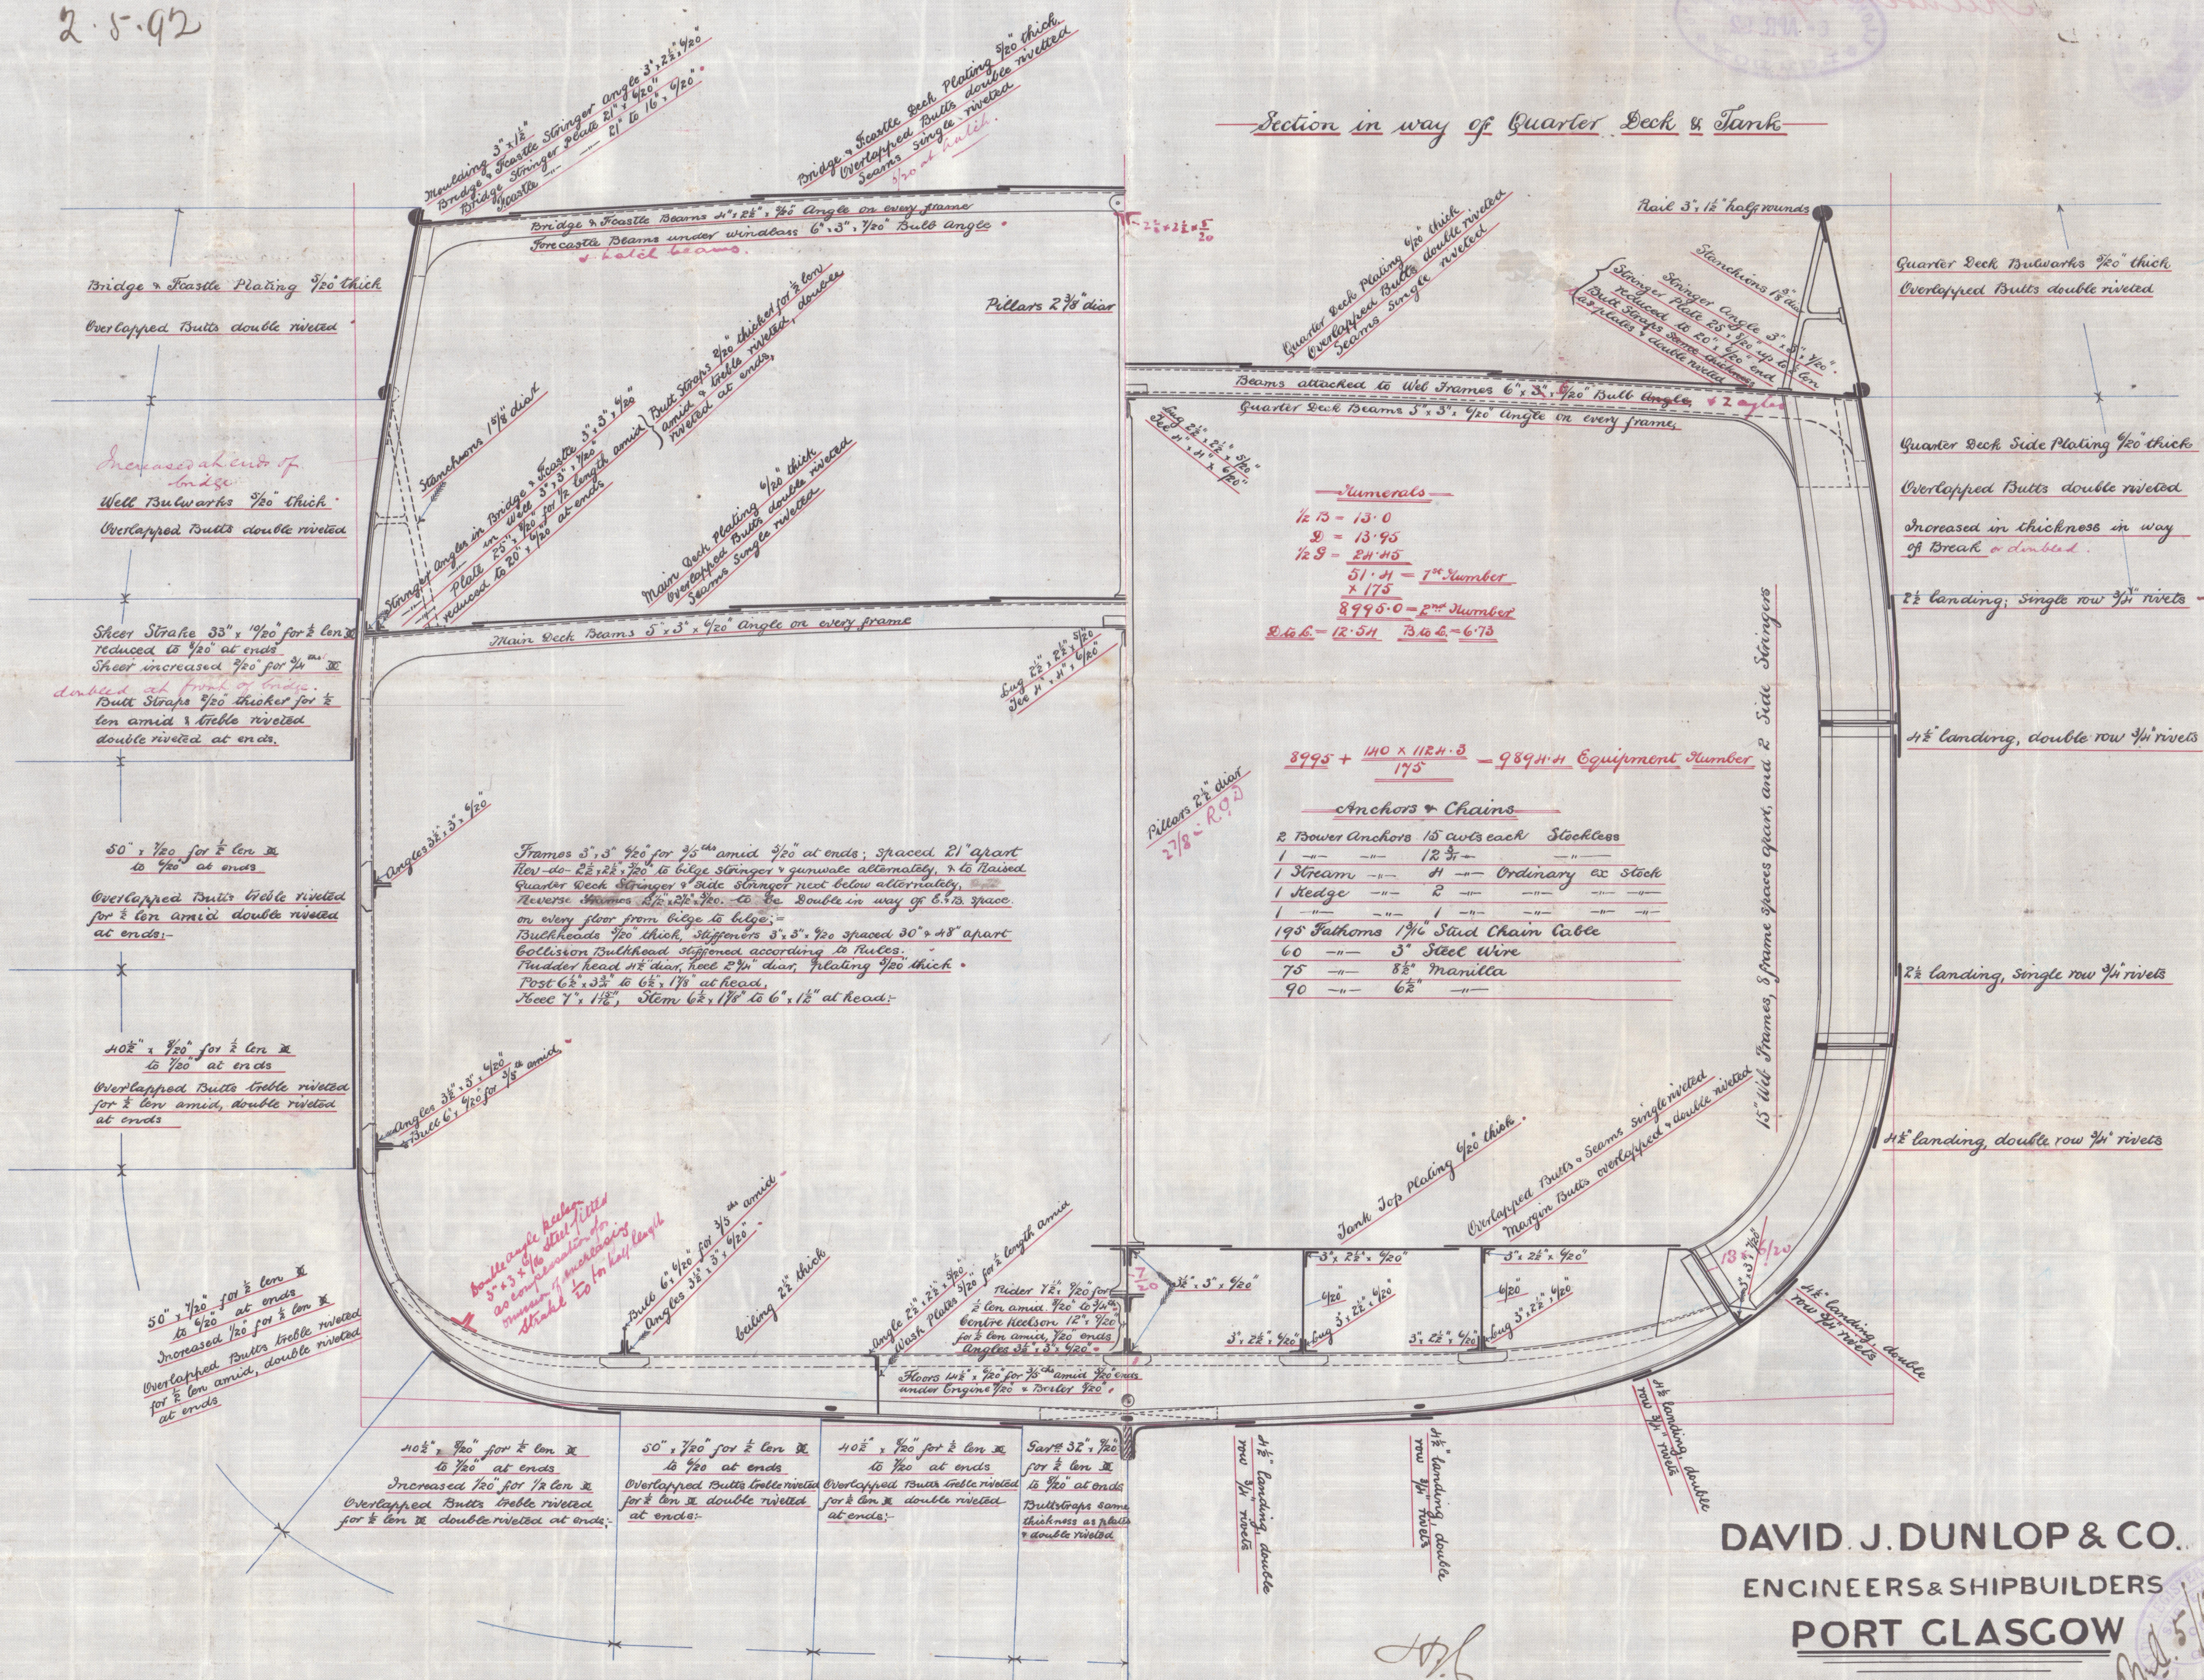

DAVID J. DUNLOP & CO.
ENGINEERS & SHIPBUILDERS
PORT GLASGOW

© 2021
Lloyd's Register
Foundation

S. S. No. 273.

D. H. Dunlop & Co's No. 212.

"Blue Bell."

Greenock Report No.

GRW320

6* APR 92

7780


© 2021


Lloyd's Register Foundation