


Arrangement of Cargo Hatches and Pillars in holds
 JV 213 S.S.

SHIP DRAWING OFFICE
 DAVID & DUNLAP & CO.
 100 WIND, PORT GLENN
 Sent out 28th April 1892

Drawn for the
 2nd way of each hatch on
 line of side pillars, carried
 down to one stringer.

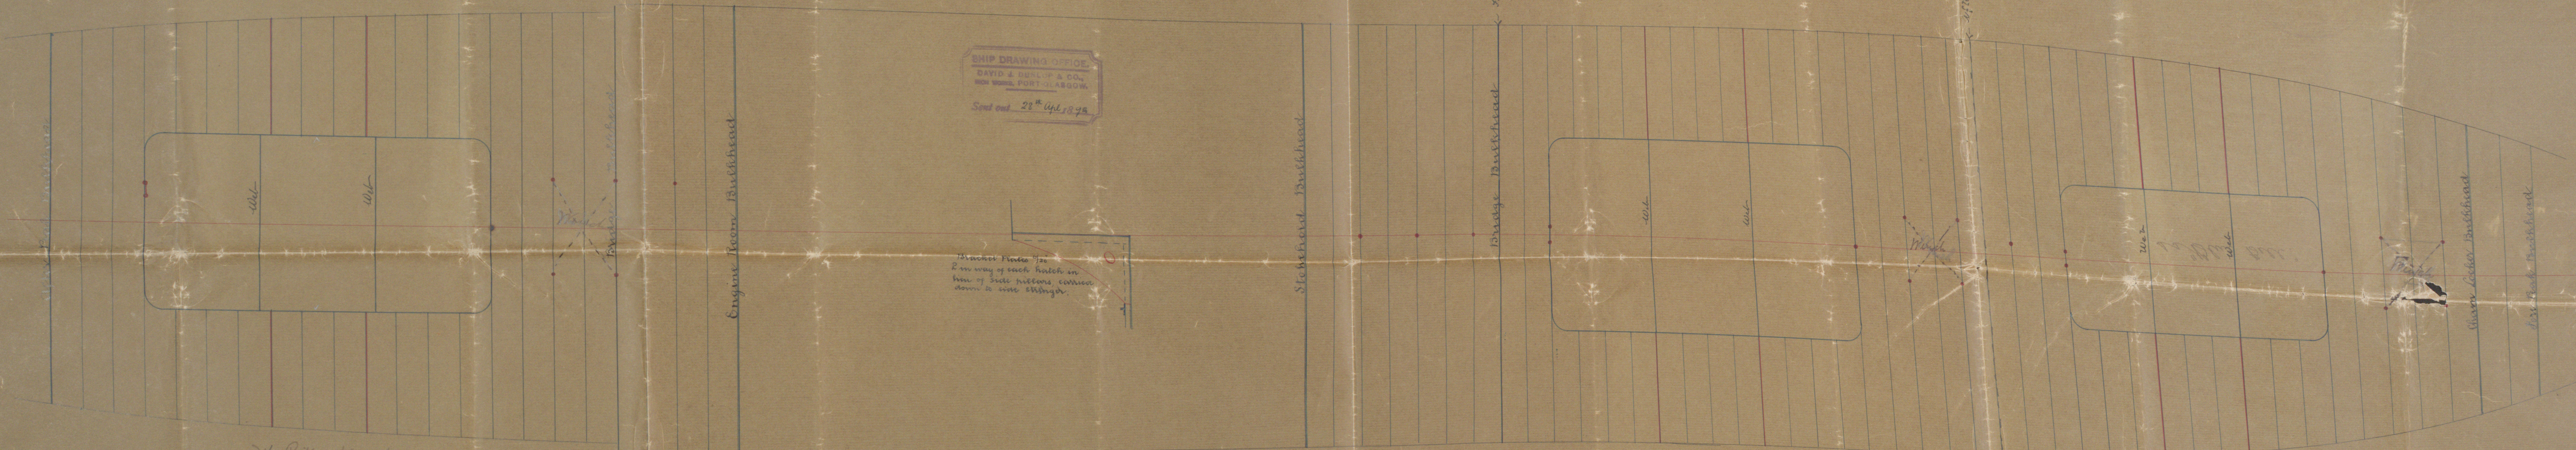

✓ Pillars fitted at corners
 of hatch 3 1/2" dia

✓ Pillars fitted at corners
 of hatch 2 1/2"

✓ Pillars fitted at corners of
 hatch 2 1/2"

18 Mc
 2/5/92

Blue Bell
 Greenock Report No. 10537
 S.S. "Blue Bell"

"Blue Bell"

Greenock Report No. 10537.

GRH 320-0229

West End 2.2

Greenock Report No. 10287.

Under observation in 1919 report

© 2021

Lloyd's Register
Foundation



"Blue Bell"