
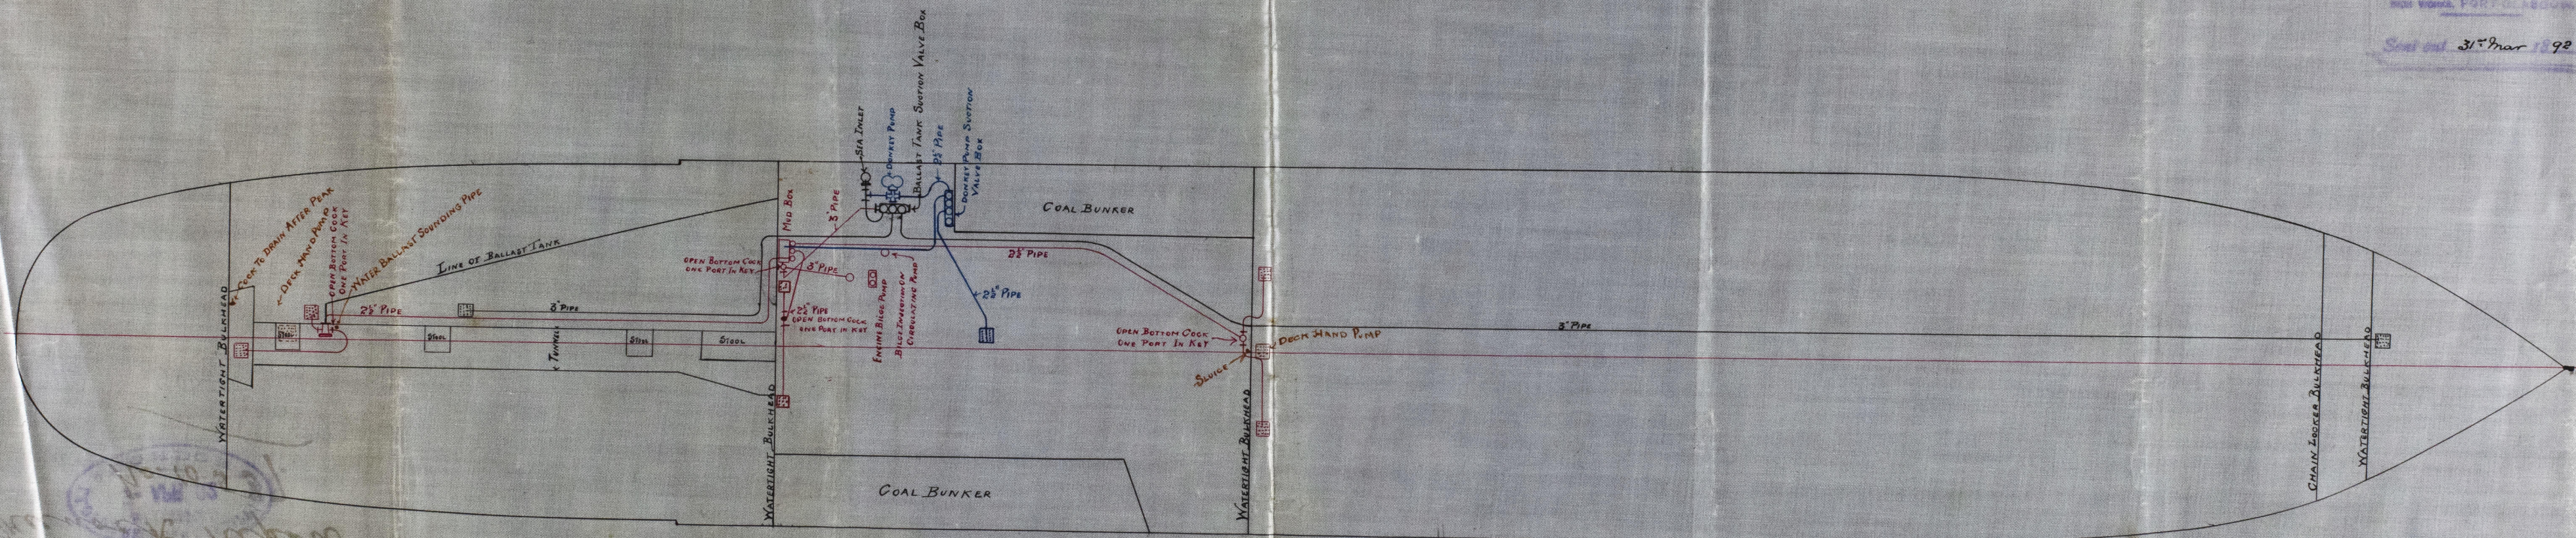


Dec. 94/92

ss. "Blue Bell."
Greenock Report No. 10537

PUMPING ARRANGEMENT OF N^o 213 S.S.

SCALE 1/8 INCH = 1 FOOT

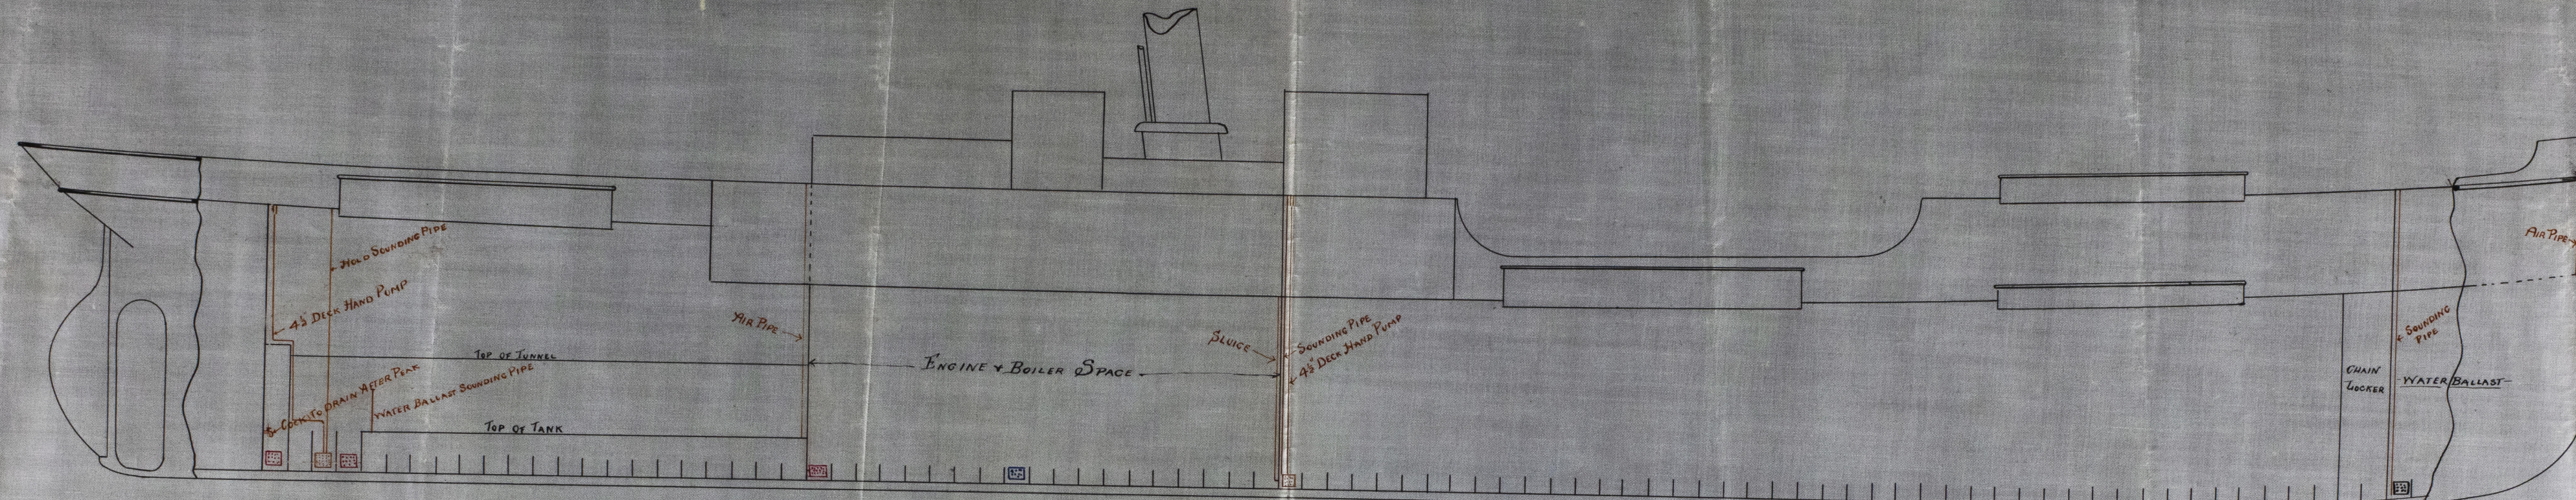

Sent out 31st March 1892


ENGINE PUMP SUCTIONS
DONKEY PUMP SUCTIONS
BALLAST SUCTIONS
DECK HAND PUMPS

N.A.
7.4.92

Lloyd's Register
Foundation

"Blue Bell:
Greenock Report
No. 10537.


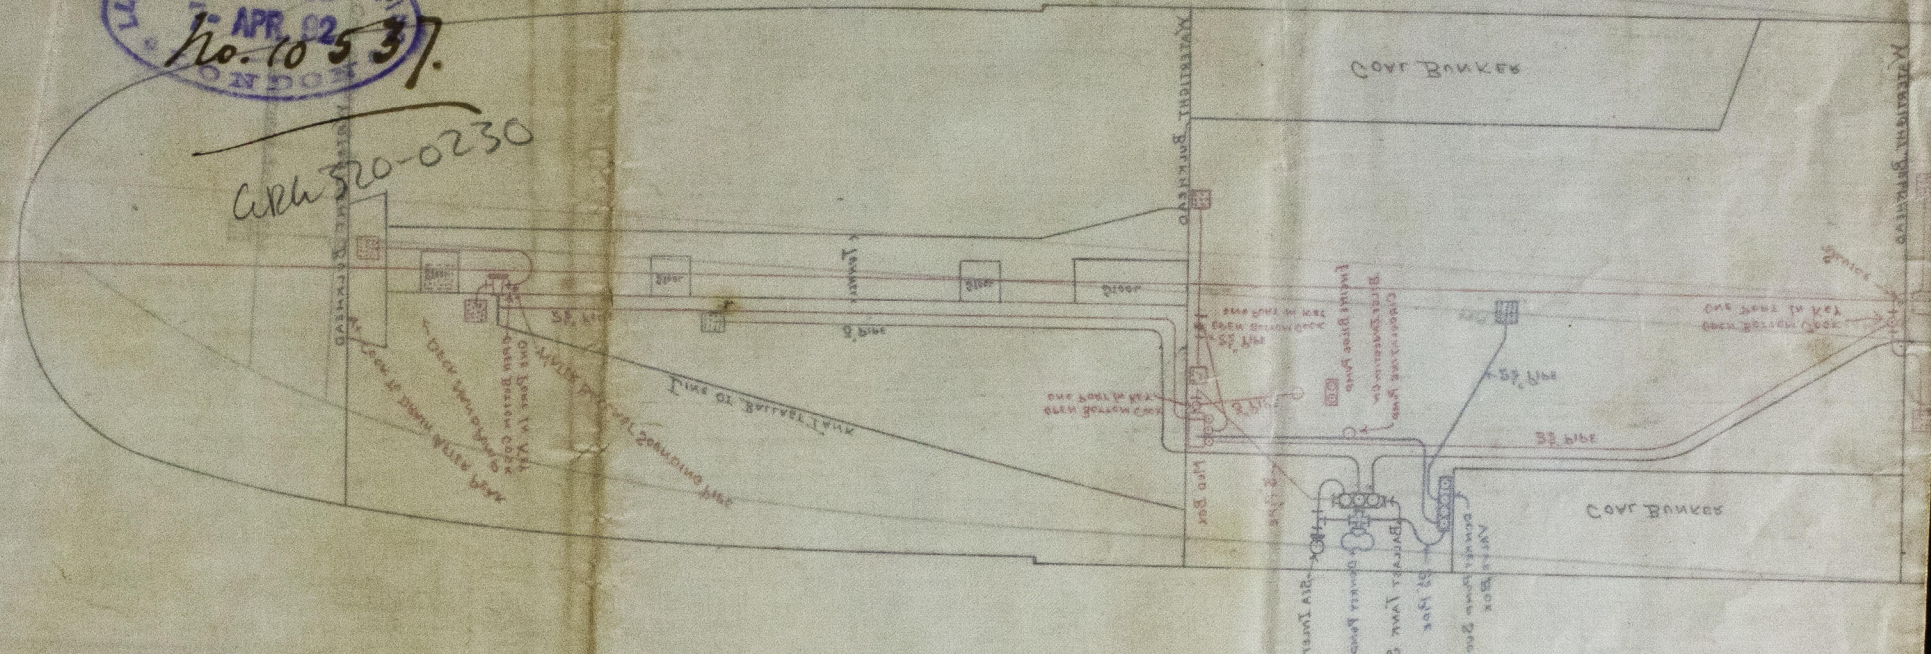

© 2019

Lloyd's Register
Foundation