
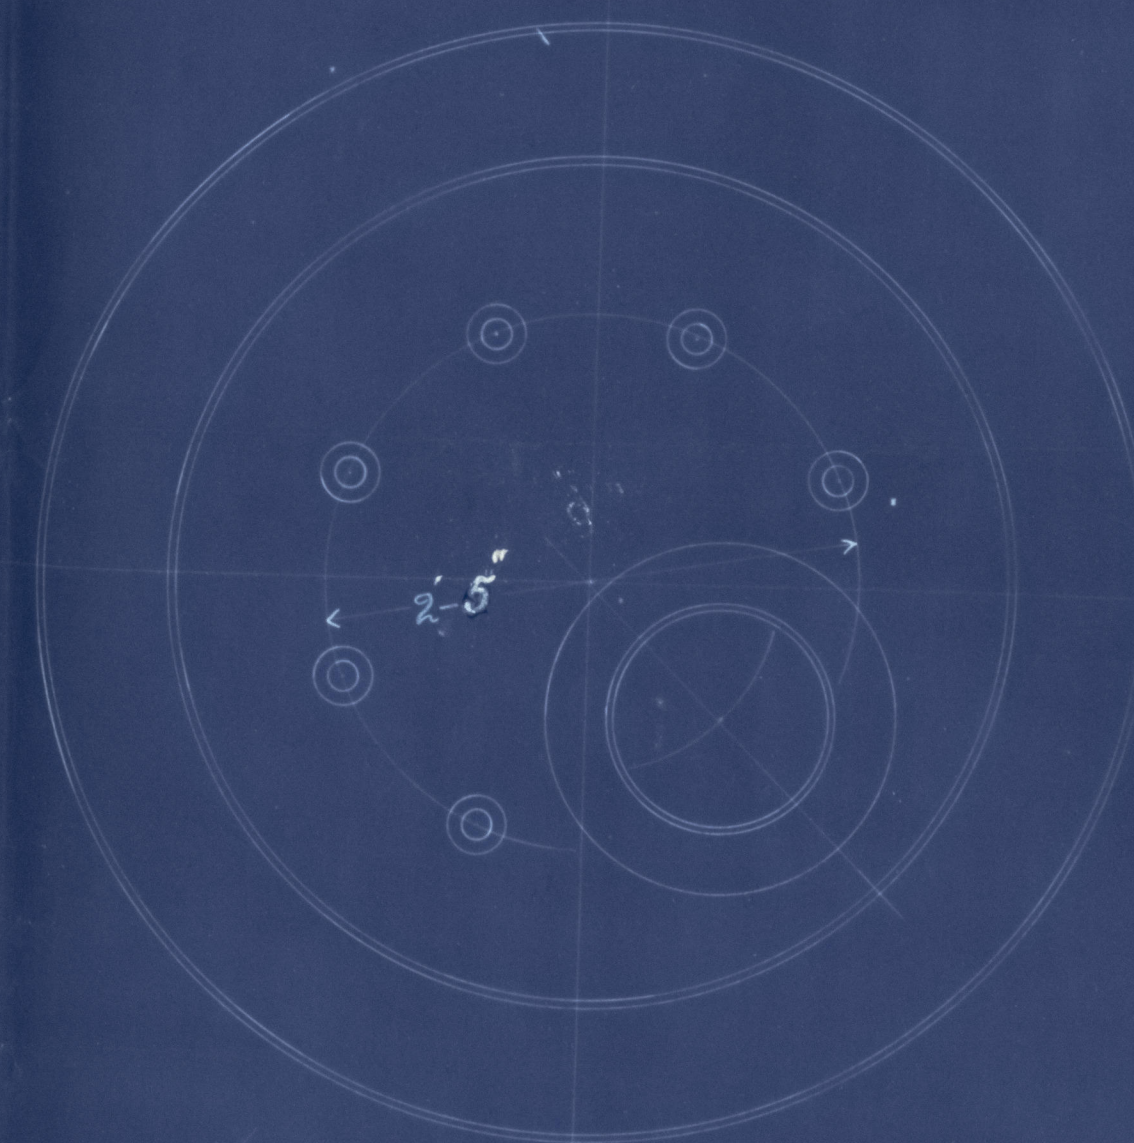
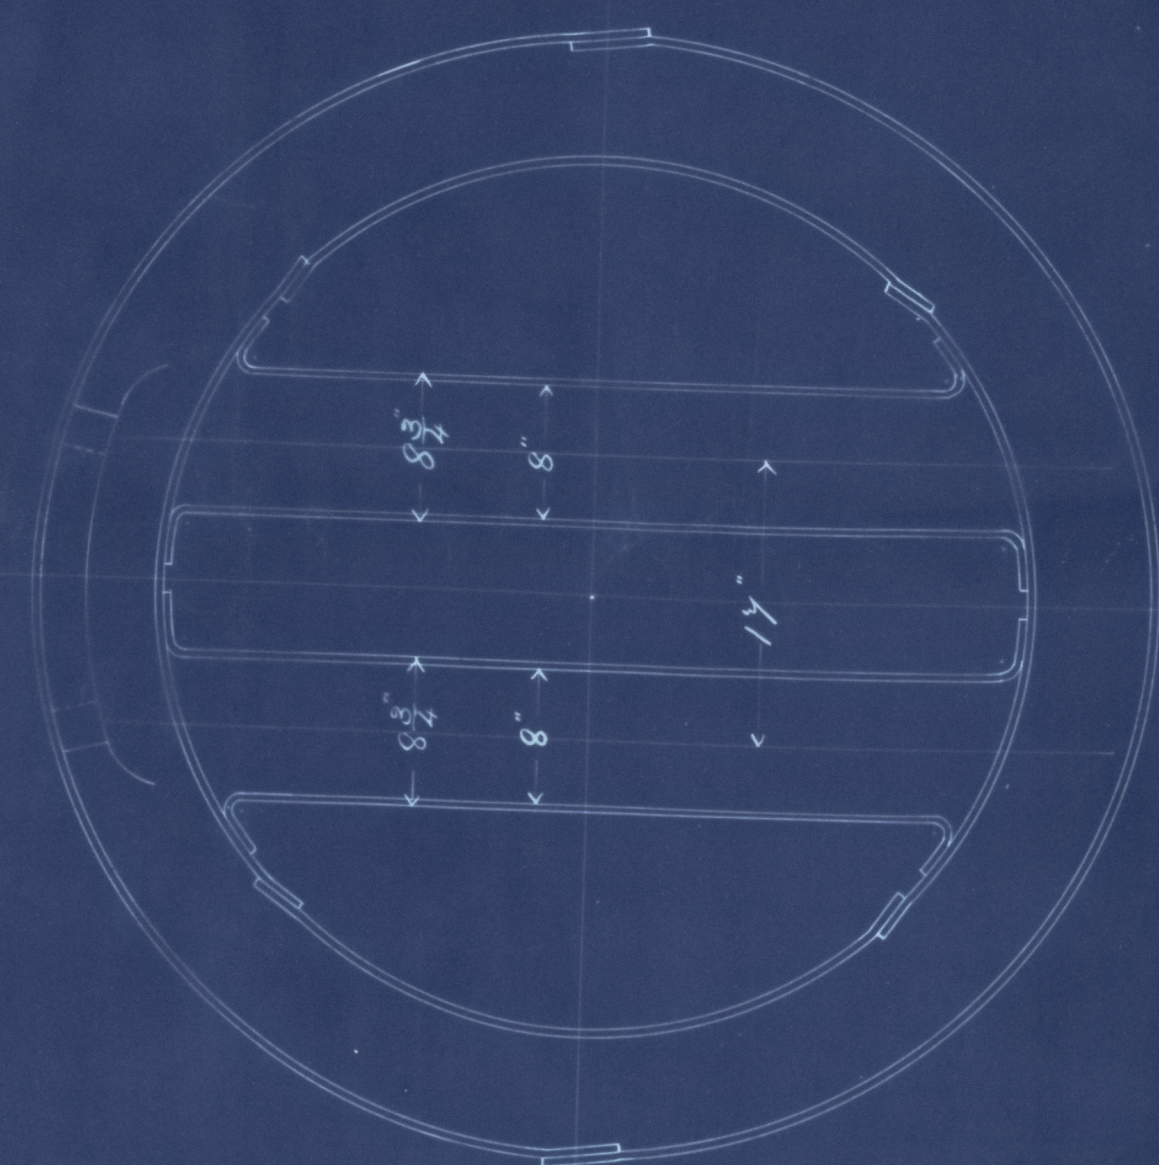
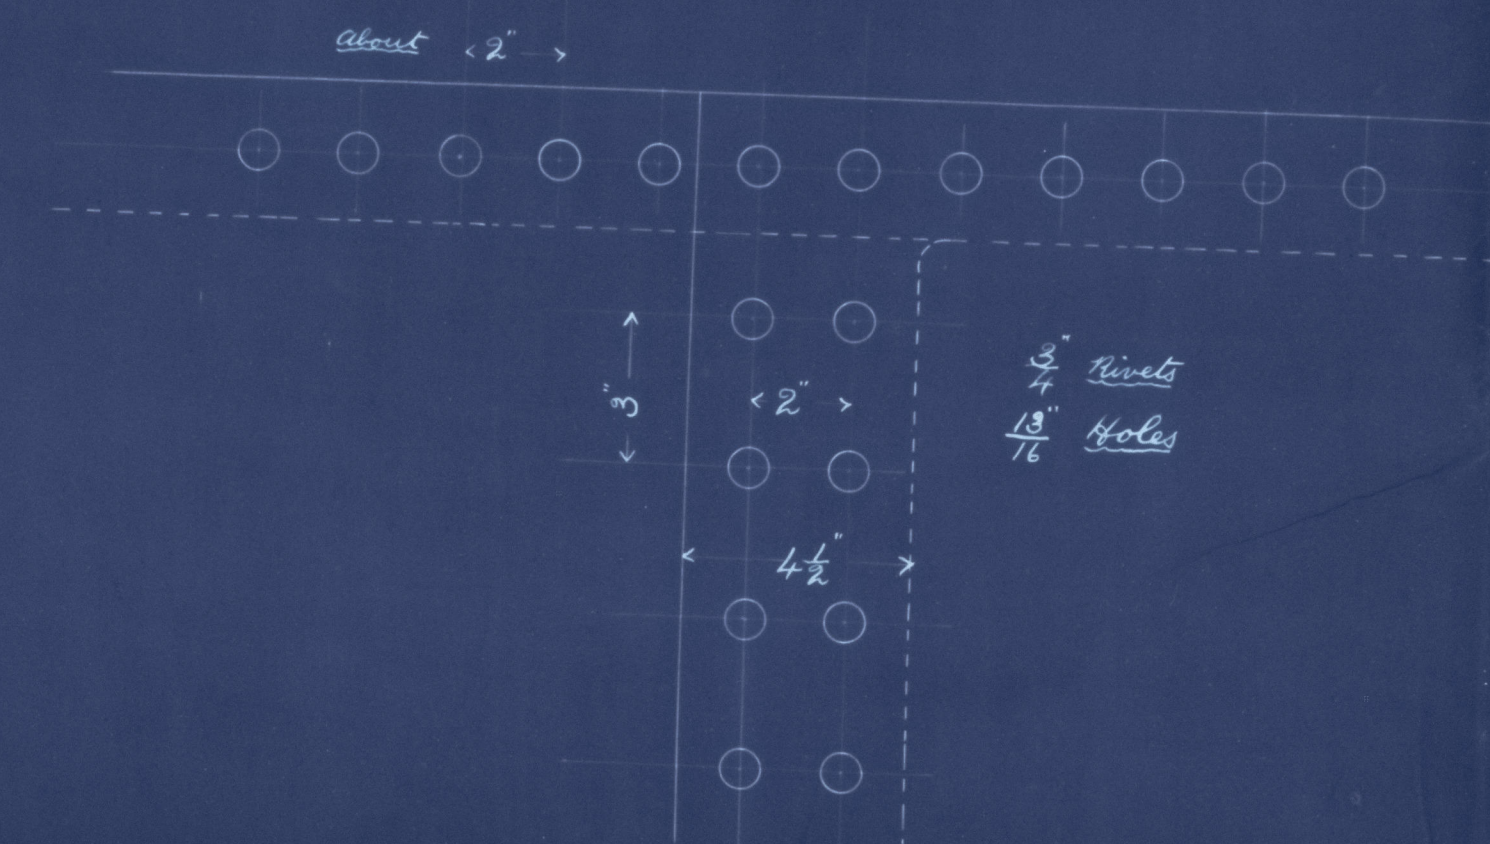


Dec 15 1922

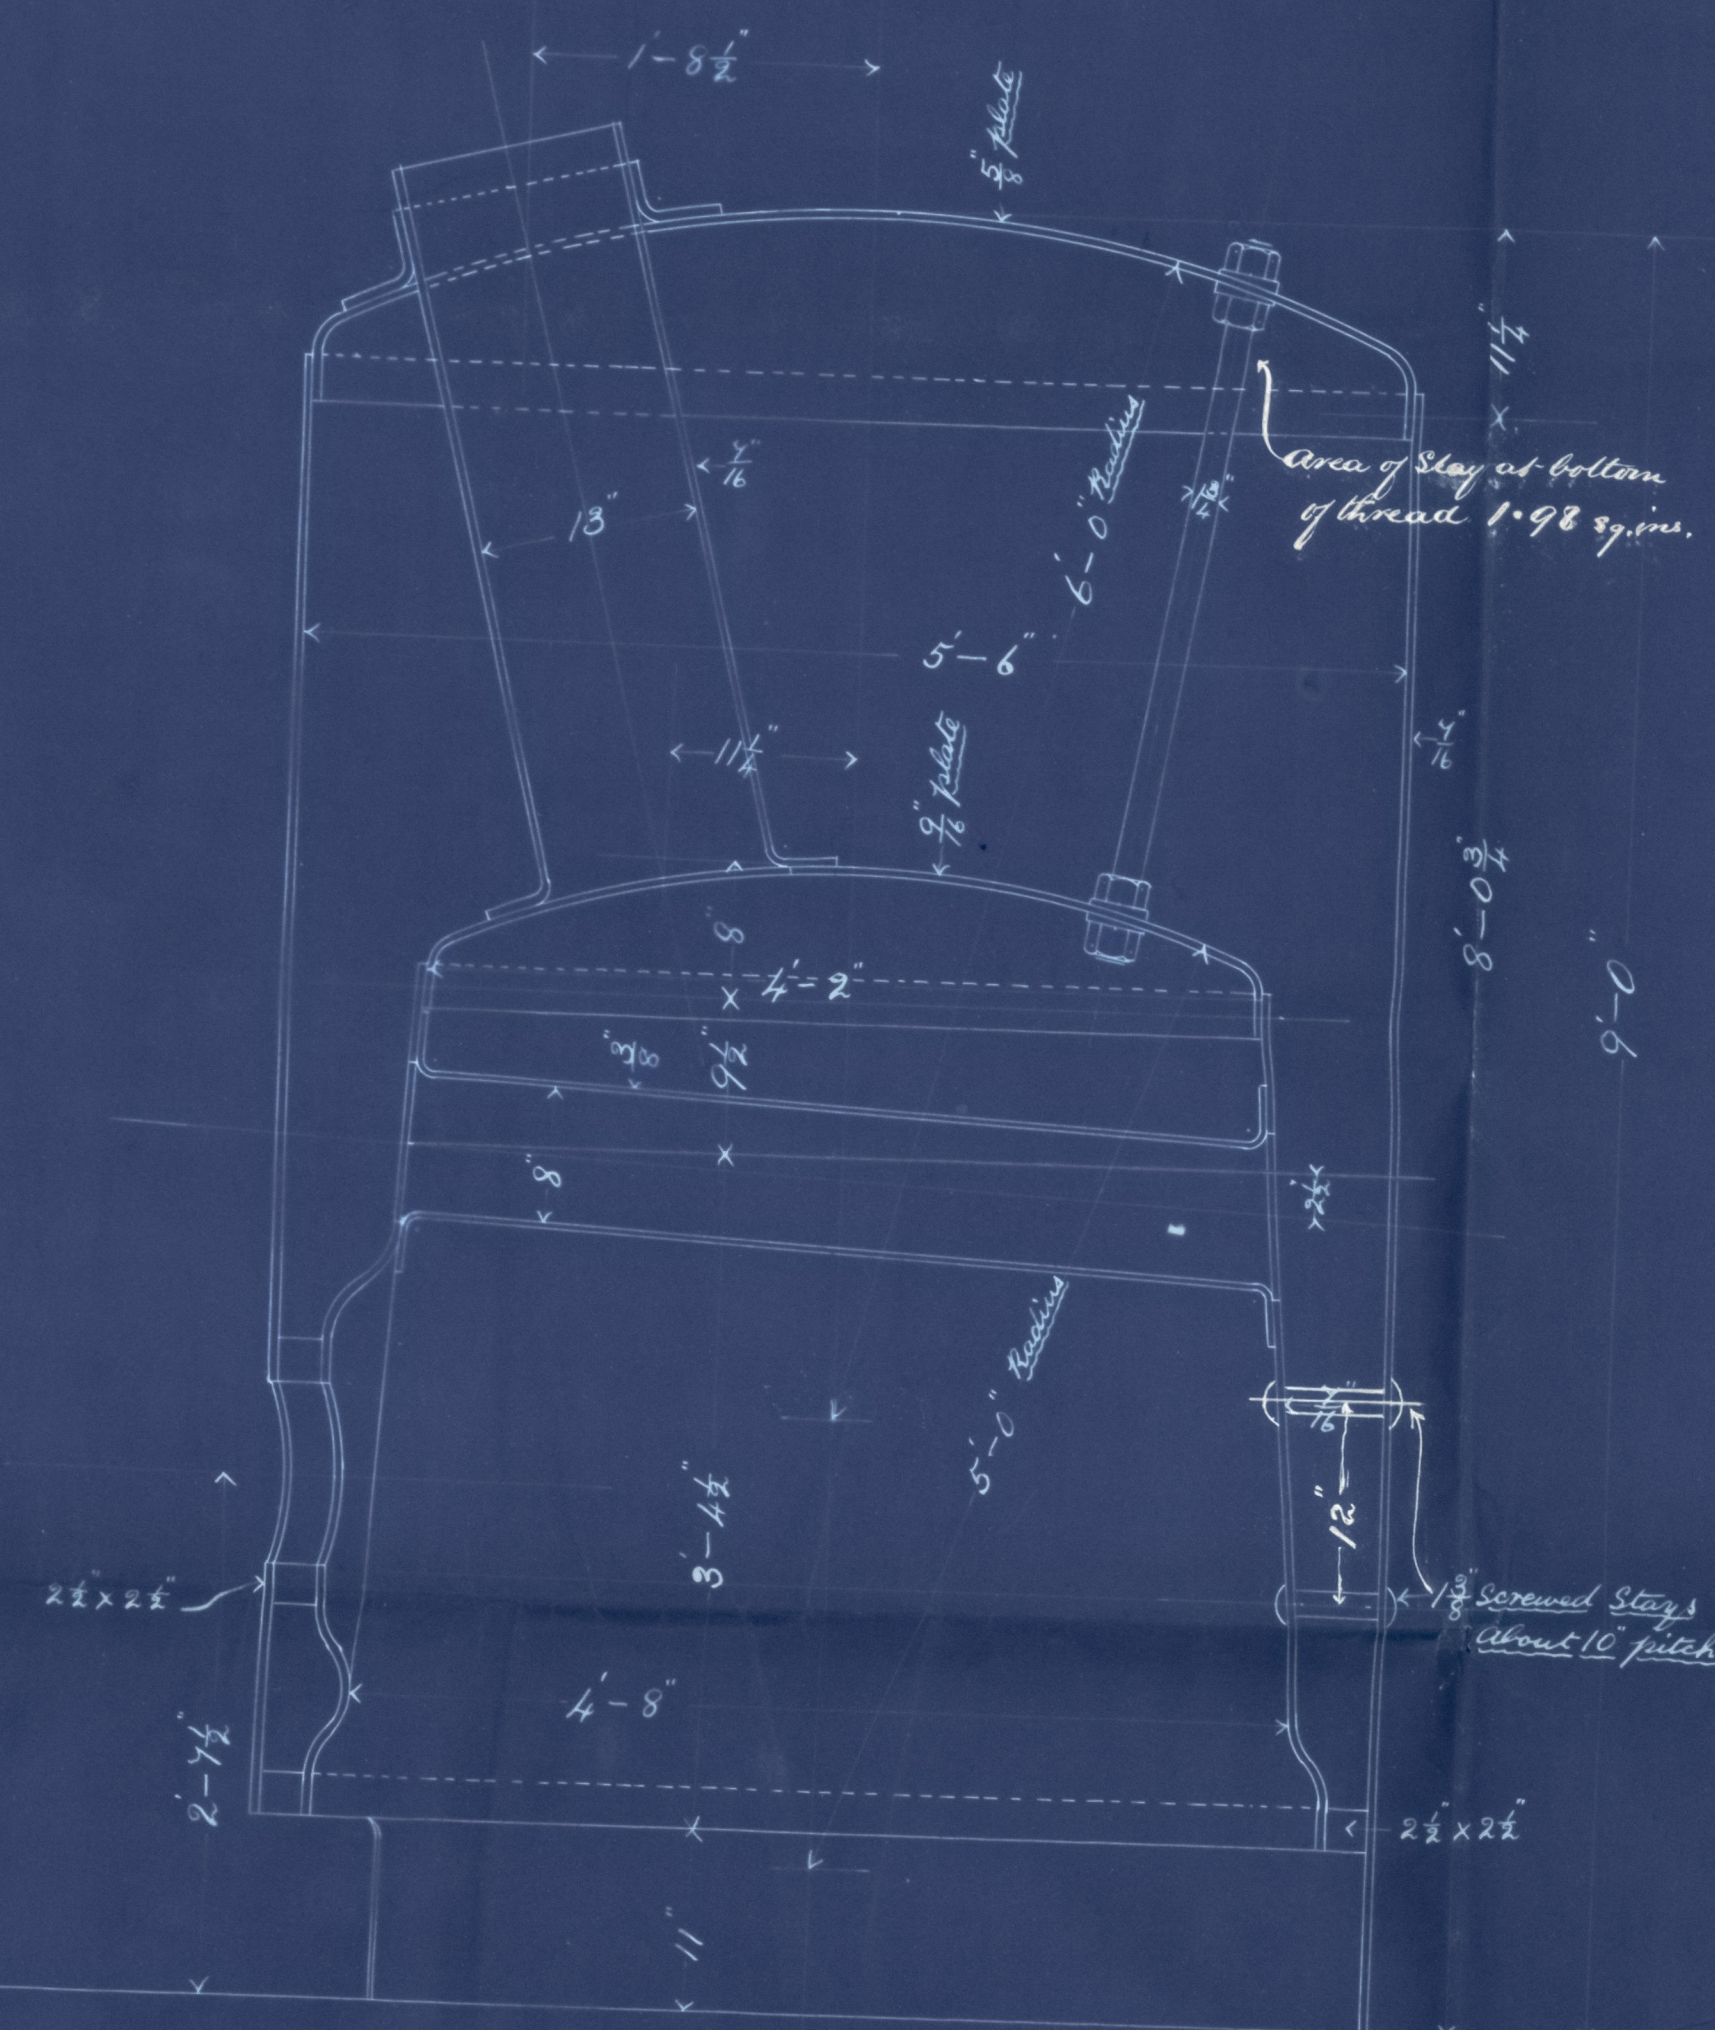

NA.
14.1.92

Exam^d 13/11/92
D.H.

22" Blue Bell.
Greenock Report No. 10537.

E-N^o 213
214

Donkey Boiler

All steel except tubes and uptake which are Iron

Scale 1" = one foot

Working Pressure 80 lbs.

DAVID J DUNLOP & CO
ENGINEERS & SHIPBUILDERS
PORT GLASGOW.

9/1/92

ARK 320-0231

Donkey Boilers.

W. J. Dunlop & Co's
Nos. 213 & 214


"Blue Bell."

Greenock Report

No. 10537.

(Min. hule 16 $\frac{3}{4}$ + 12 $\frac{3}{4}$.)

Sh. D. 4 $\frac{3}{8}$ + 7 $\frac{7}{8}$

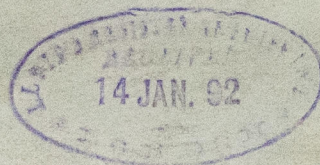

6PH320-0231



© 2021

Lloyd's Register
Foundation