

S. S. "Blue Bell"

Received at

Office,

Lloyd's Register of British and Foreign Shipping.

(Report on Vessel No. 10537 Port Greenock.)

Greenock

No. 2223 a

SHIP FORGINGS OR CASTINGS.

The words FORGINGS or CASTINGS, IRON or STEEL, should be struck out as may be required.

I have to report that the undermentioned Iron or ~~Steel~~ Forgings or Castings, manufactured by

Wm. & N. Reed & Co. of Sunderland

for the Vessel No. 213, being built by Wm. & J. Dunlop & Co.

of Greenock have been inspected by me as set forth below, and found

to be, so far as can be seen, sound

Mark on Forgings.

Lloyd's


No. 2223 a
W. & N. C.

Wm. Cannon

Sunderland
7.4.92

	STERN FRAME.	RUDDER FRAME.	STEM.
Material*	<u>Scrap iron</u>	<u>Scrap iron</u>	<u>Scrap iron</u>
How made	<u>Forged</u>	<u>Forged</u>	<u>Forged</u>
Dimensions	<u>6 1/2" x 3 3/4"</u>	<u>4 1/2" x 2 3/4"</u>	<u>6 1/2" x 1 7/8"</u>
Progress on Inspection	<u>Forged & smithed</u>	<u>Forged & smithed</u>	<u>Forged</u>
Dates when Inspected	<u>Jan'y 13 Feb'y 3/92</u>	<u>March 11-28/92</u>	<u>Jan'y 16/92</u>

SKETCHES OF FRAMES SHEWING POSITION AND DESCRIPTION OF WELDS OF FORGINGS, OR PARTICULARS OF TESTS APPLIED TO CASTINGS.

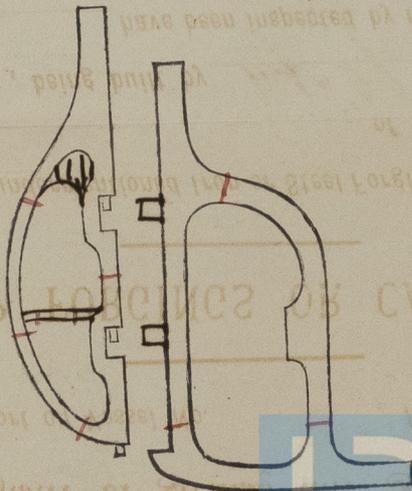

Welds

* If of Iron, state whether scrap or puddled Iron.










© 2021

Lloyd's Register
Foundation

















