

380.

at ho. 1


Sept.

299 = " Ballachulish
Gr. Rept. No. 10606
300 = " Colintrane
Gr. Rept. No. 10665

Panting Arrangement

—Ship Nº 300— 8299

— Scale — $\frac{1}{4}$ inch = 1 foot —

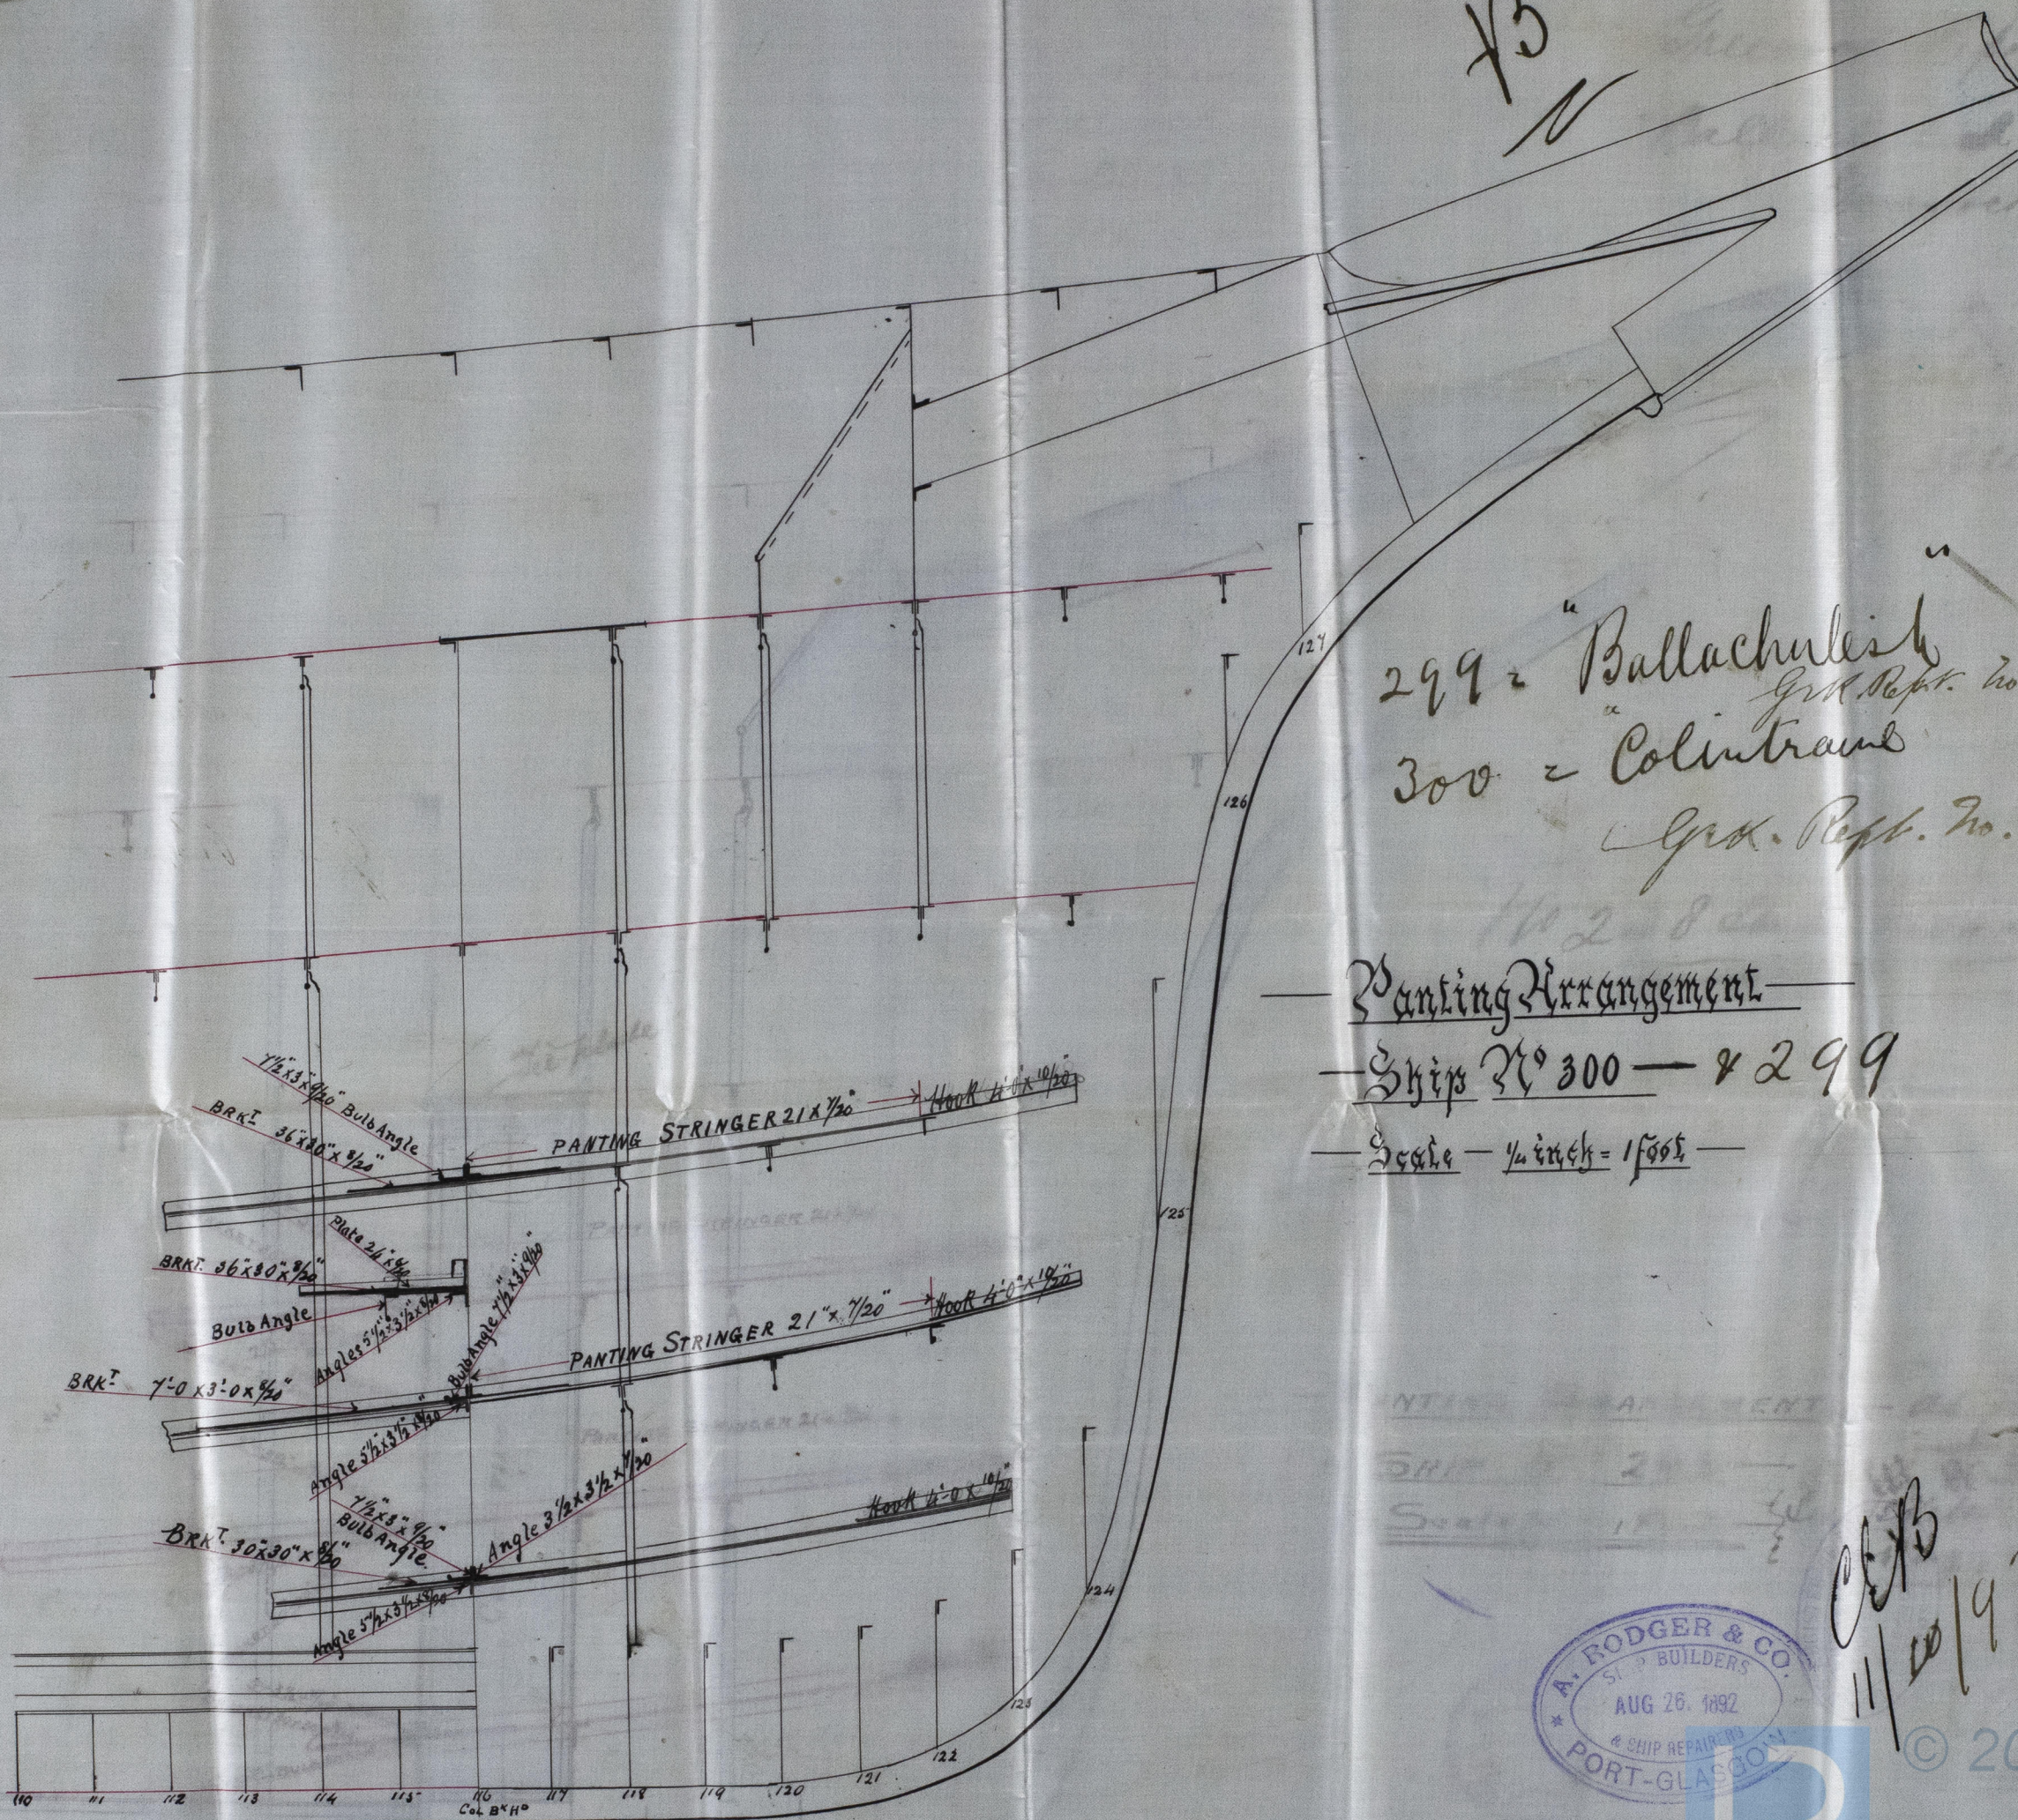

CEB
11/10/92

© 2019

Lloyd's Register
Foundation