
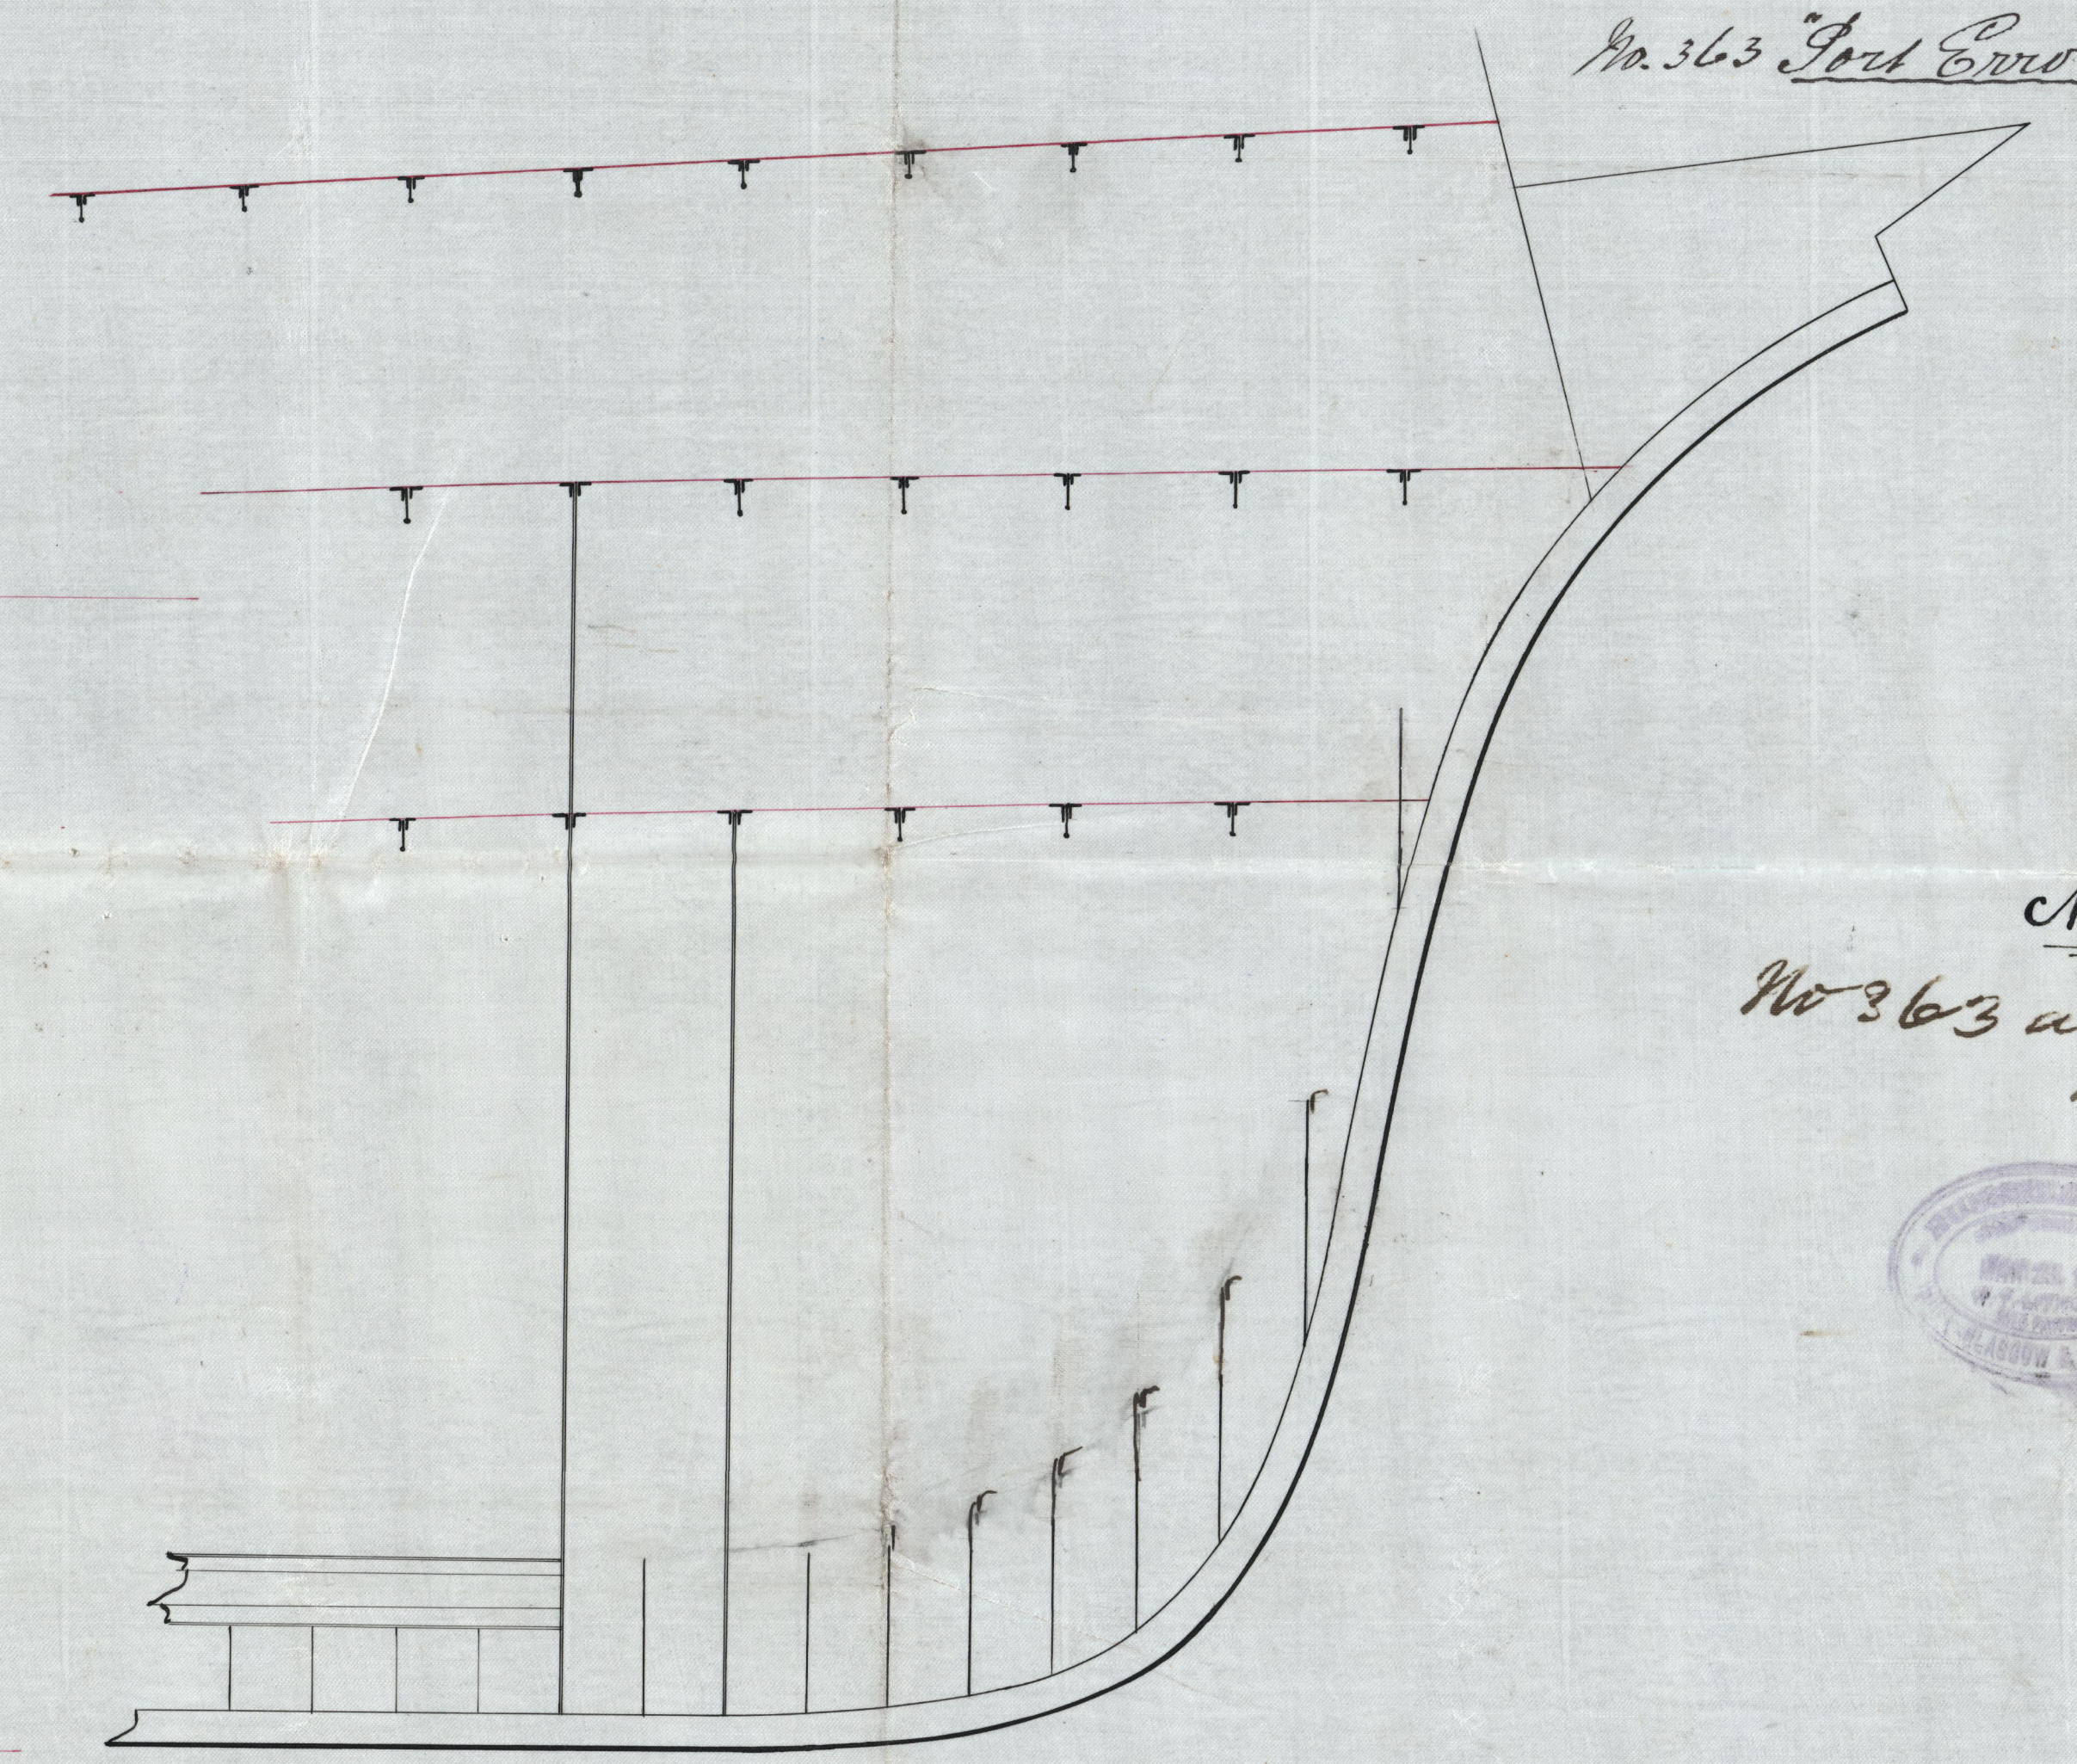


28.3.92
No. 338
16.5.93


ALTERATIONS IN BLUE
For No. 363

"Langiemore"
Greenock Report No. 10700.
"Arranmore."
Greenock Report No. 10875.

 

No. 363 Port End

No. 313
No. 363 approved
14.2.94.

 


Russell & Co No 313
Profile. On plan

"Largiemore."

Gr. Rpt. No. 10700.


"Arranmore."

Greenock Report

No. 10875.

"Port Enrol."

Gr. Rpt. 11167

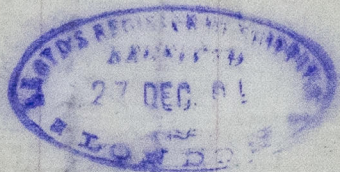

© 2020

Lloyd's Register
Foundation

GR4323-0150

Russell & Co No 31