

Russell's No. 315.

"Donna Julia."
Gr. Rept. No. 10710.

GRW323-0184

L. J. 2/10/55



© 2019
Lloyd's Register
Foundation

4.8.92



PANTING ARRANGEMENT

N^{os} 315 ~~314~~


SCALE $\frac{1}{4}$ " = 1 FOOT

"Donna Julia"

G.R. Rept. No. 10710.

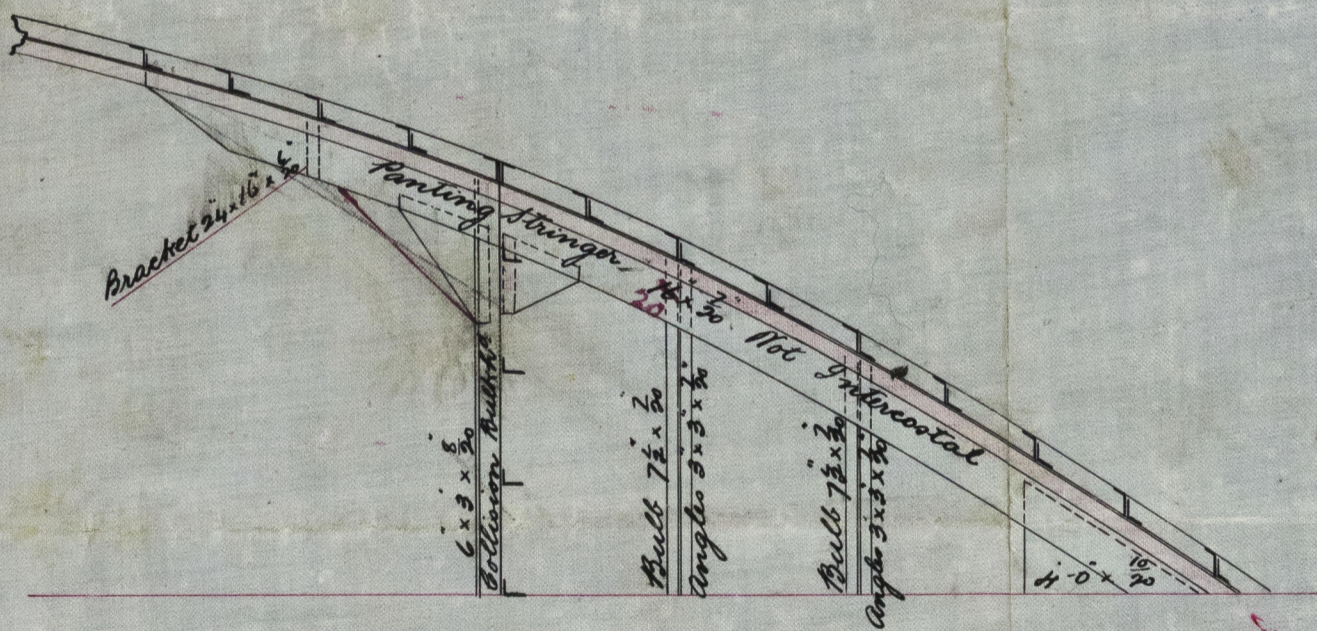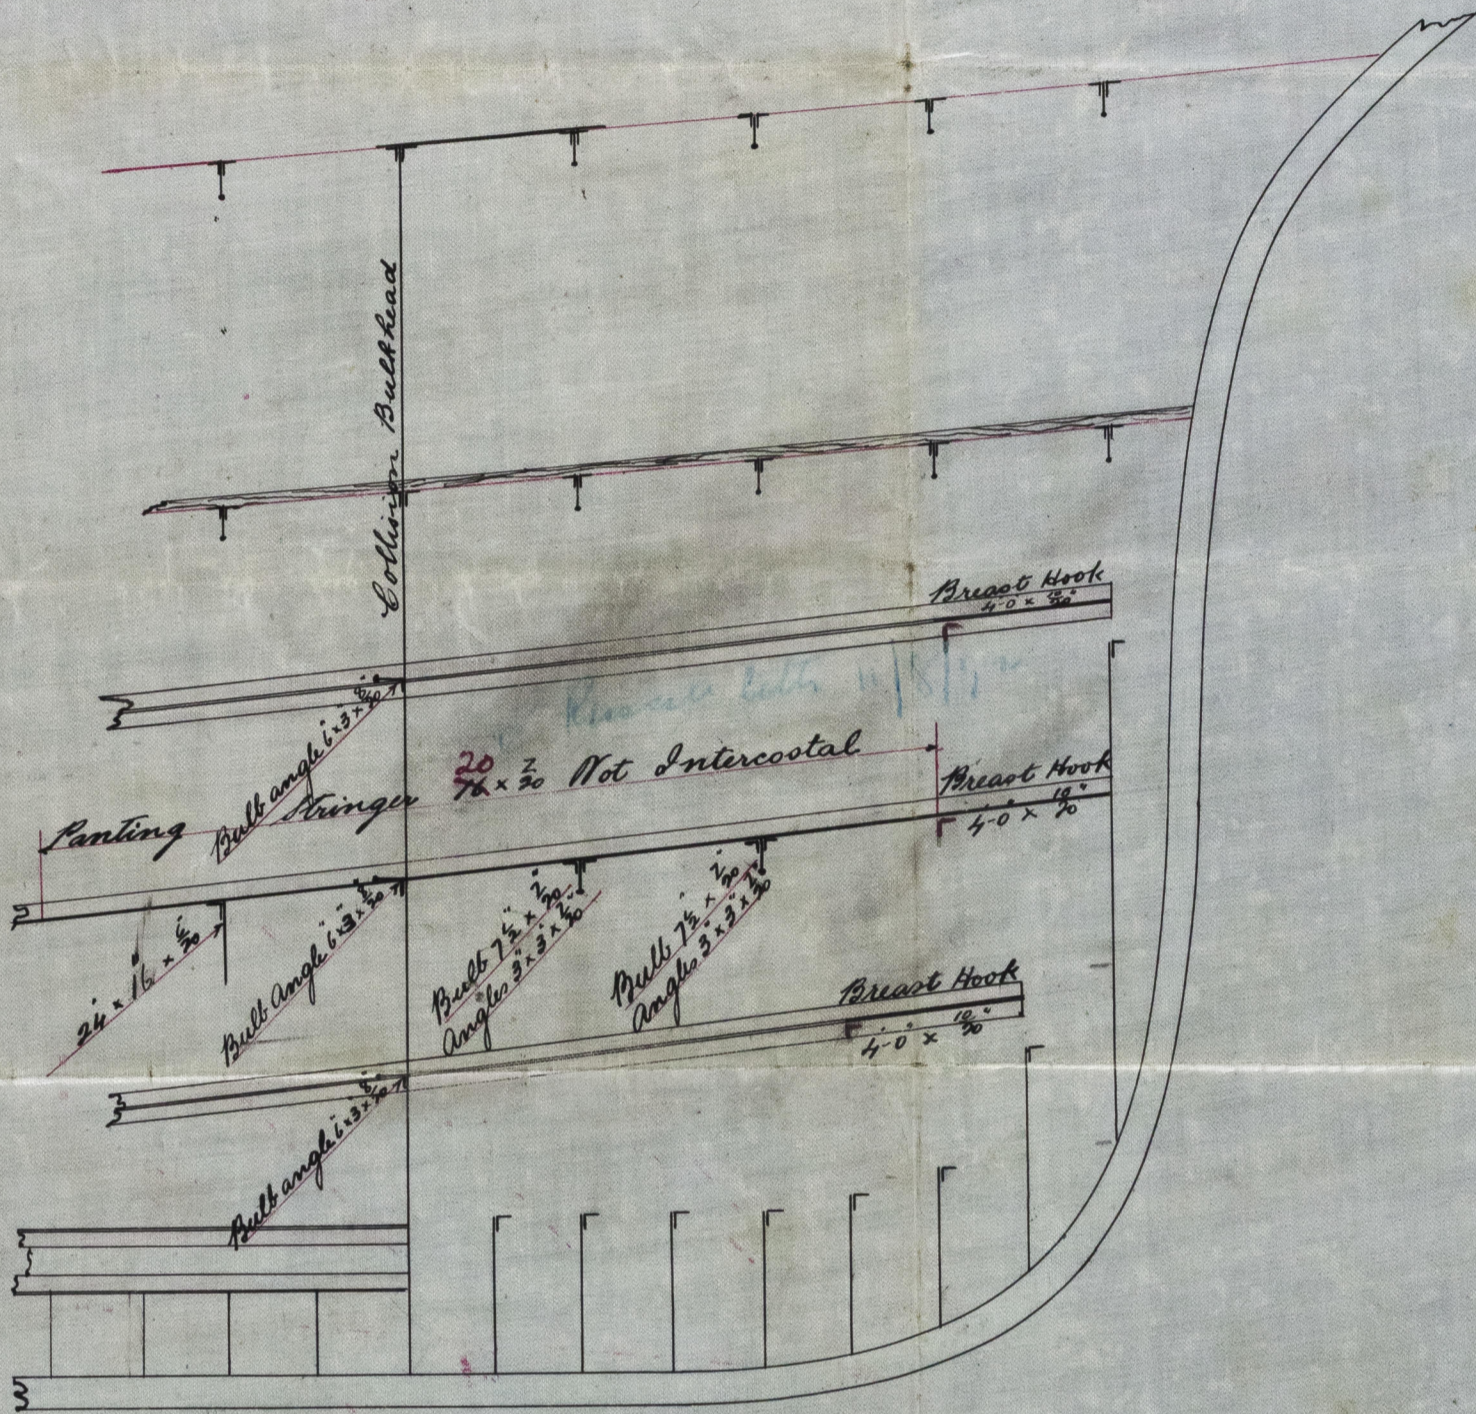

14.7.
4/8/92

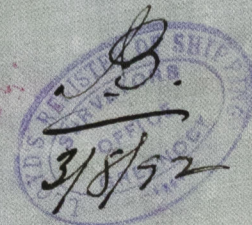

© 2019

Lloyd's Register
Foundation

GRK323-0184