

"*Somna Julia*."
Greenock Report No. 10710

All lands of Fore Main & Myer Lower Marts $2\frac{1}{2}$ s.n. $\frac{7}{8}$ Fivels
Butte " " " " " Lapped $5'\frac{1}{2}$ s.n. below deck
" " " " " " $7\frac{1}{2}' \pm$ s.n. above.
Fore & Main Lower Mart 2 plates in the round with 2 angles $3\frac{1}{2} \times 2 \times \frac{1}{2}$ whole length
Myer Lower Mart 2 plates in the round with 2 angles $3\frac{1}{2} \times 2 \times \frac{1}{2}$ whole length
All lands of Bourgepit $4\frac{1}{2}$ s.n. $\frac{7}{8}$ Fivels corner tabular cap $2\frac{1}{2} \times 1 \times \frac{1}{2}$ outside of cap
Butts of Bourgepit lapped $5' \pm$ inside straight $1\frac{1}{2}' \pm$ s.n. outside knight
Bourgepit 2 plates in the round with 4 angles $3\frac{1}{2} \times 2 \times \frac{1}{2}$ whole length
Lands of Lower Yards & Topmasts $2\frac{1}{2}$ s.n. $\frac{7}{8}$ Fivels, other yards $2\frac{1}{2}$ s.n. $\frac{7}{8}$ Fivels
Butts of all yards lapped $7\frac{1}{2}' \pm$ Butts of topmasts in way of top-mast
Yards stopped Butts overlap $1\frac{1}{2}' \pm$ thicker than the plates they connect
Remainder of Butts lapped $7\frac{1}{2}' \pm$ s.n.

RIGGING PLAN
No 815

SCALE $\frac{1}{8}$ INCH TO ONE FOOT

Under Deck Lonnage 1330 tons

	Steel	Wire	Chain	Lead	Flap
<u>Mizen Mast</u>					
4 Lower Shrouds	27	15	1		
2 Topmast Backstay	27	15	1		
1 Topgall ^e	18	8	3		

	Sec	W	Th	F	S
Here + Main Mast					
6 Lower Shrouds	4 8	1 8	1 8	1 8	1 8
1 Cap Backstay	"	"	"	"	"
3 Topmast Backstays	"	"	"	"	"
1 Cap. Backstay	"	"	"	"	"
2 Topgallant Backstays	2 8	1 8	1 8		
Topmast Shrouds	2	1 8	1		
Topgallant "	1 5	1	8		

Masts wedged at Main Deck only

Heels of Masts strengthened to Surveyors Satisfaction


 Butts
 Rigging Plan.


Russell Nov. 315

"Donna Julia"

Greenock & Rept. to 10/10

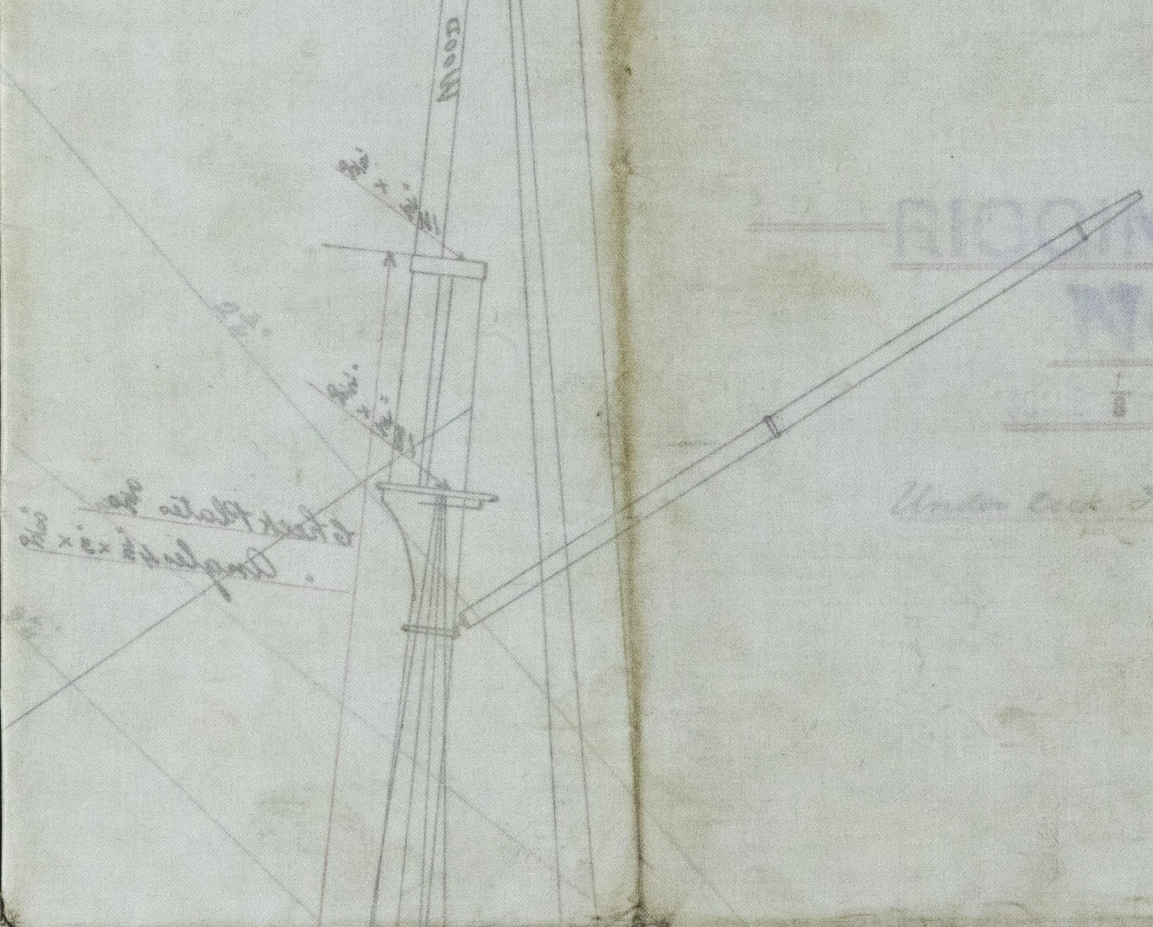

RIGGING PLAN

Under Deck Tonnage 1500 tons



© 2020

Lloyd's Register
 Foundation

GRK323-0185