

Soma Julia

Received at

Office,

Lloyd's Register of British and Foreign Shipping.

(Report on Vessel No. *10710* Port *Greenock.*)

No. *3658* SHIP FORGINGS ~~OR CASTINGS~~.

The words FORGINGS or CASTINGS, IRON or STEEL, should be struck out as may be required.

I have to report that the undermentioned Iron ~~or Steel~~ Forgings ~~or Castings~~, manufactured by *The Irvine Forge Coy* of *Irvine* for the Vessel No. *315*, being built by *Messrs Russell & Co* of *Port Glasgow* have been inspected by me as set forth below, and found to be, so far as can be seen, *Sound & efficient*

Mark on Forgings.


Lloyd's
No. *3658*
W. H.

William Hamilton

Glasgow
11/10/92

	STERN FRAME.	RUDDER FRAME.	STEM.
Material*	/	<i>Scrap iron</i>	/
How made		<i>Forged</i>	
Dimensions		<i>6 to 3 dia</i>	
Progress on Inspection		<i>Forging & smithing</i>	
Dates when Inspected		<i>24/6/92. 12. 26/7/92. 1/9</i> <i>24/8/92. 29/9/92. 7/10/92</i>	

SKETCHES OF FRAMES SHEWING POSITION AND DESCRIPTION OF WELDS OF FORGINGS, OR PARTICULARS OF TESTS APPLIED TO CASTINGS.

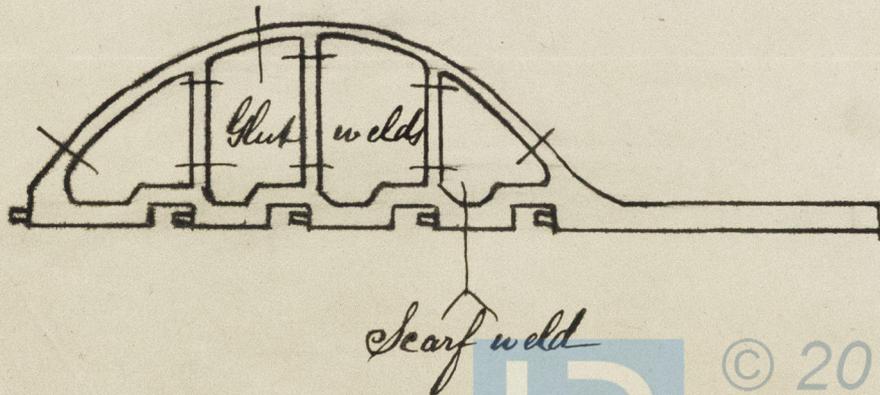

* If of Iron, state whether scrap or puddled Iron.

