

S.S. "Vanland"

Received at

Office

18

Lloyd's Register of British and Foreign Shipping.

(Report on Vessel No. 1075-7)

Port

Greenock

Greenock

No. 2165a

SHIP FORGINGS OR CASTINGS.

I have to report that the undermentioned Iron ~~or Steel~~ Forgings or Castings, manufactured by

Messrs G W Reed & Co

of Sunderland

for the Vessel No. 35, being built by The Cambeltown S B Co.

of Cambeltown

have been inspected by me as set forth below, and found

to be, so far as can be seen, sound.

The words FORGINGS or CASTINGS, IRON or STEEL, should be struck out as may be required.

Mark on Forgings.

Lloyd's

No. 2165a

S.B.


Walter Cameron

Sunderland

16. 2. 92

	STERN FRAME.	RUDDER FRAME.	STEM.
Material*	<u>Scrap iron</u>	<u>Scrap iron</u>	<u>Scrap iron</u>
How made	<u>Forged</u>	<u>Forged</u>	<u>Forged</u>
Dimensions	<u>7 1/2 x 4 3/4</u>	<u>5 1/2 - 3"</u>	<u>7 1/4 x 2 3/8"</u>
Progress on Inspection	<u>Forged & smoothed</u>	<u>Forged & smoothed</u>	<u>Forged</u>
Dates when Inspected	<u>Nov 2 Dec 12/91</u>	<u>Jan 13 Feb 13/92</u>	<u>Nov 19/91</u>

SKETCHES OF FRAMES SHewing POSITION AND DESCRIPTION OF WELDS OF FORGINGS, OR PARTICULARS OF TESTS APPLIED TO CASTINGS.

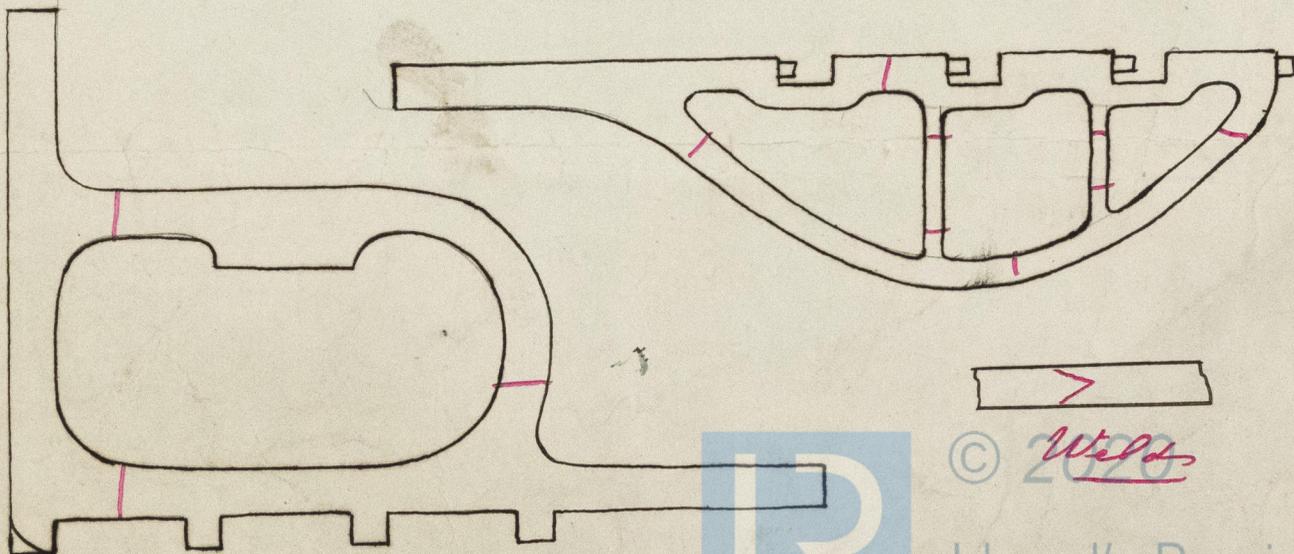

© Walter Cameron