
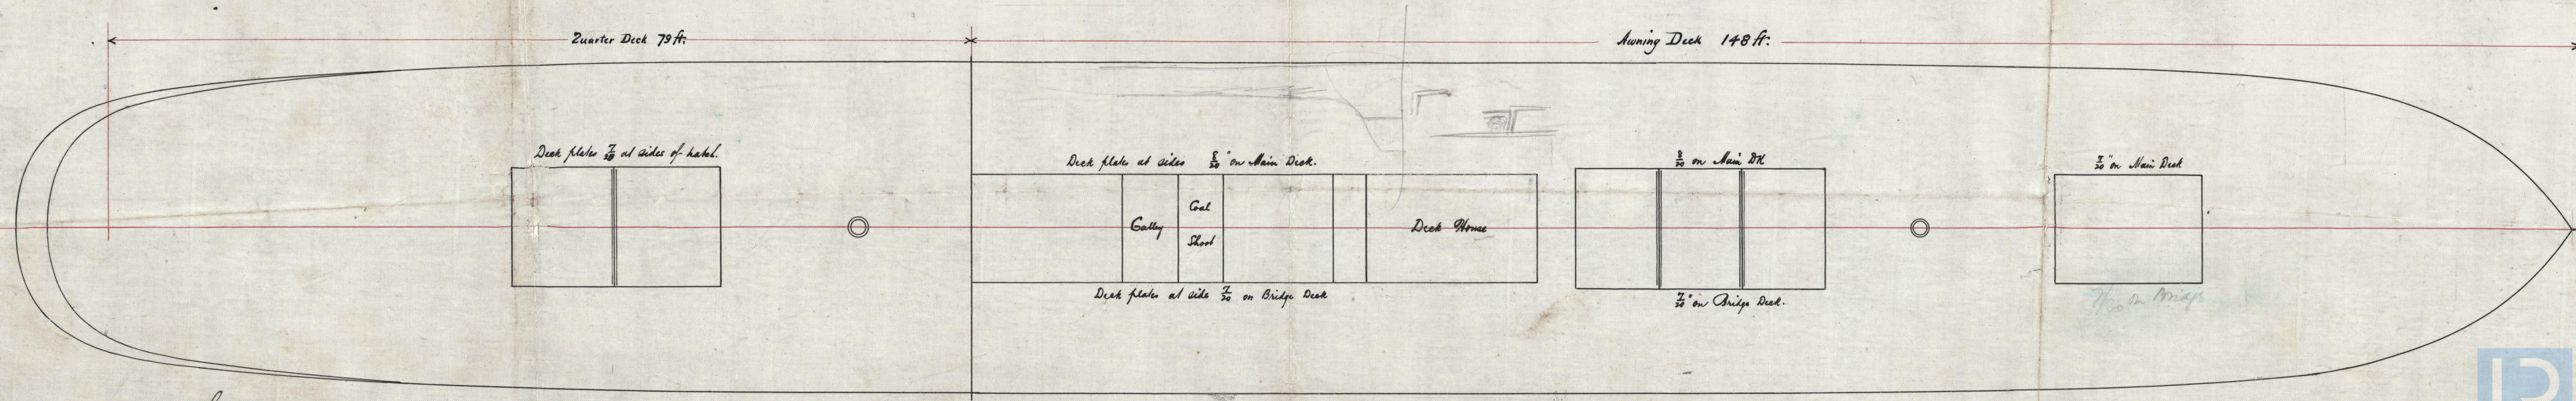


16.10.91.

S.S. "Vanland"  
Greenock Report No. 10757.

Longitudinal Plan  
S.S. No 35  
Scale  $\frac{1}{8}$  inch = One Foot.

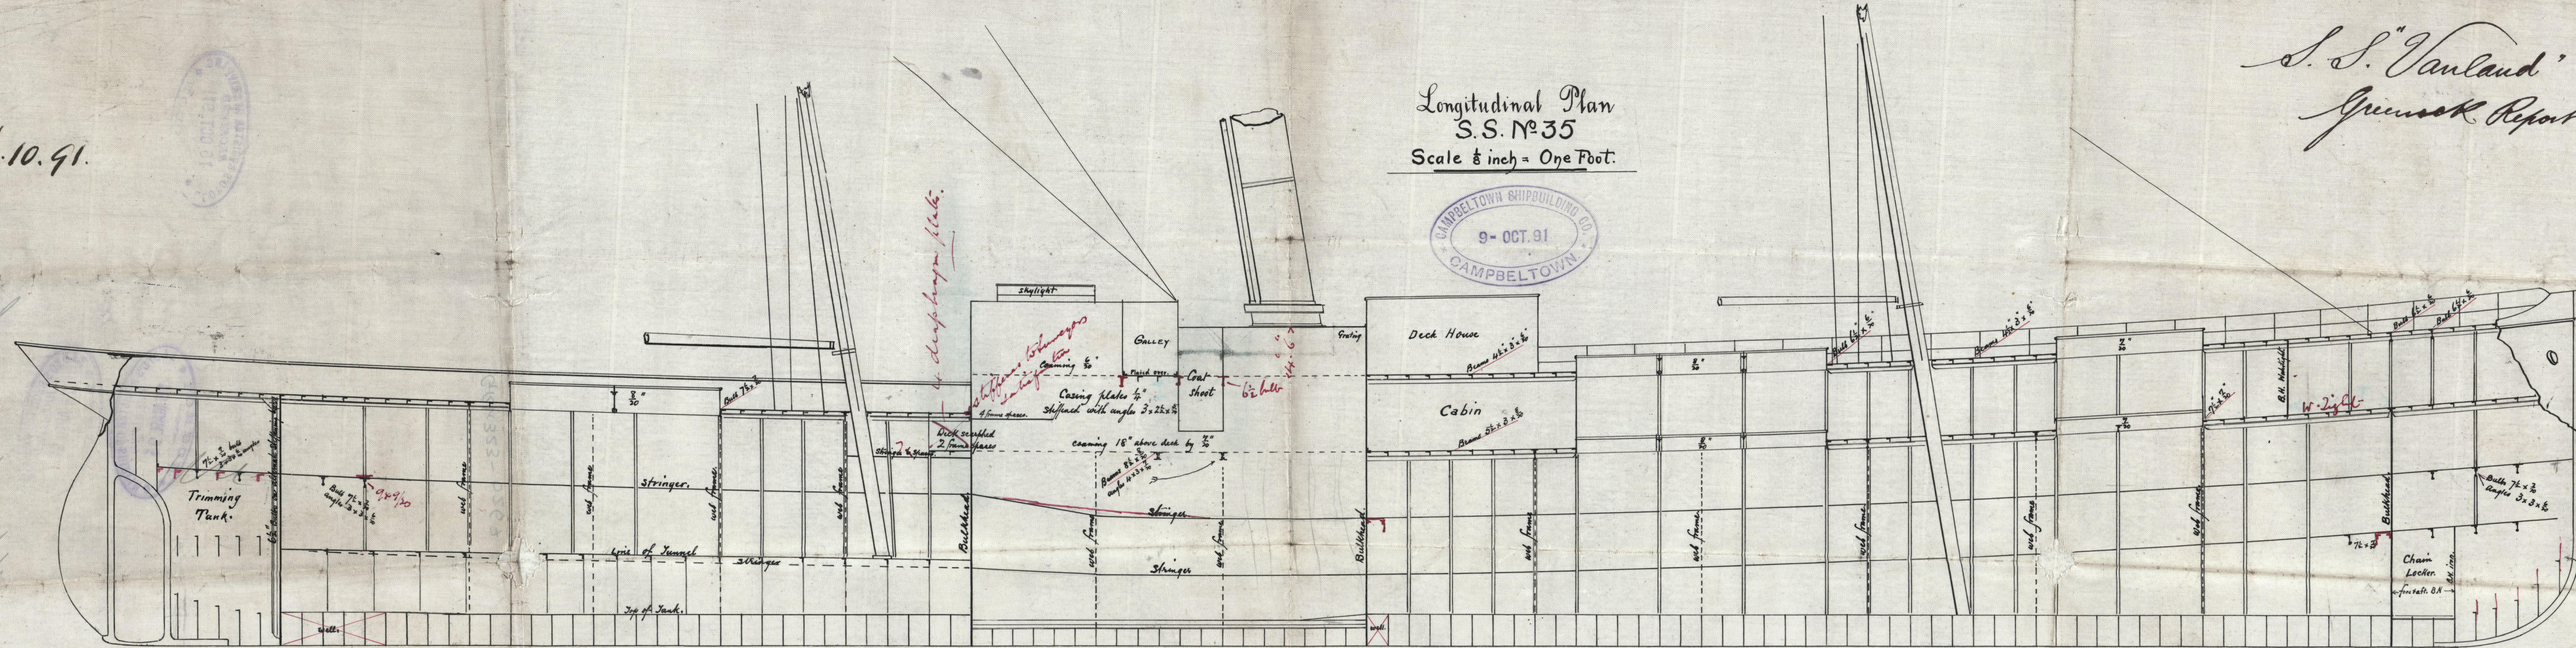

H.V.  
16/10/91

C.F.  
13/10/91




*Sketch of Longitudinal Section.*

*Campbelltown Shipbuilding Coys*

*No. 35 S. S.*

*S. S. "Vanland"*

*Greenock Report No. 10757.*

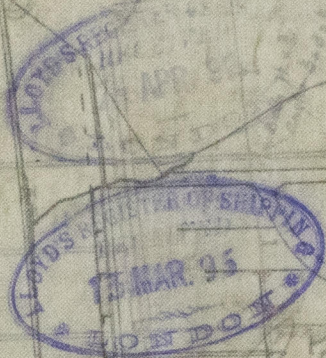

GRK323-0267



*L. P. 10/12*



© 2020

Lloyd's Register  
Foundation