


28. 11. 92


"Morven"  
Greenock Report No. 10768

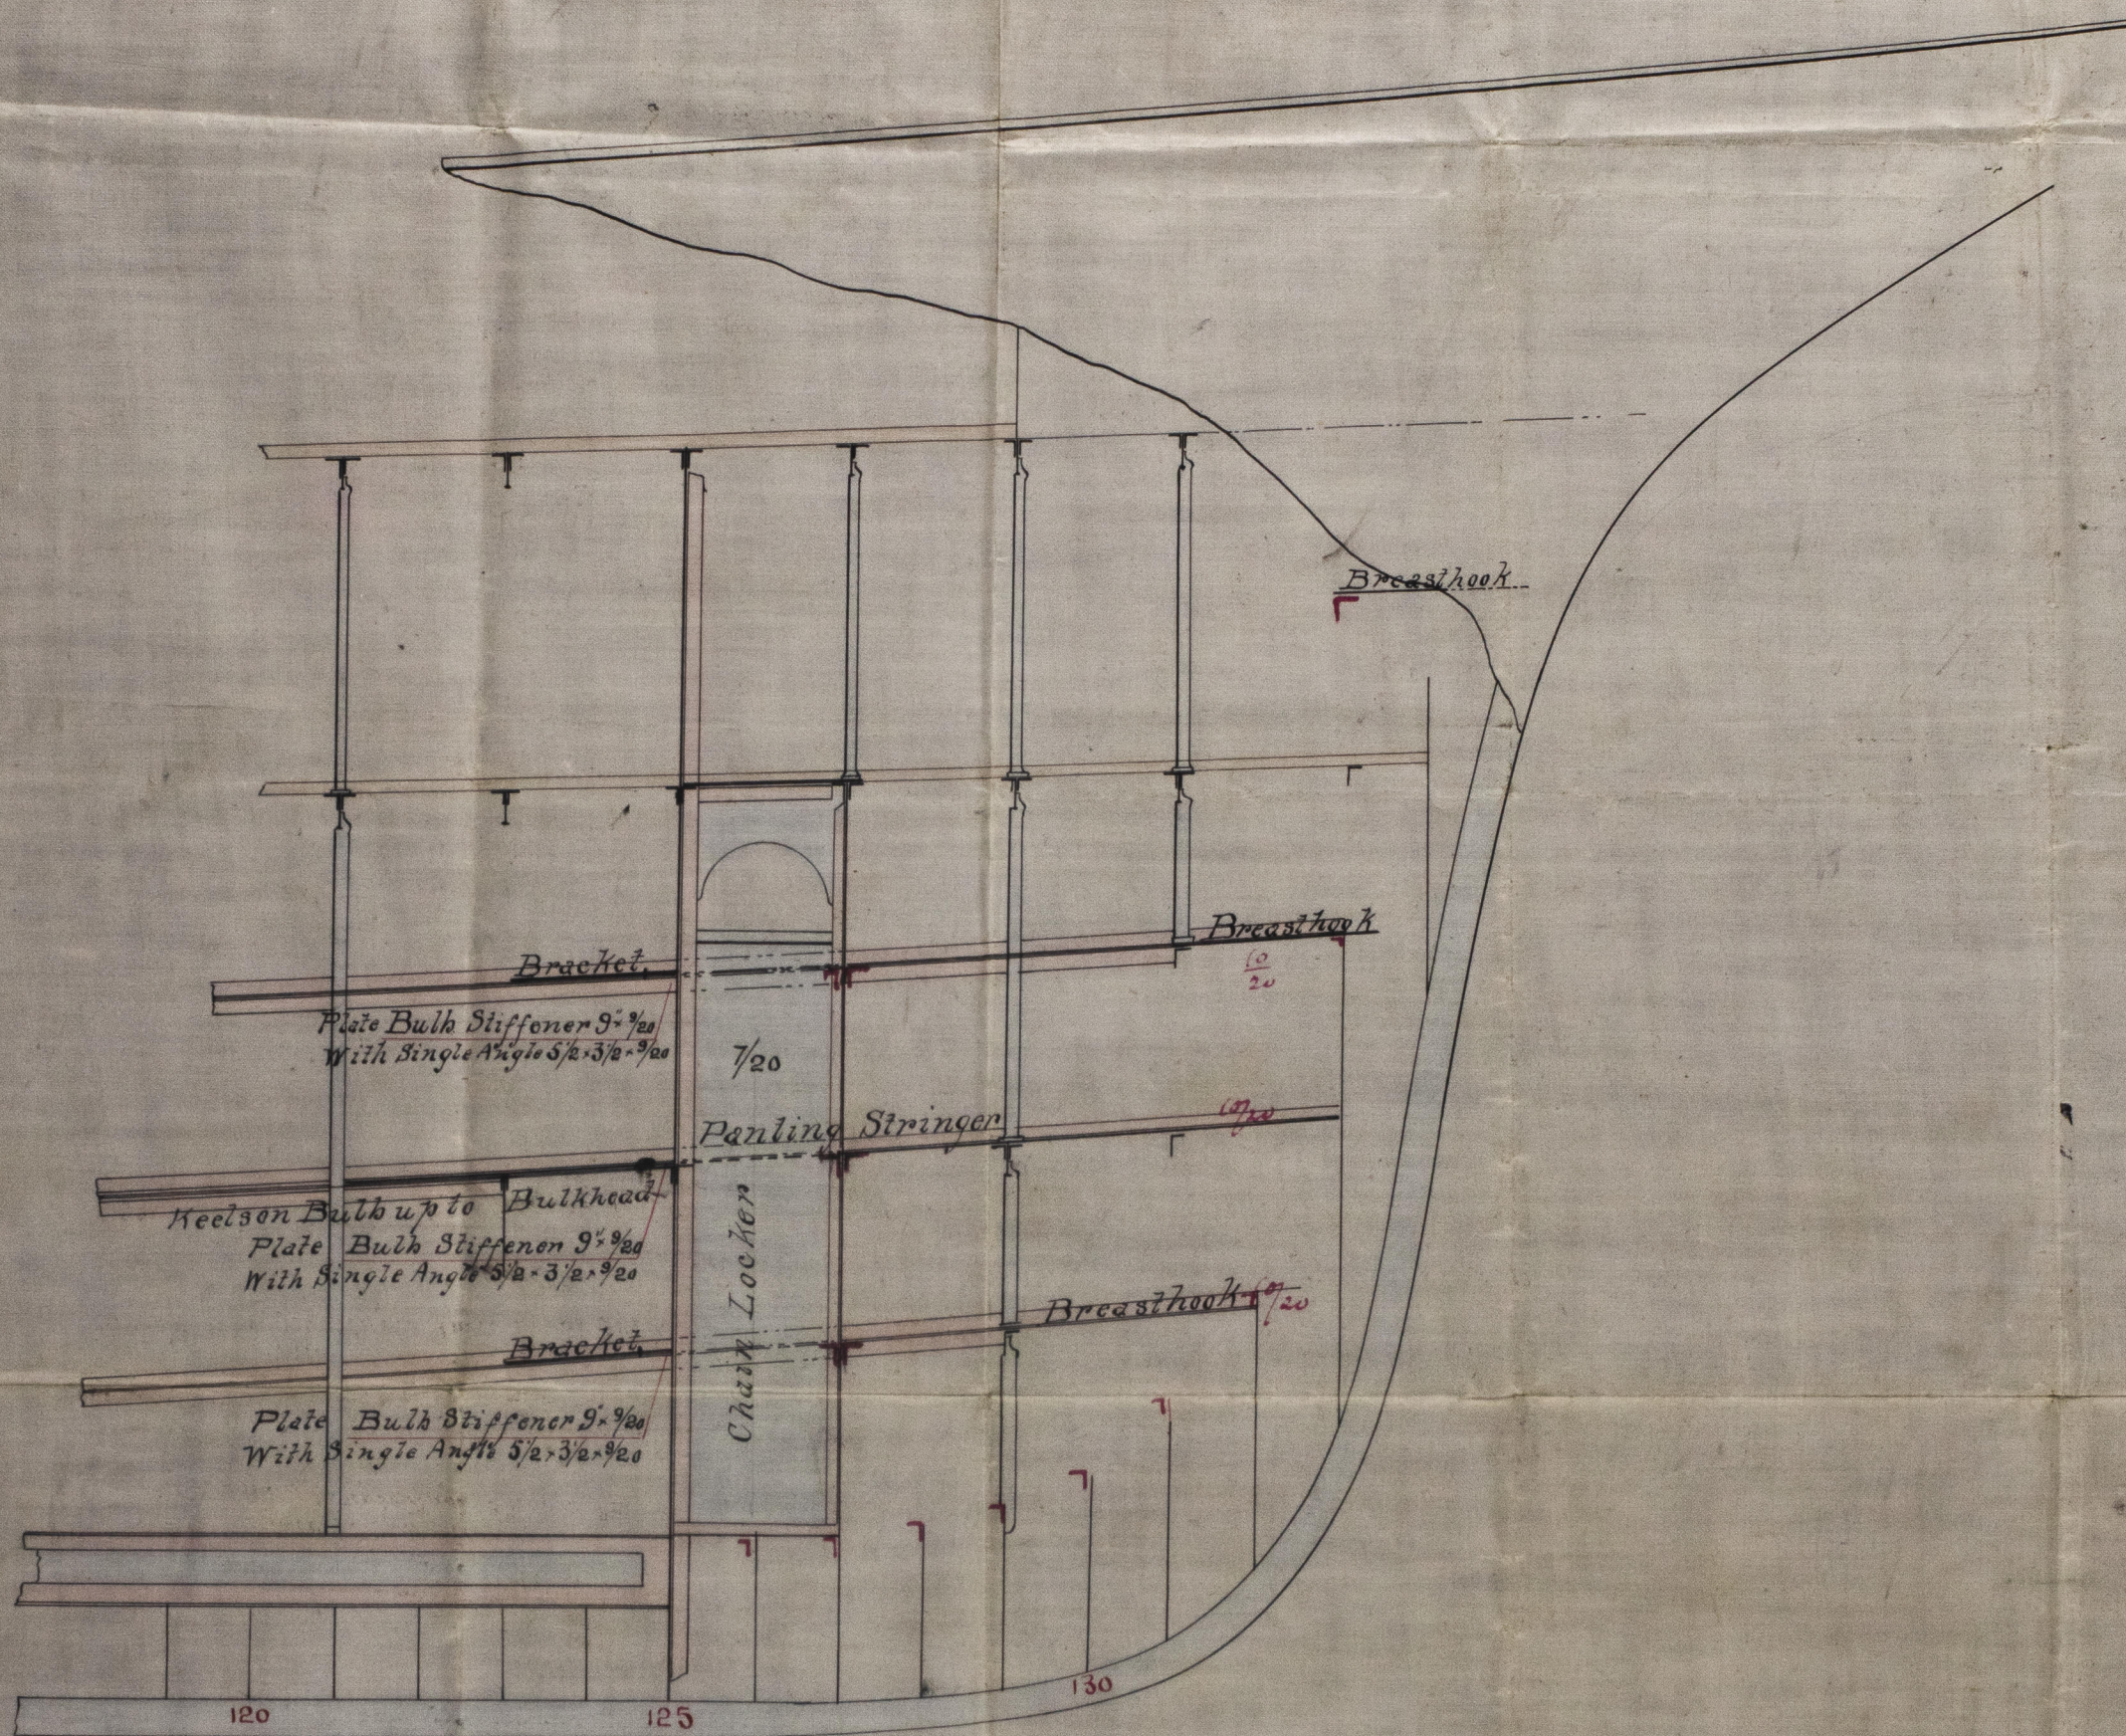

# Panting Arrangement

N<sup>o</sup> 262

Scale 1/4 in = 1 Foot

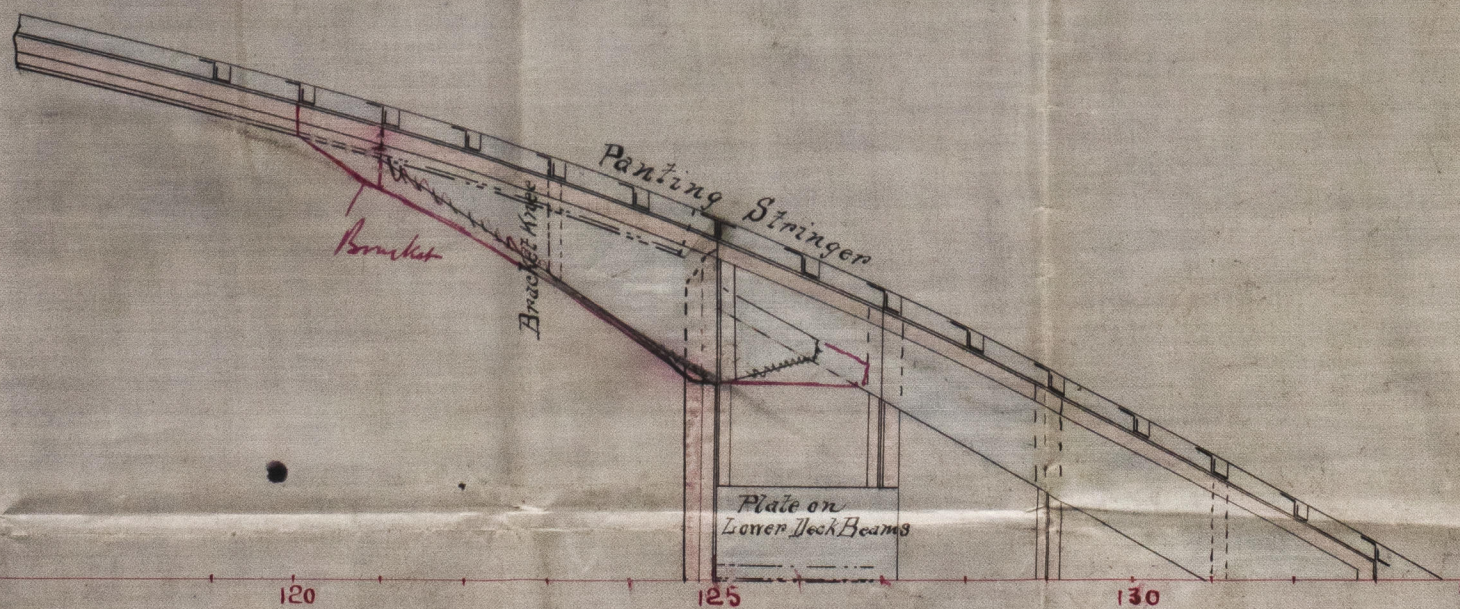

CRB  
25/11/92

400324-0013



R Duncan & Co.

S. No 262


"Morven" *gmk*

Greenock Reg. No. 10768.

APR 324-0015

*2007-11-08*

No 303

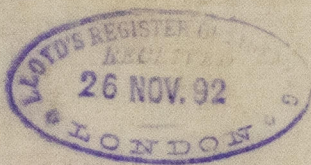

© 2019

Lloyd's Register  
Foundation