

"Morven":
Greenock Report No.

Half Midship Section

Ship No 262


To class 100 A. at Lloyd's

Numerals	
$\frac{1}{2}$ Girth	43.40
$\frac{1}{2}$ Breadth	20.96
Depth	26.96
1 st Numeral	91.32
	+ 268.33
2 nd	24503.89
+ $\frac{1}{16}$ in	1633.59
Equipment Num	26134.48

Proportions
Breadth to Length -- 6.40
Depth " " 9.95



N. B. This Vessel is a repeat of our
N^o. 258 - 9 + 6!

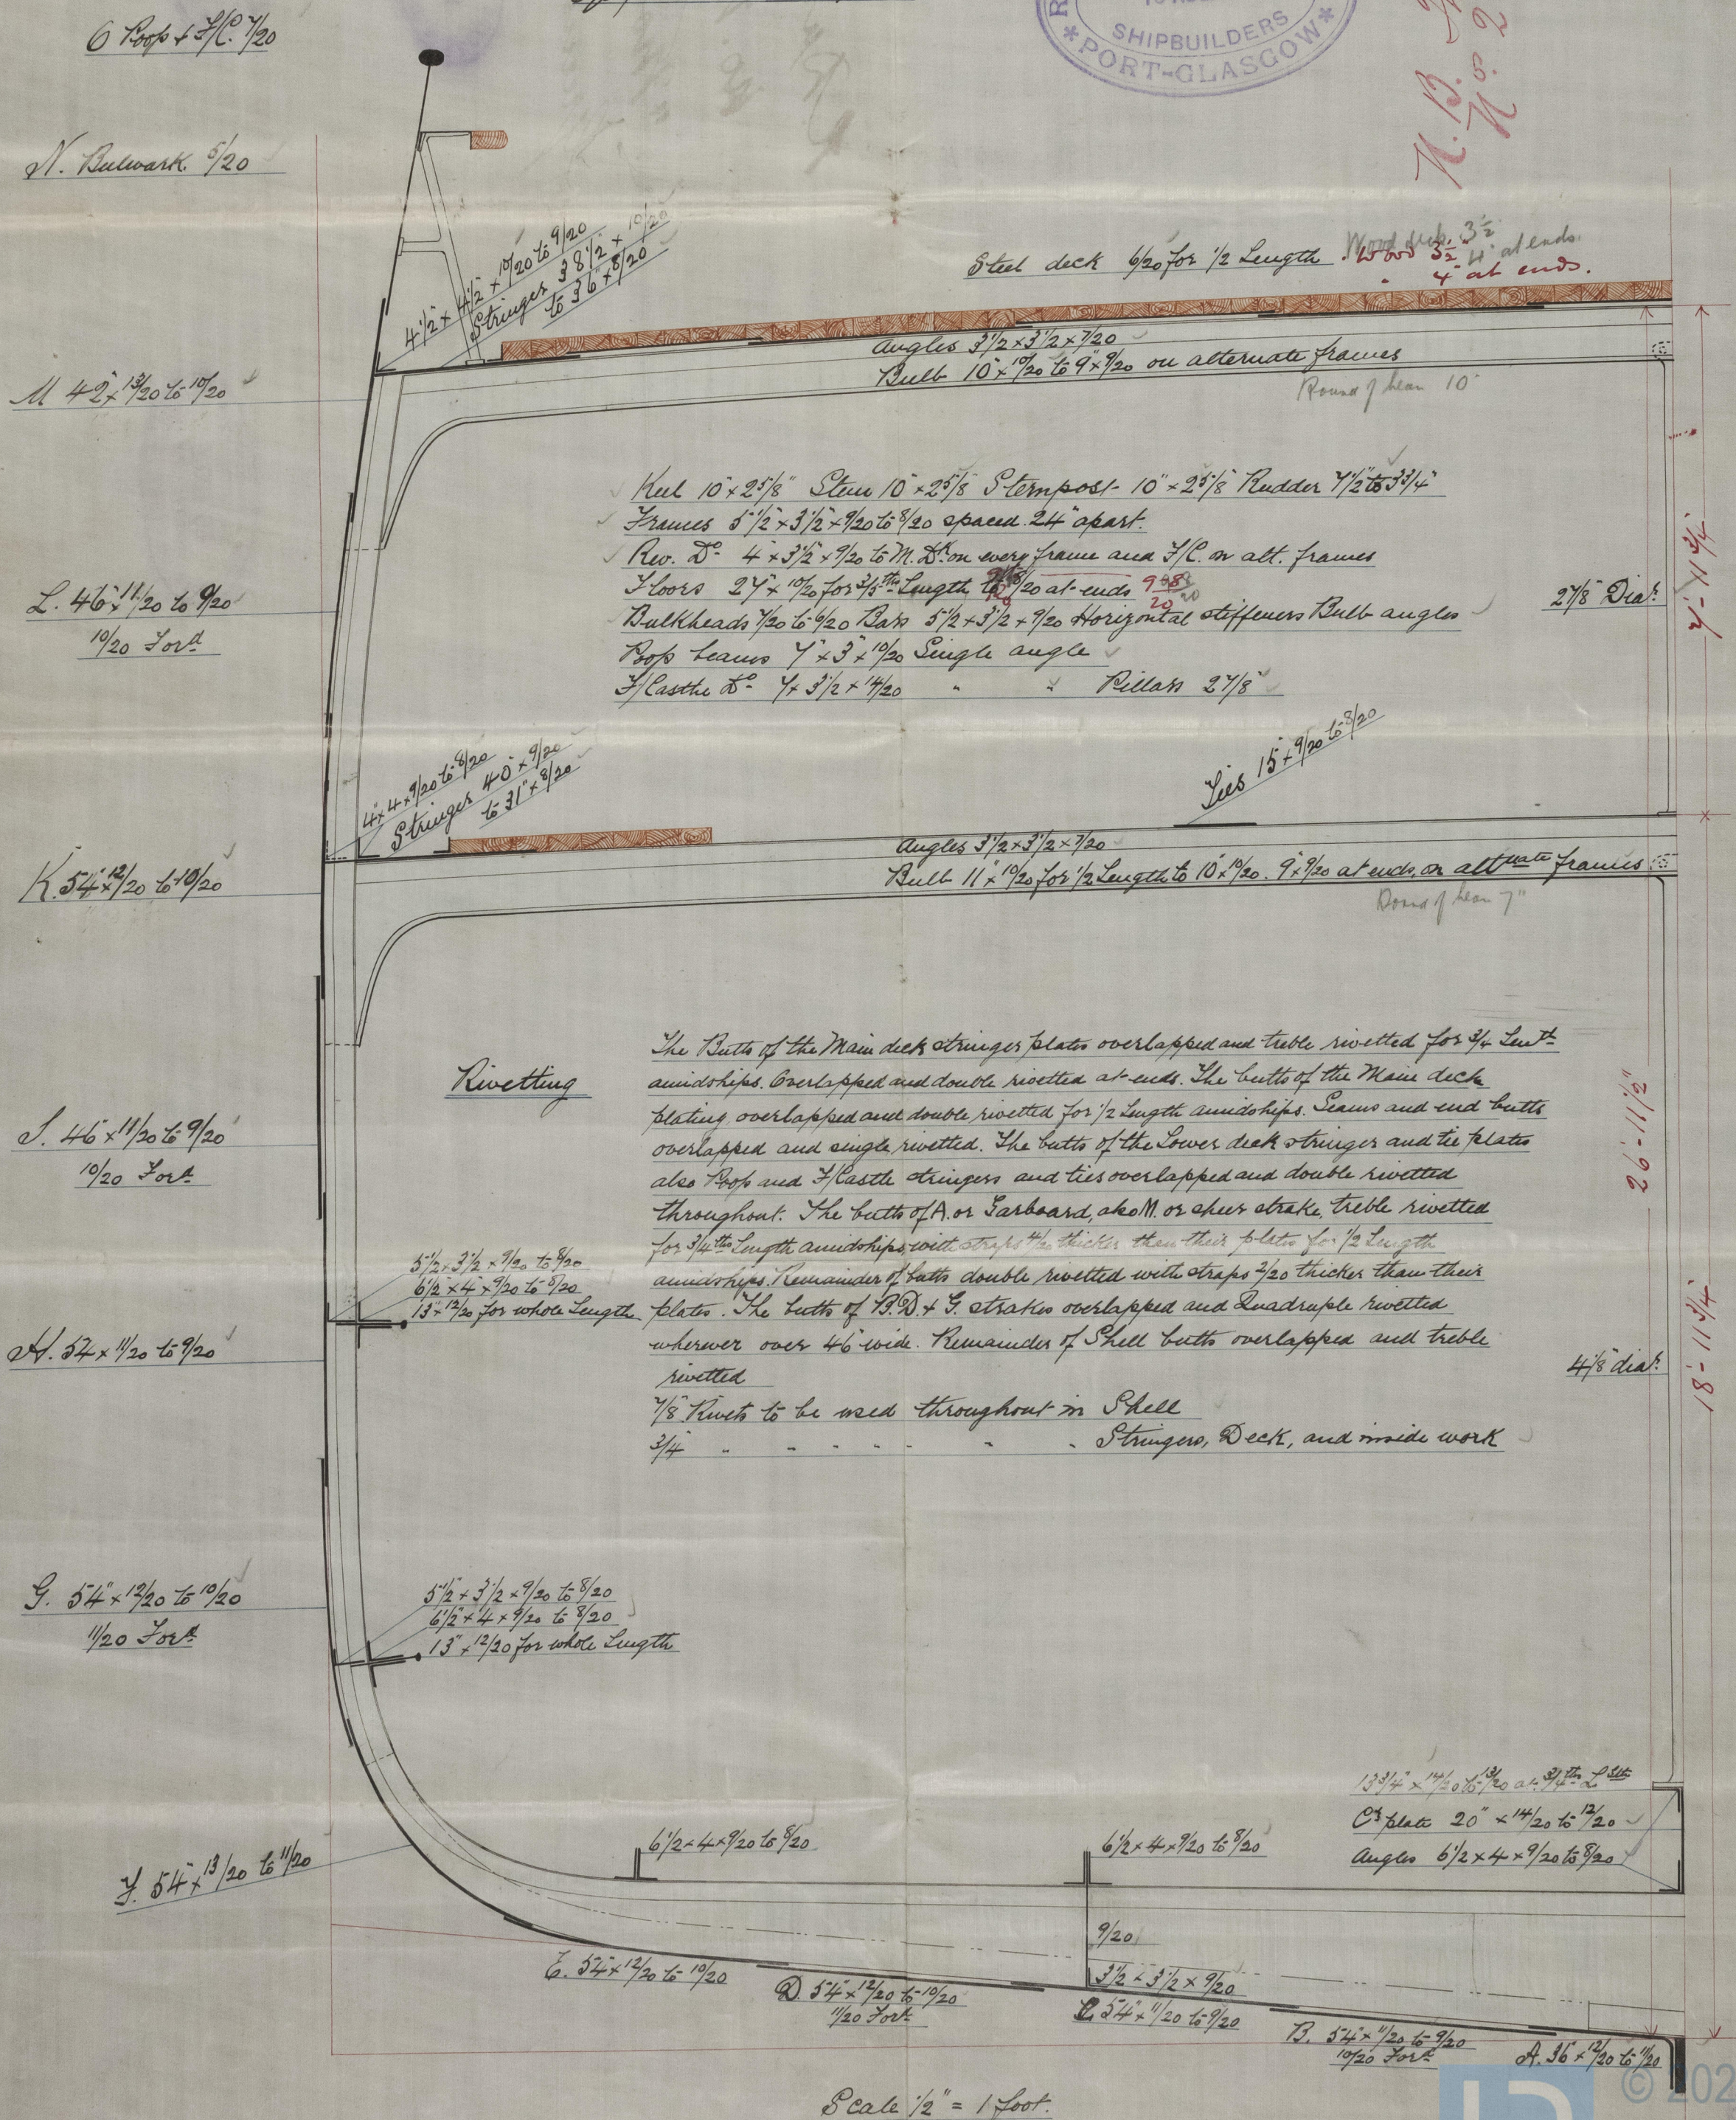

Scale $\frac{1}{2}'' = 1 \text{ Foot.}$



6/22
© 2021
Pas. 11.
18/18/92.
Lloyd's Register
Foundation
via 224-0000

R. Duncan & Co's

No. 167.

"Morven"

Greenock Report No...

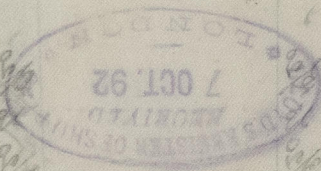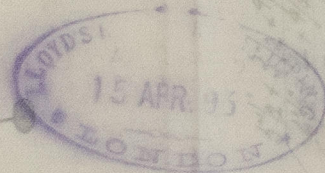

© 2021

Lloyd's Register
Foundation