

Lloyd's Register of British and Foreign Shipping.

(Report on Vessel No. ¹⁰⁷⁶⁸ 262

Port

Glasgow

No. 3807

SHIP FORGINGS OR CASTINGS.

The words FORGINGS or CASTINGS, IRON or STEEL, should be struck out as may be required.

I have to report that the undermentioned Iron or Steel Forgings or Castings, manufactured by
Messrs Robt Kerr & Sons of Glasgow
 for the Vessel No. 262, being built by Messrs Robt Duncan & Co
 of Port Glasgow have been inspected by me as set forth below, and found
 to be, so far as can be seen, Sound & efficient

Mark on Forgings.

Lloyd's

No. 3807


W. H.

William Hamilton

Glasgow
7/2/93

	STERN FRAME.	RUDDER FRAME.	STEM.
Material* - - - -	/	Scrap iron	/
How made - - - -		Forged	
Dimensions - - - -		1 1/2 to 3 3/4	
Progress on Inspection -		Forging & smithing	
Dates when Inspected		13. 19/11/92. 19. 26/11/92 2. 7. 12/12/92. 26. 31/1/93 6/2/93	

SKETCHES OF FRAMES SHEWING POSITION AND DESCRIPTION OF WELDS OF FORGINGS, OR PARTICULARS OF TESTS APPLIED TO CASTINGS.

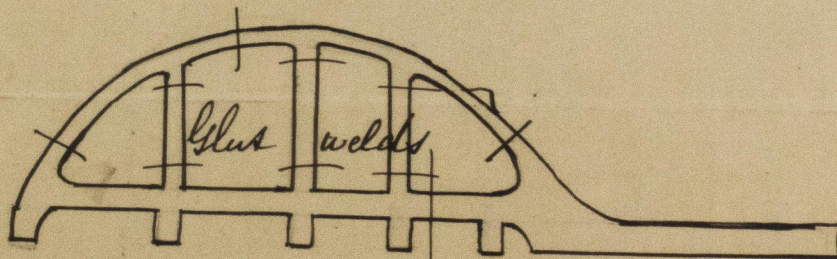

Scarf weld

Not partly done

LOYD'S REGISTER
Lloyd's Register of British
and Foreign Shipping.

Port

Greenock.

14th April 1893.

Sir,

We beg to forward herewith
the tracing of Midship Section of the
ship "*Morven*,"
built by Messrs. Robt. Duncan & Co. Ltd.
(Yard No. *262*) for the preparation of
the first entry Certificate of Class.

The report of survey on the vessel
will be forwarded in a few day's time.

We are, Sir,

Your obedient Servants,
for the Surveyors,
Alex. M. McCallan.

The Secretary,

Lloyd's Register, London.