

20:8:92

Main Deck


Loucasle

"Moroc"
Grunck Report No. 10768.

Iron Deck Plan

Ship N^o 262

Scale 1/4 in = 1 foot

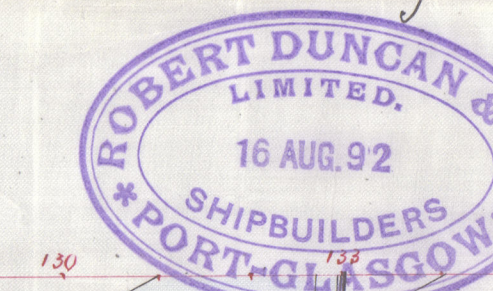

Panting Stringer

Sam.
7/1/92

R Duncan & Co

No 967

"Morven" ^{alpha}

G.K. Rept. No. 10768.

G.K. 524-00 23

Iron Deck Plan

Ship No 505

Donnell

Revised
"Morven"
G.K. Rept. No. 10768.



© 2021

Lloyd's Register
Foundation