



Midship Section  
eg barrow  
No 323  
Scale 1/2 inch - one foot

Kinross Shire:  
Greenock Repd. 20. 10799.

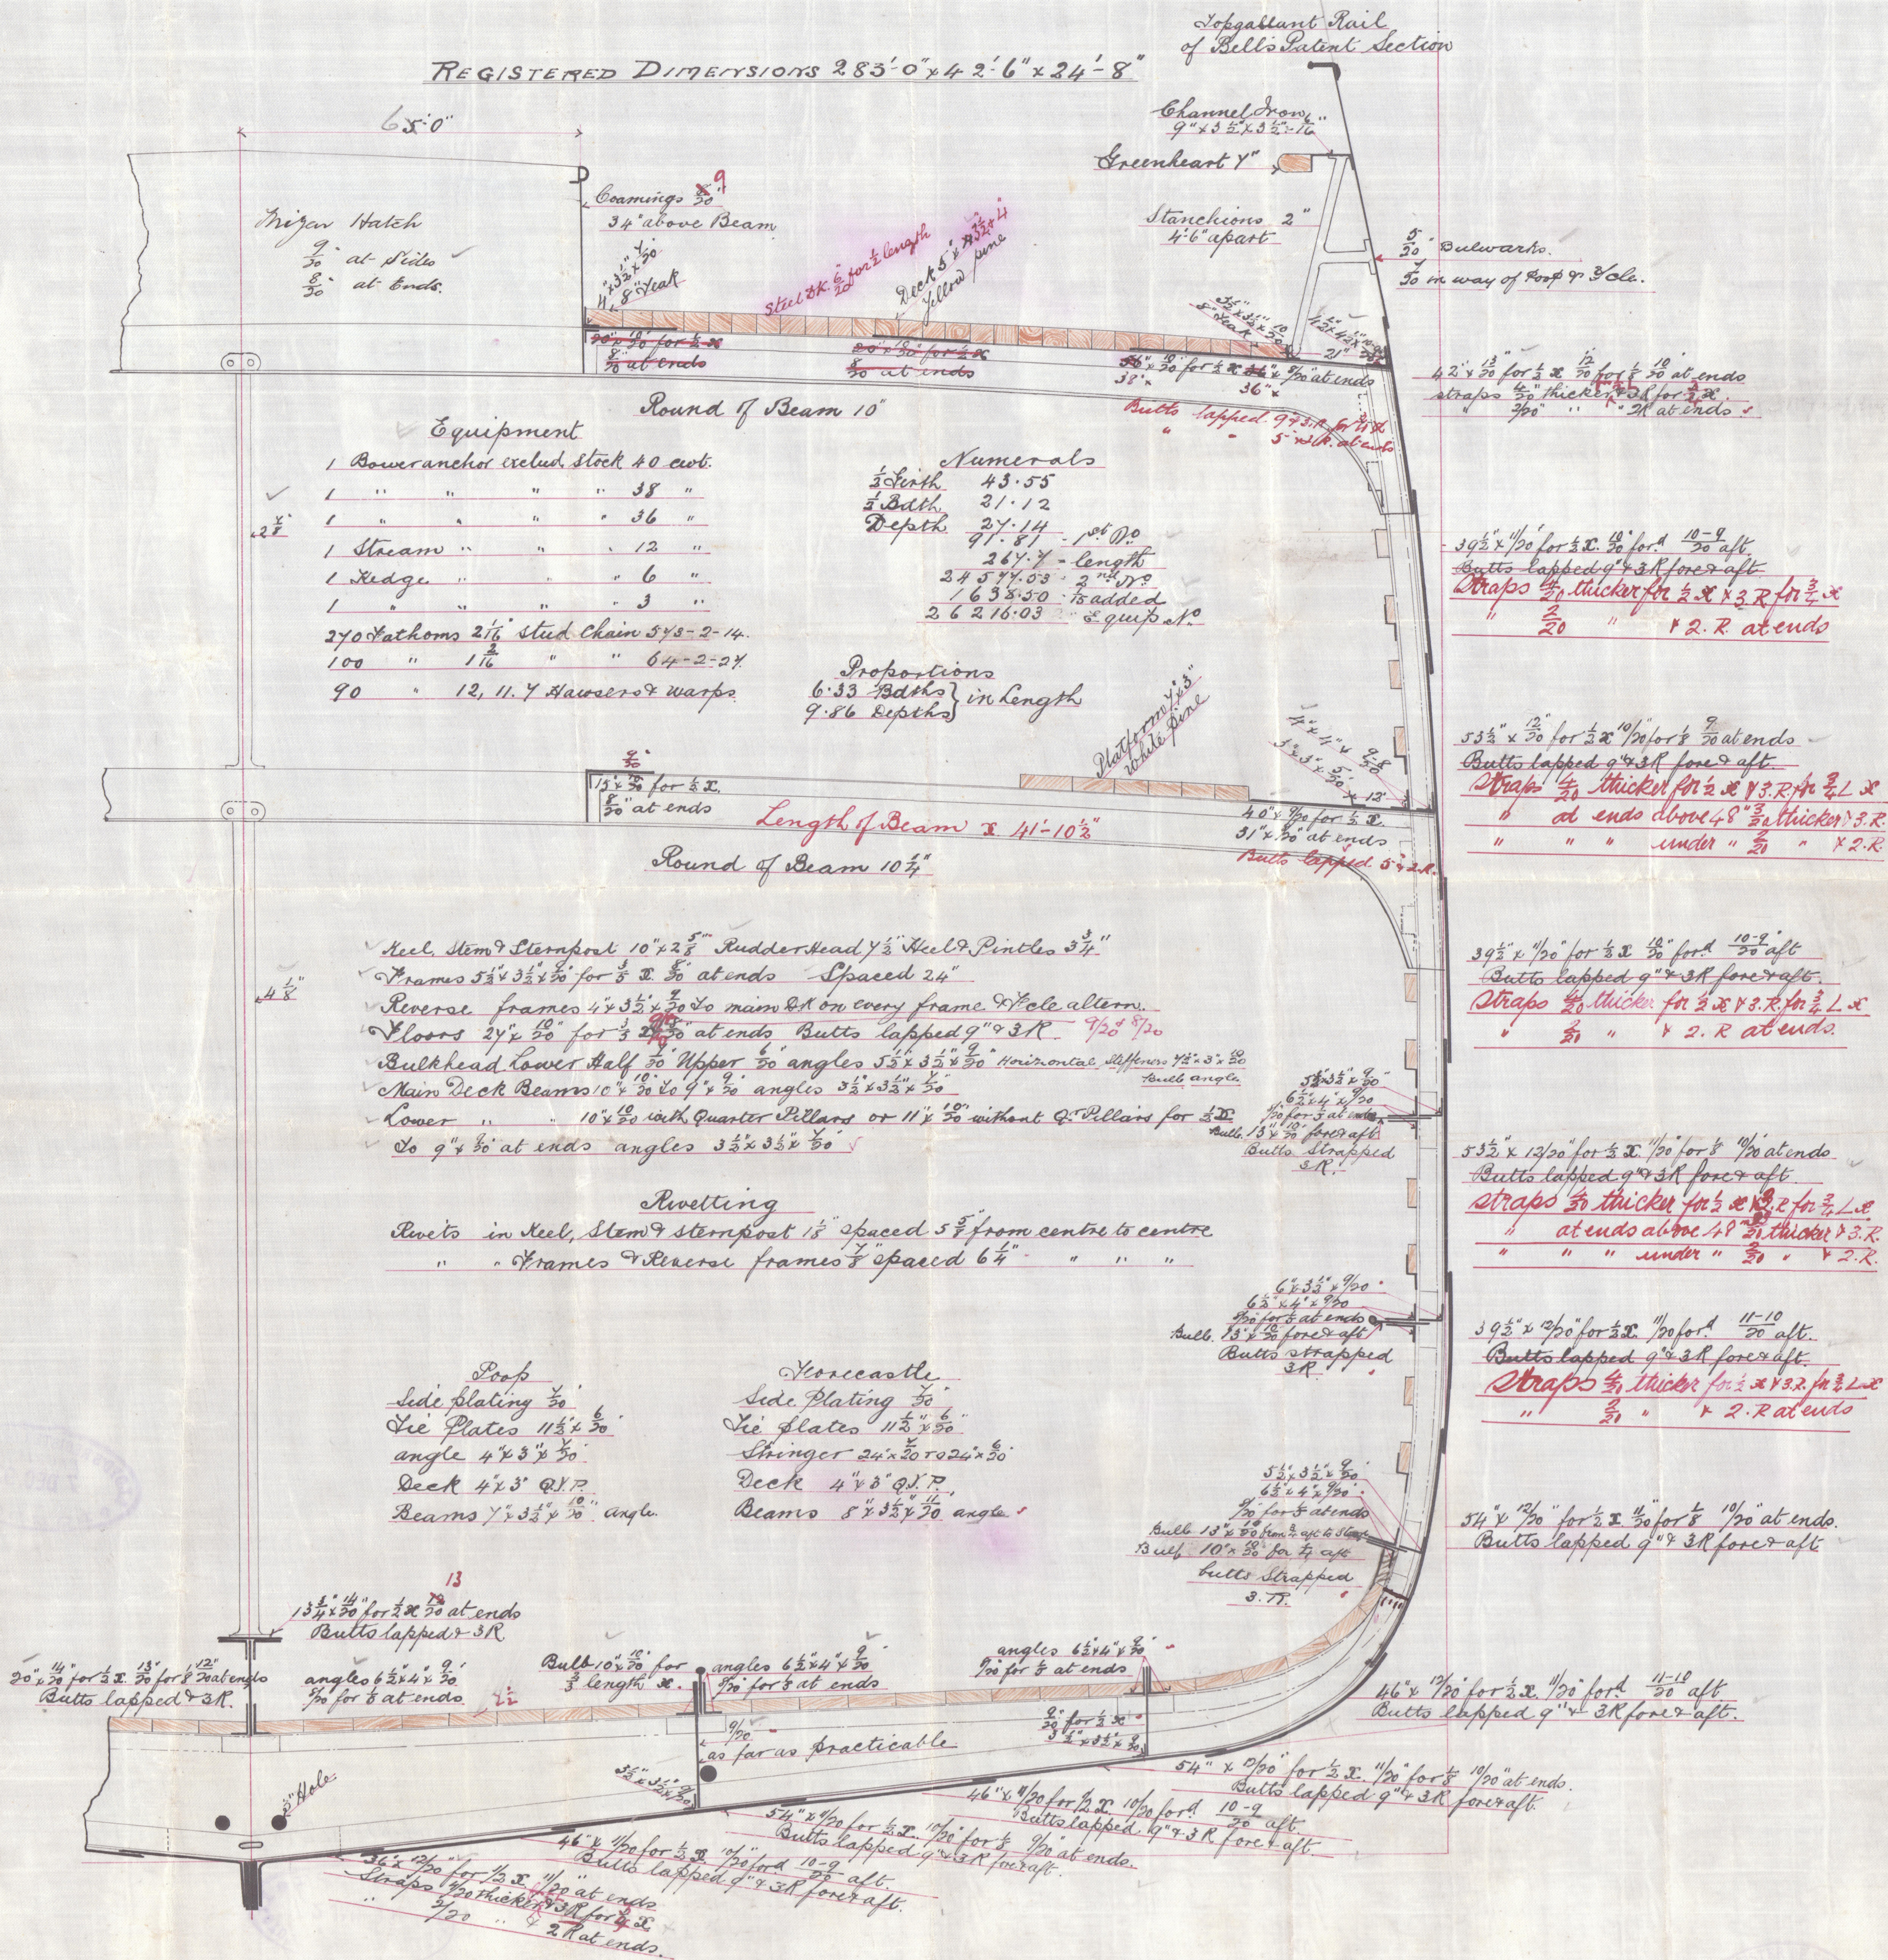

Russell & Coys  
No. 373  
"Kinnross-shire".  
GPK. Rept. No. 10799.

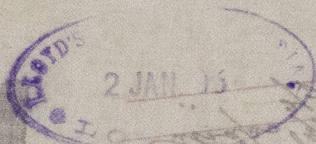

GRH324-0085



© 2021

Lloyd's Register  
Foundation