

*Kinross-shire?*

Received at

Office,

78

## Lloyd's Register of British and Foreign Shipping.

(Report on Vessel No. <sup>10799</sup> *323*)

Port

*Glasgow*No. *3949*

## SHIP FORGINGS OR CASTINGS.

I have to report that the undermentioned Iron or Steel Forgings or Castings, manufactured by

*The Irvine Forge Coy*

of

*Irvine*for the Vessel No. *323*,

being built by

*Messrs Russell & Coy*of *Port Glasgow*

have been inspected by me as set forth below, and found

to be, so far as can be seen, *Sound & efficient*

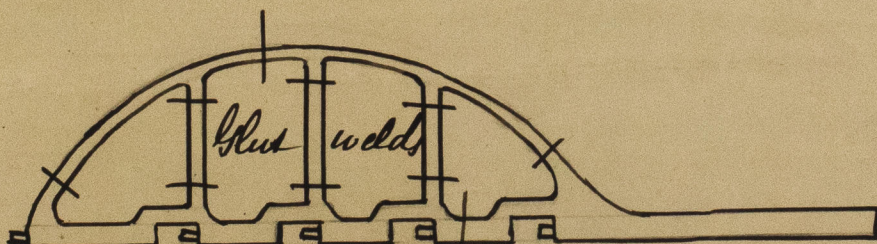
Mark on Forgings.

Lloyd's

No. *3949**W. H.**William Hamilton**Glasgow**7/4/93*

	STERN FRAME.	RUDDER FRAME.	STEM.
Material* . . . .	/	<i>Scrap iron</i>	/
How made . . . .		<i>Forged</i>	
Dimensions . . . .		<i>7 1/2 ft to 3 3/4</i>	
Progress on Inspection .		<i>Forging &amp; smithing</i>	
Dates when Inspected		<i>3. 17. 10. 23. 28. 29/3/93</i> <i>5/4/93</i>	

SKETCHES OF FRAMES SHEWING POSITION AND DESCRIPTION OF WELDS OF FORGINGS, OR PARTICULARS OF TESTS APPLIED TO CASTINGS.

*Searf weld*

© 2019

Lloyd's Register

Foundation

\* If of Iron, state whether scrap or puddled Iron.

*GRH324 0089*