


Alameda  
 Grd. Rept. No. ....  
 See Section letter  
 of May 1893  
 Re: upper edge of stanchion

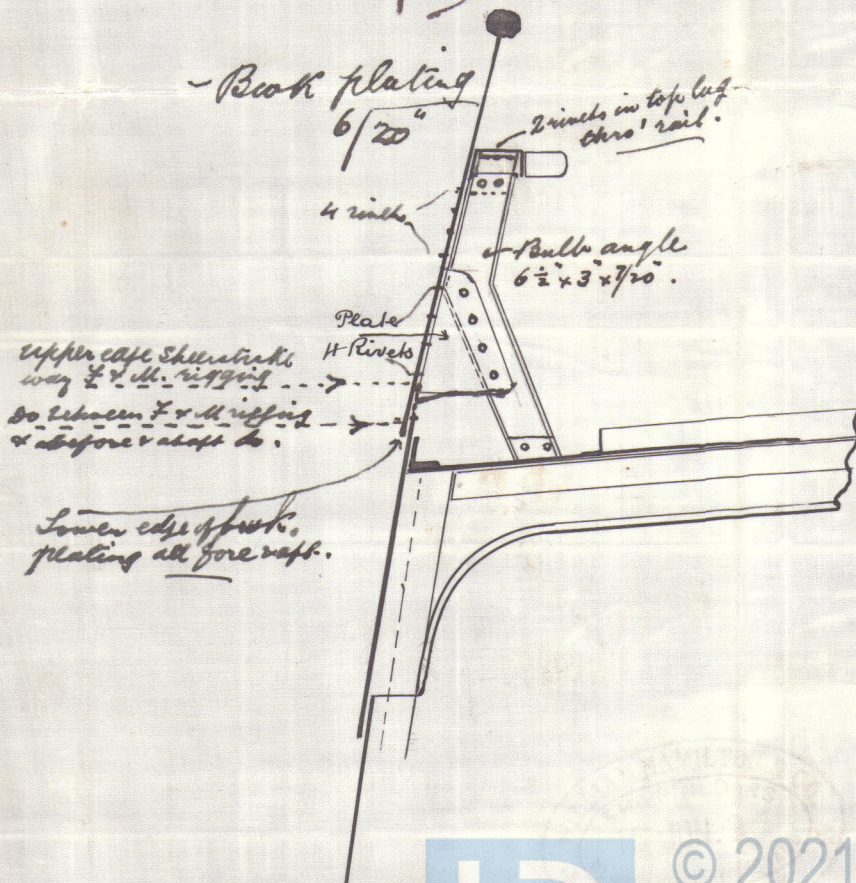

Five of the bulwark stanchions fitted  
 as shown above, on each side of vessel;  
 one at fore and after ends of fore and  
 main rigging respectively and one in space  
 between fore & main rigging. C.B.