


24.12.92.

"Aurora"
Gunnels Report No. 10873



RIGGING PLAN
BARQUE N° 108
SCALE 1/8 INCH = ONE FOOT
PLATING N° 21010
U.D. TONNAGE about 1740

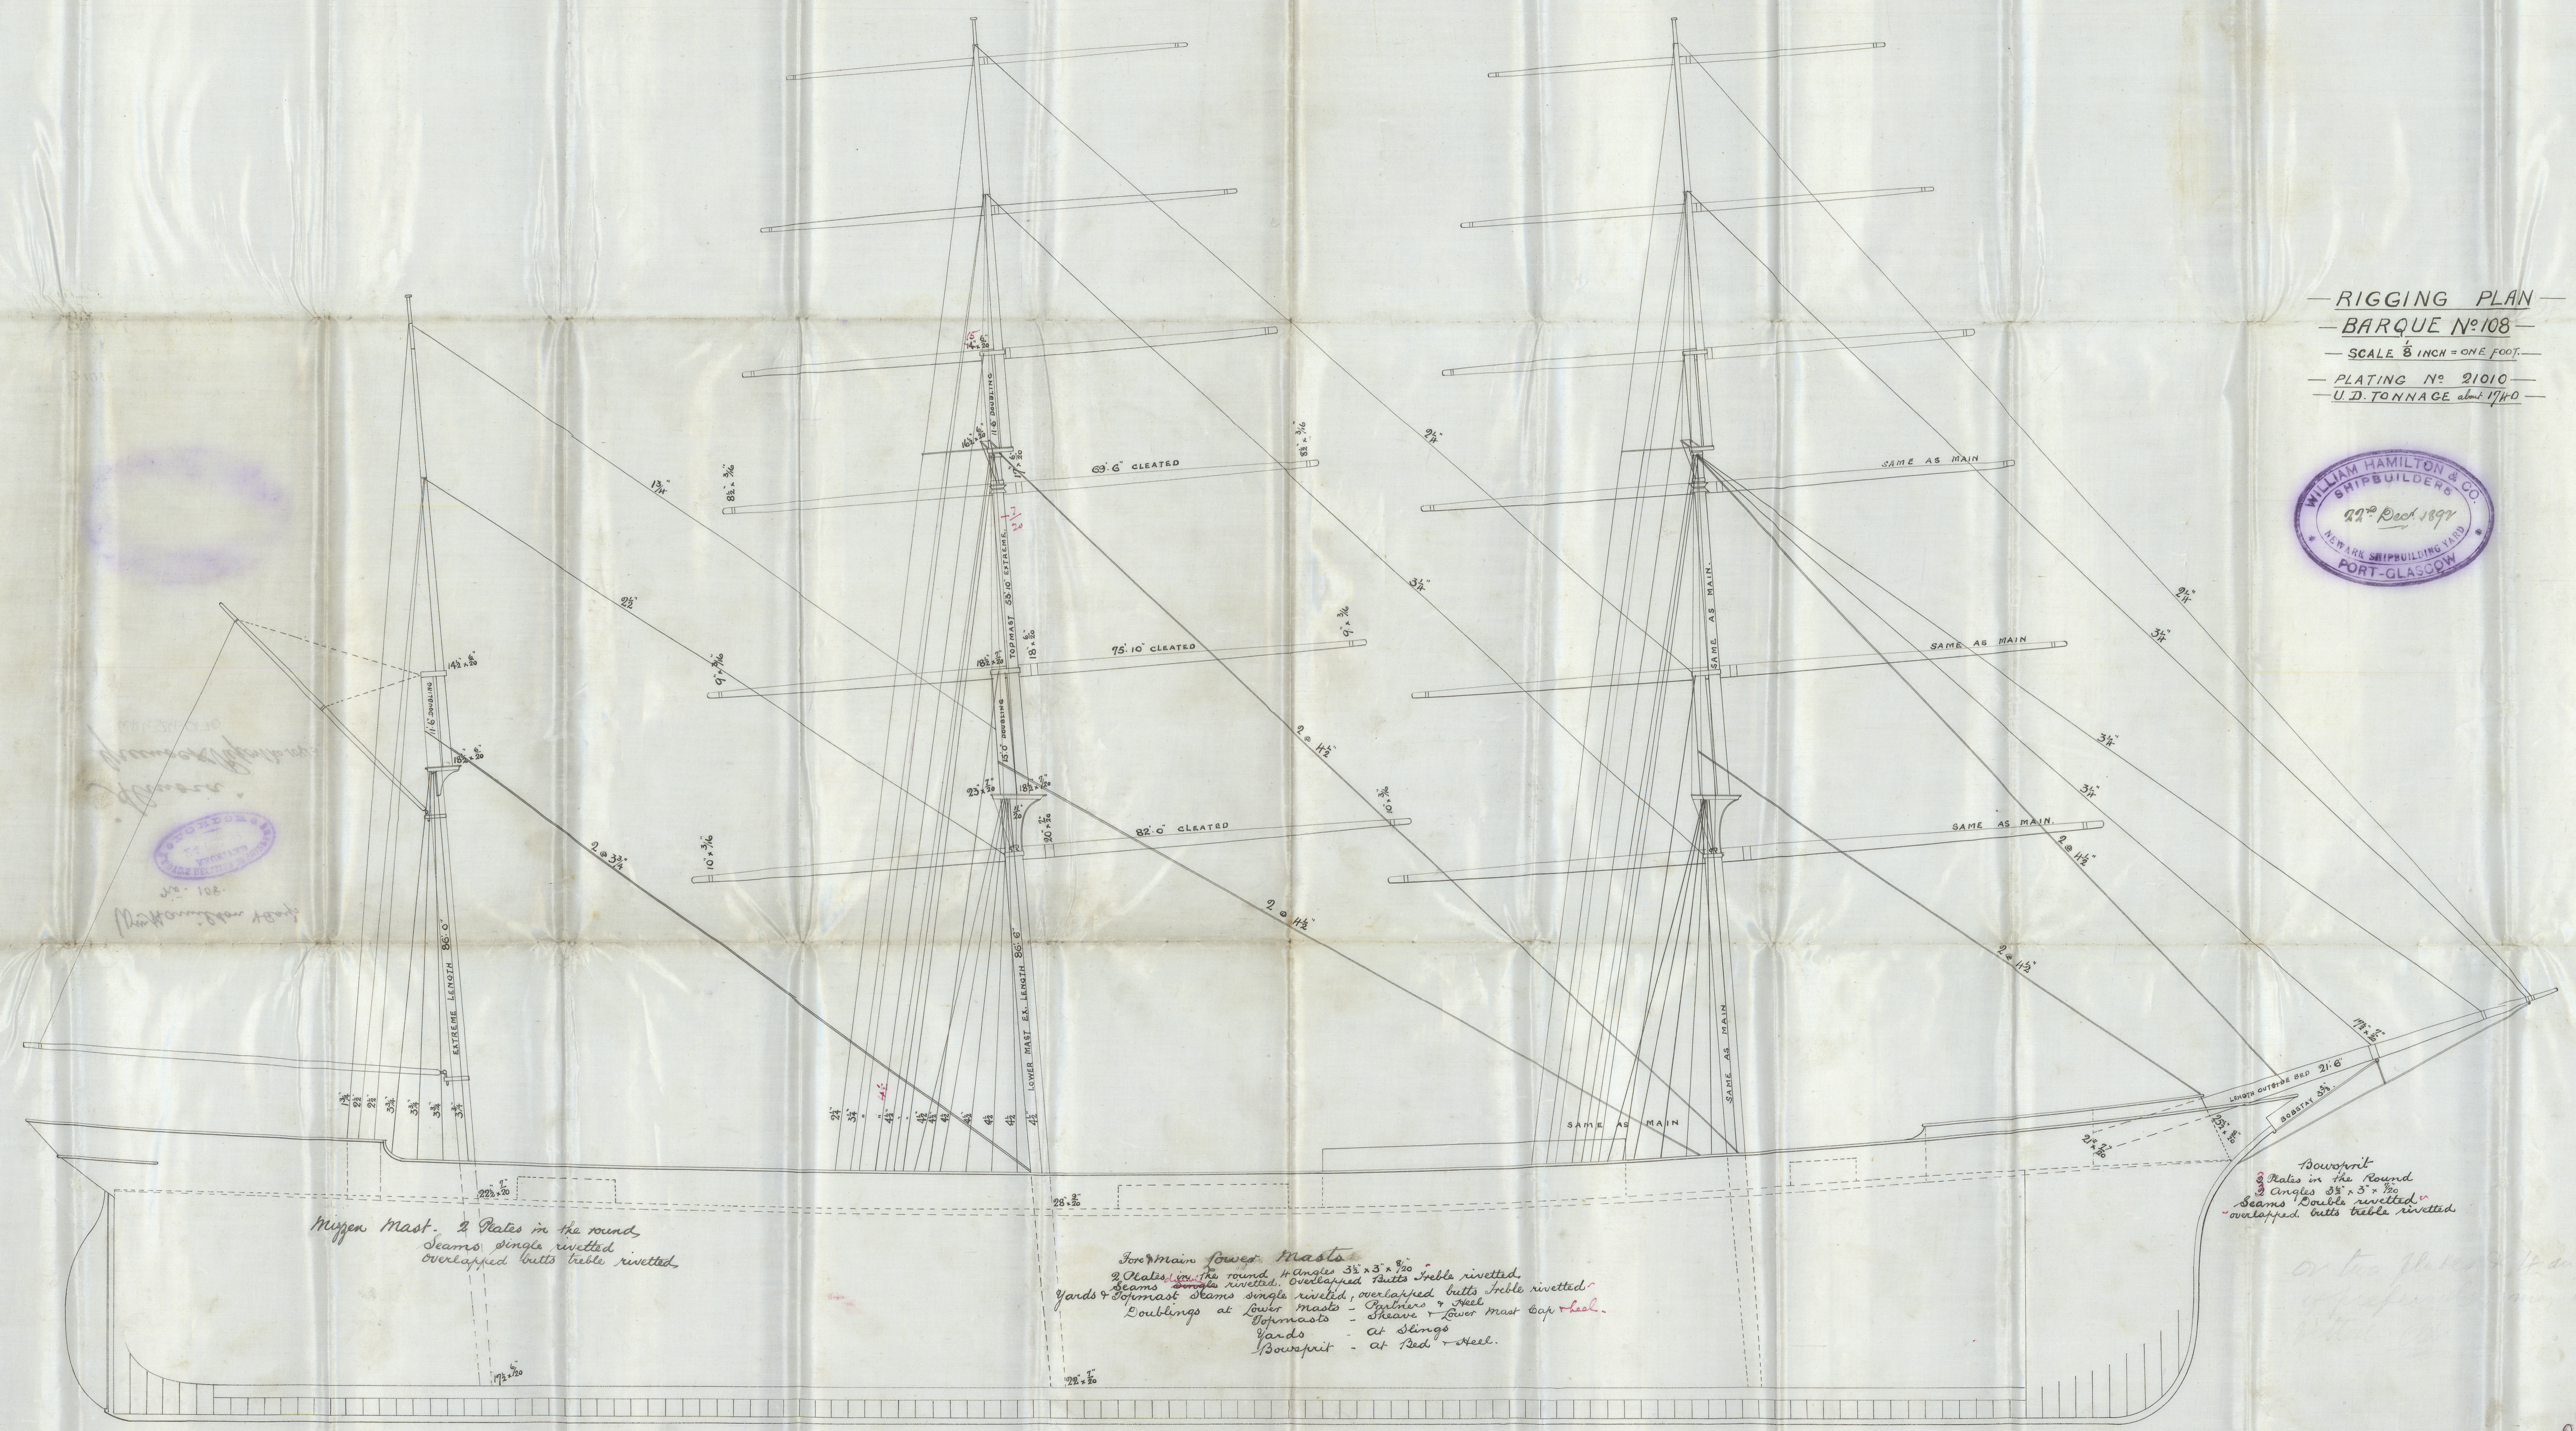

Mizzen Mast. 2 Plates in the round.
Seams single rivetted
overlapped butts triple rivetted.

For Main & Fore Masts
Seams single rivetted. Overlapped butts triple rivetted.
Yards & Foremast. Seams single rivetted, overlapped butts triple rivetted.

Bowsprit
3 Plates in the Round
Angles 33' x 3' x 3/4"
Seams Double rivetted
overlapped butts triple rivetted

Wm Hamilton & Co's


No. 108.



Amora

Grunoek Report No. 10813.

WRH324-0170

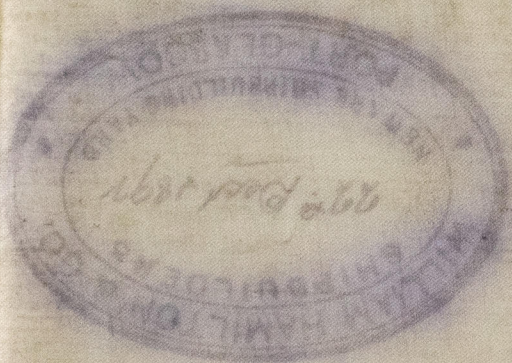


© 2021 Lloyd's Register Foundation