


TO CLASS A AT LLOYDS  
"FOR RIVER PURPOSES ONLY"

LENGTH BETWEEN PERPS	150.5
DEPTH FROM TOP OF KEEL TO MAIN DK.	10.6
HALF BREADTH AT MAIN DK.	16.6
HALF GIRTH MOULDED	22.5

ANCHORS 2 BOWERS STOCKLESS EACH 10 CWT.  
1 KEDGE EX STOCK 1 3/4 "  
1 " " " 3/4 "  
CABLES 120 FATHOMS 15  
50 " 16 STUD CHAIN CABLE  
50 " 3/4 STREAM CHAIN

26.5.93.  
30.5.93.

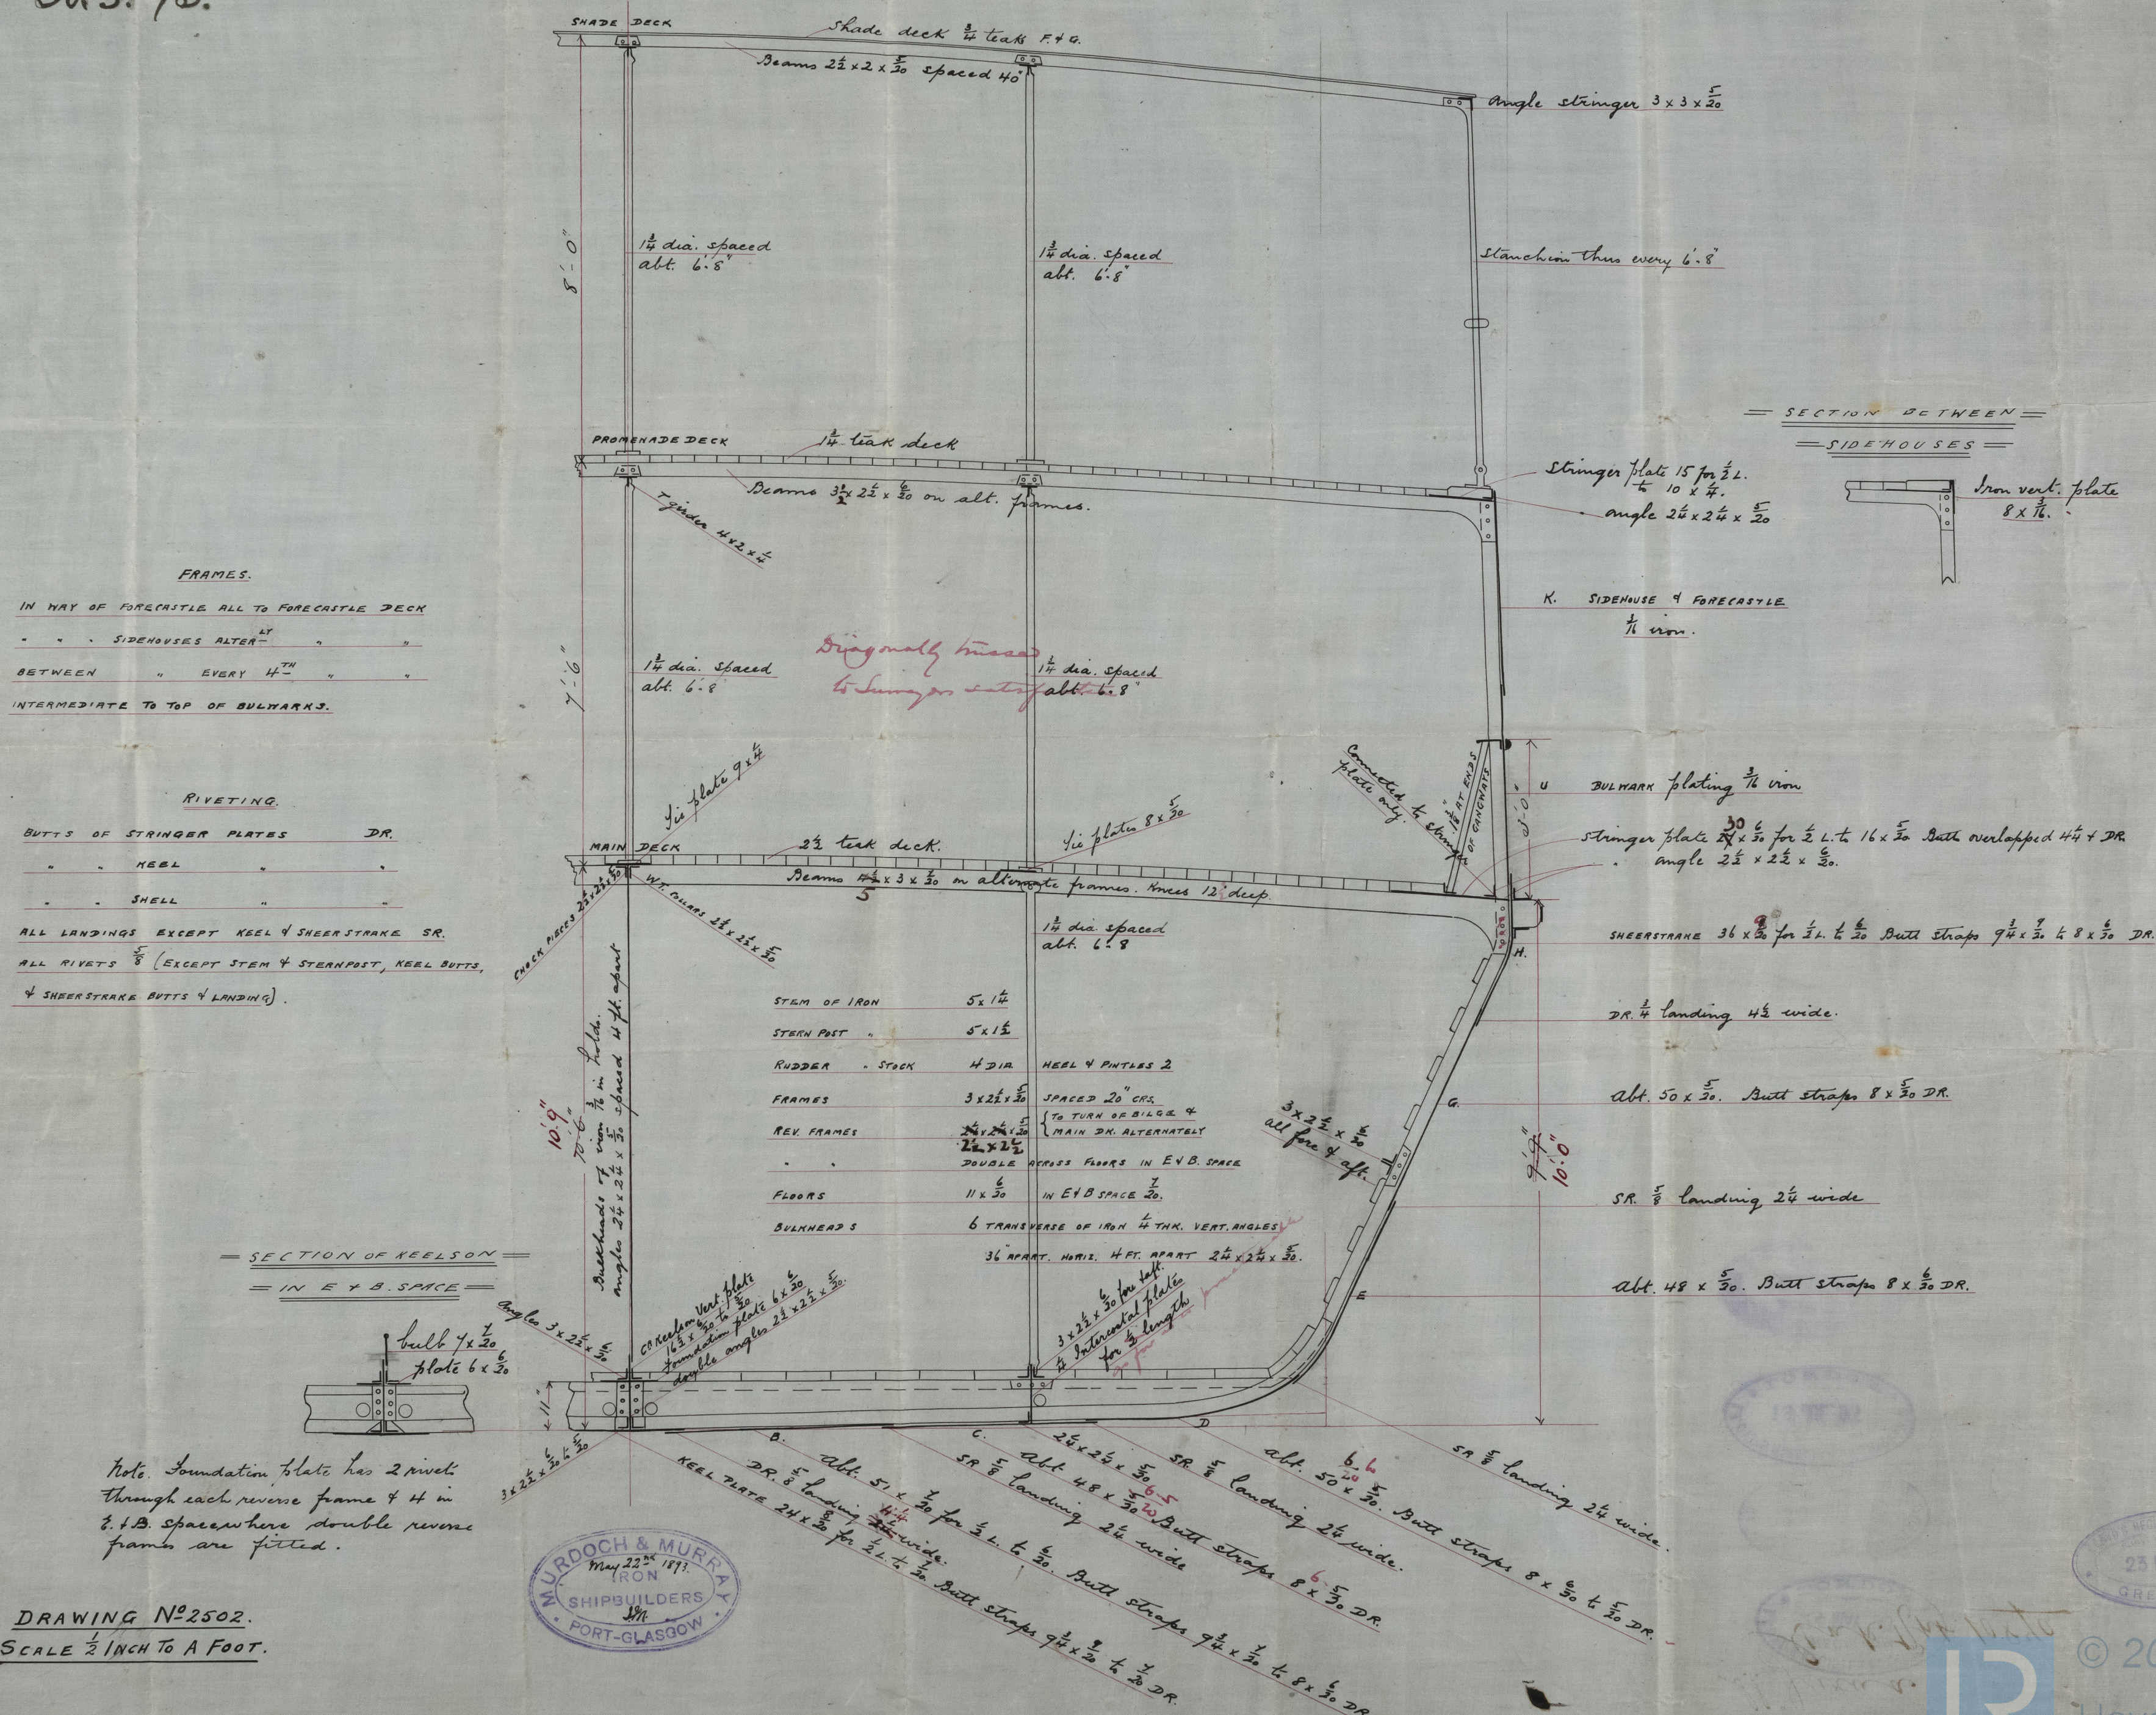

DRAWING N<sup>o</sup> 2502.  
SCALE  $\frac{1}{2}$  INCH TO A FOOT.

Lloyd's Register  
CATH 325-0152  
Foundation






Meredock & Murray's.


No. 132.

Sl. "Jura"

Chk. N<sup>o</sup>. 10840

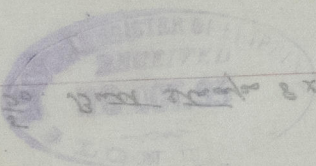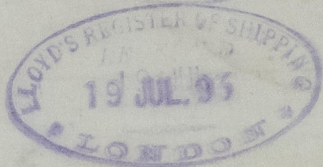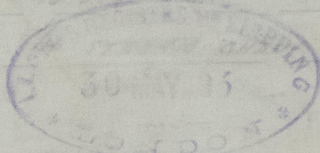

APR 325-0152

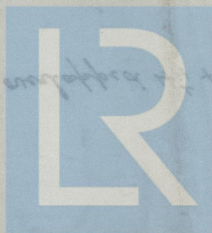

© 2020

Lloyd's Register  
Foundation