

1. 2 "Jurnal."

Received at

Office,

189

Lloyd's Register of British and Foreign Shipping.

(Report on Vessel No. *10870* Port *Greenock*.)

No. *4181* SHIP FORGINGS ~~OR CASTINGS~~

I have to report that the undermentioned Iron ~~or Steel~~ Forgings ~~or Castings~~,
manufactured by *Messrs Robt Kerr & Sons*
of *Irvine* for the Vessel No. *132*, being built
by *Messrs Murdoch & Murray* of *Port Glasgow*
have been inspected by me as set forth below, and found to be, so far as can be seen,
Sound & efficient

Mark on Forgings.

Lloyd's


No. *4181*
W.H.

William Hamilton

Glasgow 6/9/93

	STERN FRAME.	RUDDER FRAME.	STEM.
Material*		<i>Scrap iron</i>	
How made		<i>Forged</i>	
Dimensions		<i>4 to 2 in</i>	
Progress on Inspection		<i>Forging & smithing</i>	
Date when Inspected		<i>22. 25/8/93</i>	

SKETCHES OF FRAMES SHOWING POSITION AND DESCRIPTION OF WELDS OF FORGINGS, OR PARTICULARS OF TESTS APPLIED TO CASTINGS.

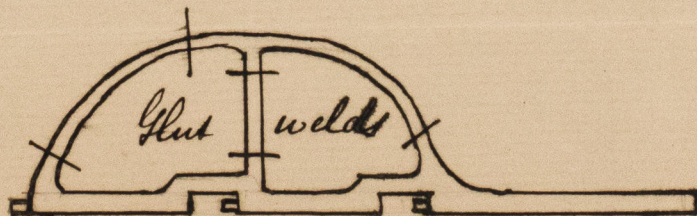

© 2019

Lloyd's Register

Foundation

* If of Iron, state whether scrap or puddled Iron.

WHS 25-0161