




"Jura".  
Greenock Report No. 16870

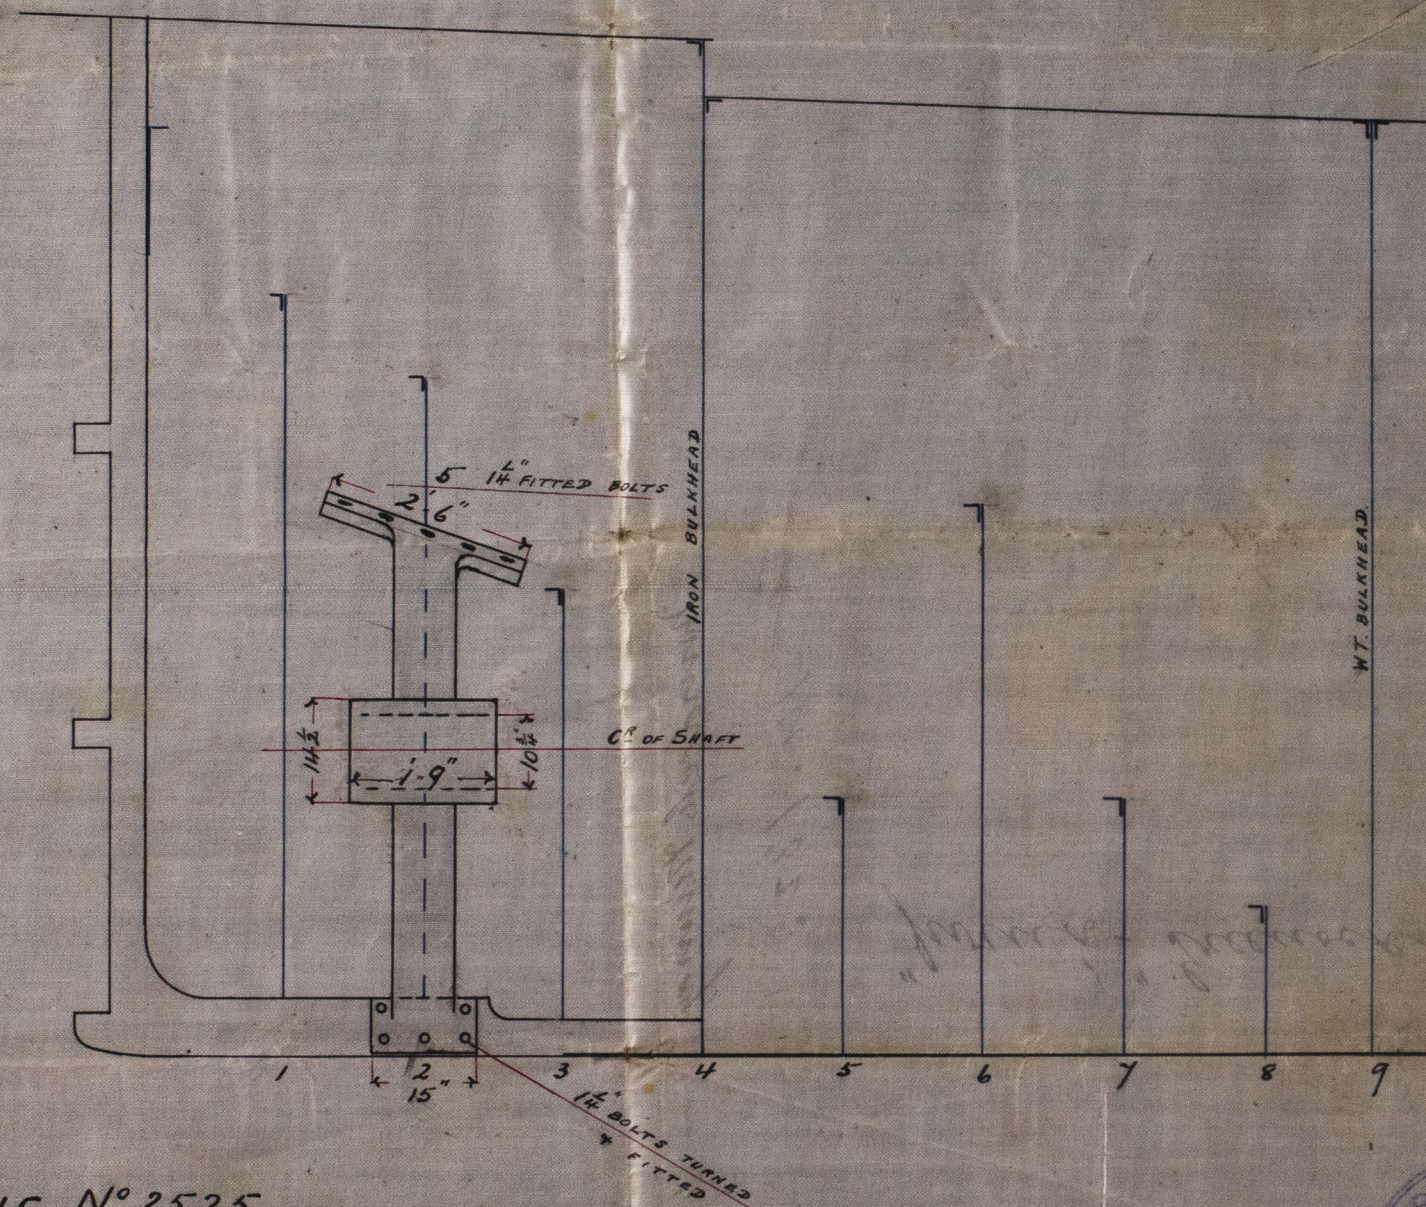

DRAWING N° 2525  
SCALE  $\frac{1}{2}$  INCH TO A FOOT.

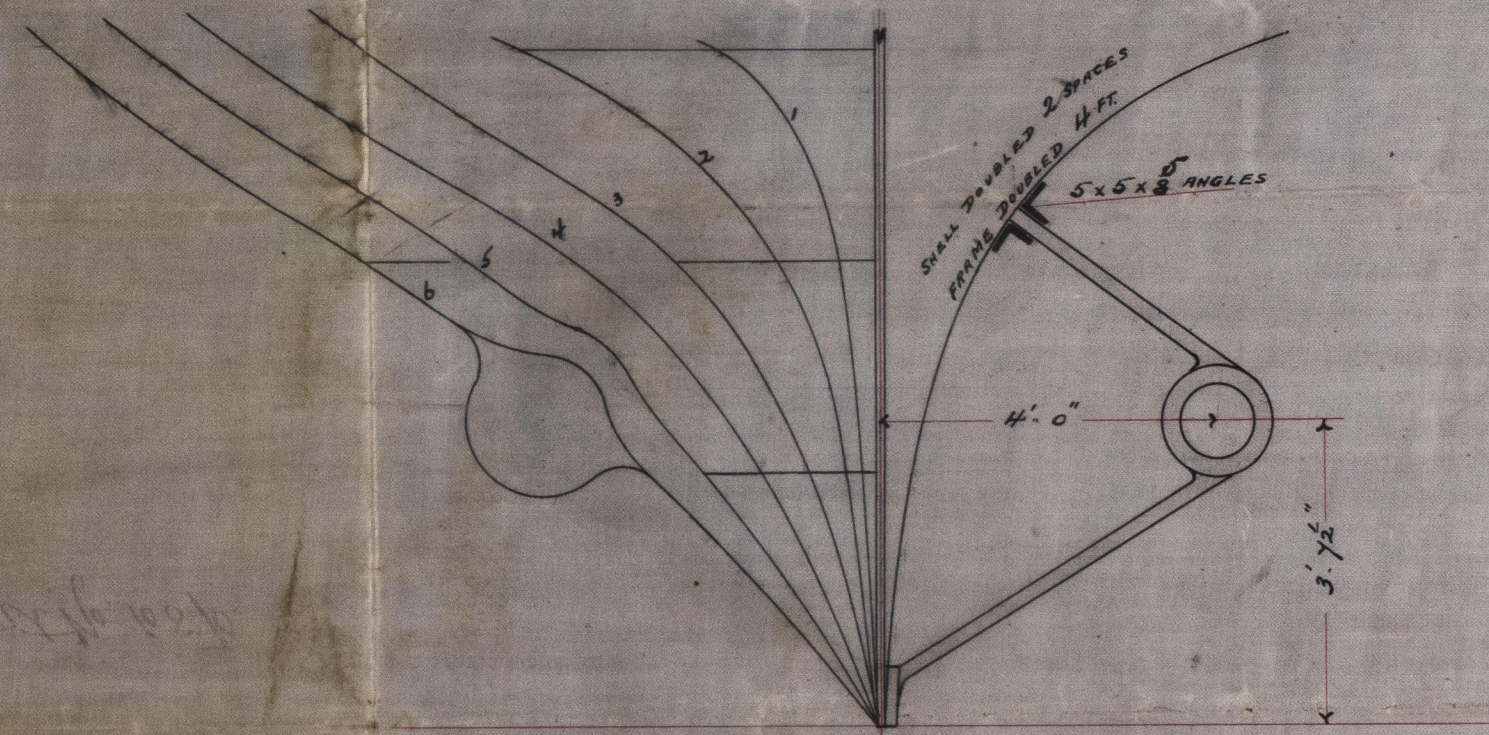


PLAN OF SHAFT BRACKETS  
T.S.S. N° 132.  
(CAST STEEL)

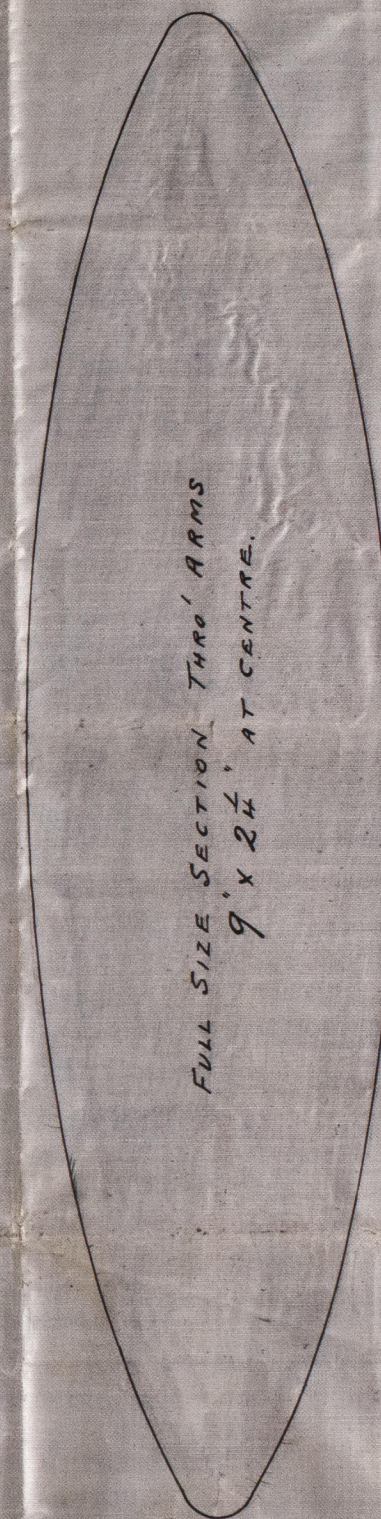

Lloyd's Register  
Foundation



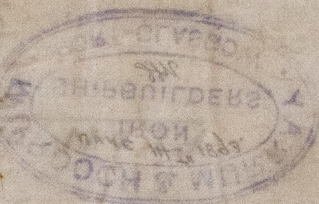

Murdock Murray

No. 132.

"Juana" - Greenock Report No. 10870.

GRW325 0162



© 2019

Lloyd's Register  
Foundation