

Lloyd's Register of British and Foreign Shipping.

(Report on Vessel No. *10915* Port *Greenock*)No. *1744*

SHIP FORGINGS OR CASTINGS.

I have to report that the undermentioned Iron ~~or Steel~~ Forgings ~~or Castings~~,
 manufactured by *The Jarrow Foyer & Co*
 of *Jarrow* for the Vessel No. *341*, being built
 by *Messrs Russell & Co* of *Greenock*
 have been inspected by me as set forth below, and found to be, so far as can be seen,
Sound



Mark on Forgings.

Lloyd's

No. *2638B**86**John C Craig**Newcastle**28/10/93*

	STERN FRAME.	RUDDER FRAME.	STEM.
Material*	<i>Scrap Iron</i>	<i>Scrap Iron</i>	<i>Scrap Iron</i>
How made	<i>Forged</i>	<i>Forged</i>	<i>Forged</i>
Dimensions	<i>10 - 25/8</i>	<i>7 - 3 1/2</i>	<i>10 - 25/8</i>
Progress on Inspection	<i>Forged & Smithed</i>	<i>Forged & Smithed</i>	<i>Smithed</i>
Date when Inspected	<i>June 8-15-26-27 July 4-11</i> <i>14/93</i>	<i>July 19-22 Aug 16-24</i> <i>Sept 25-27/93</i>	<i>July 14/93</i>

SKETCHES OF FRAMES SHOWING POSITION AND DESCRIPTION OF WELDS OF FORGINGS, OR PARTICULARS OF TESTS APPLIED TO CASTINGS.

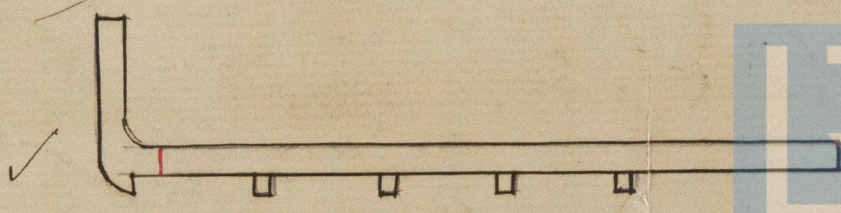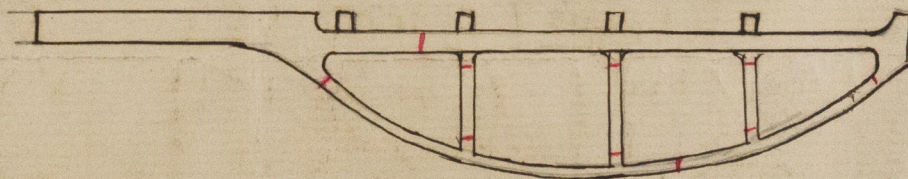

* If of Iron, state whether scrap or puddled Iron.