


'King George'
Launch Report No 10915

28.6.93.
1.7.93

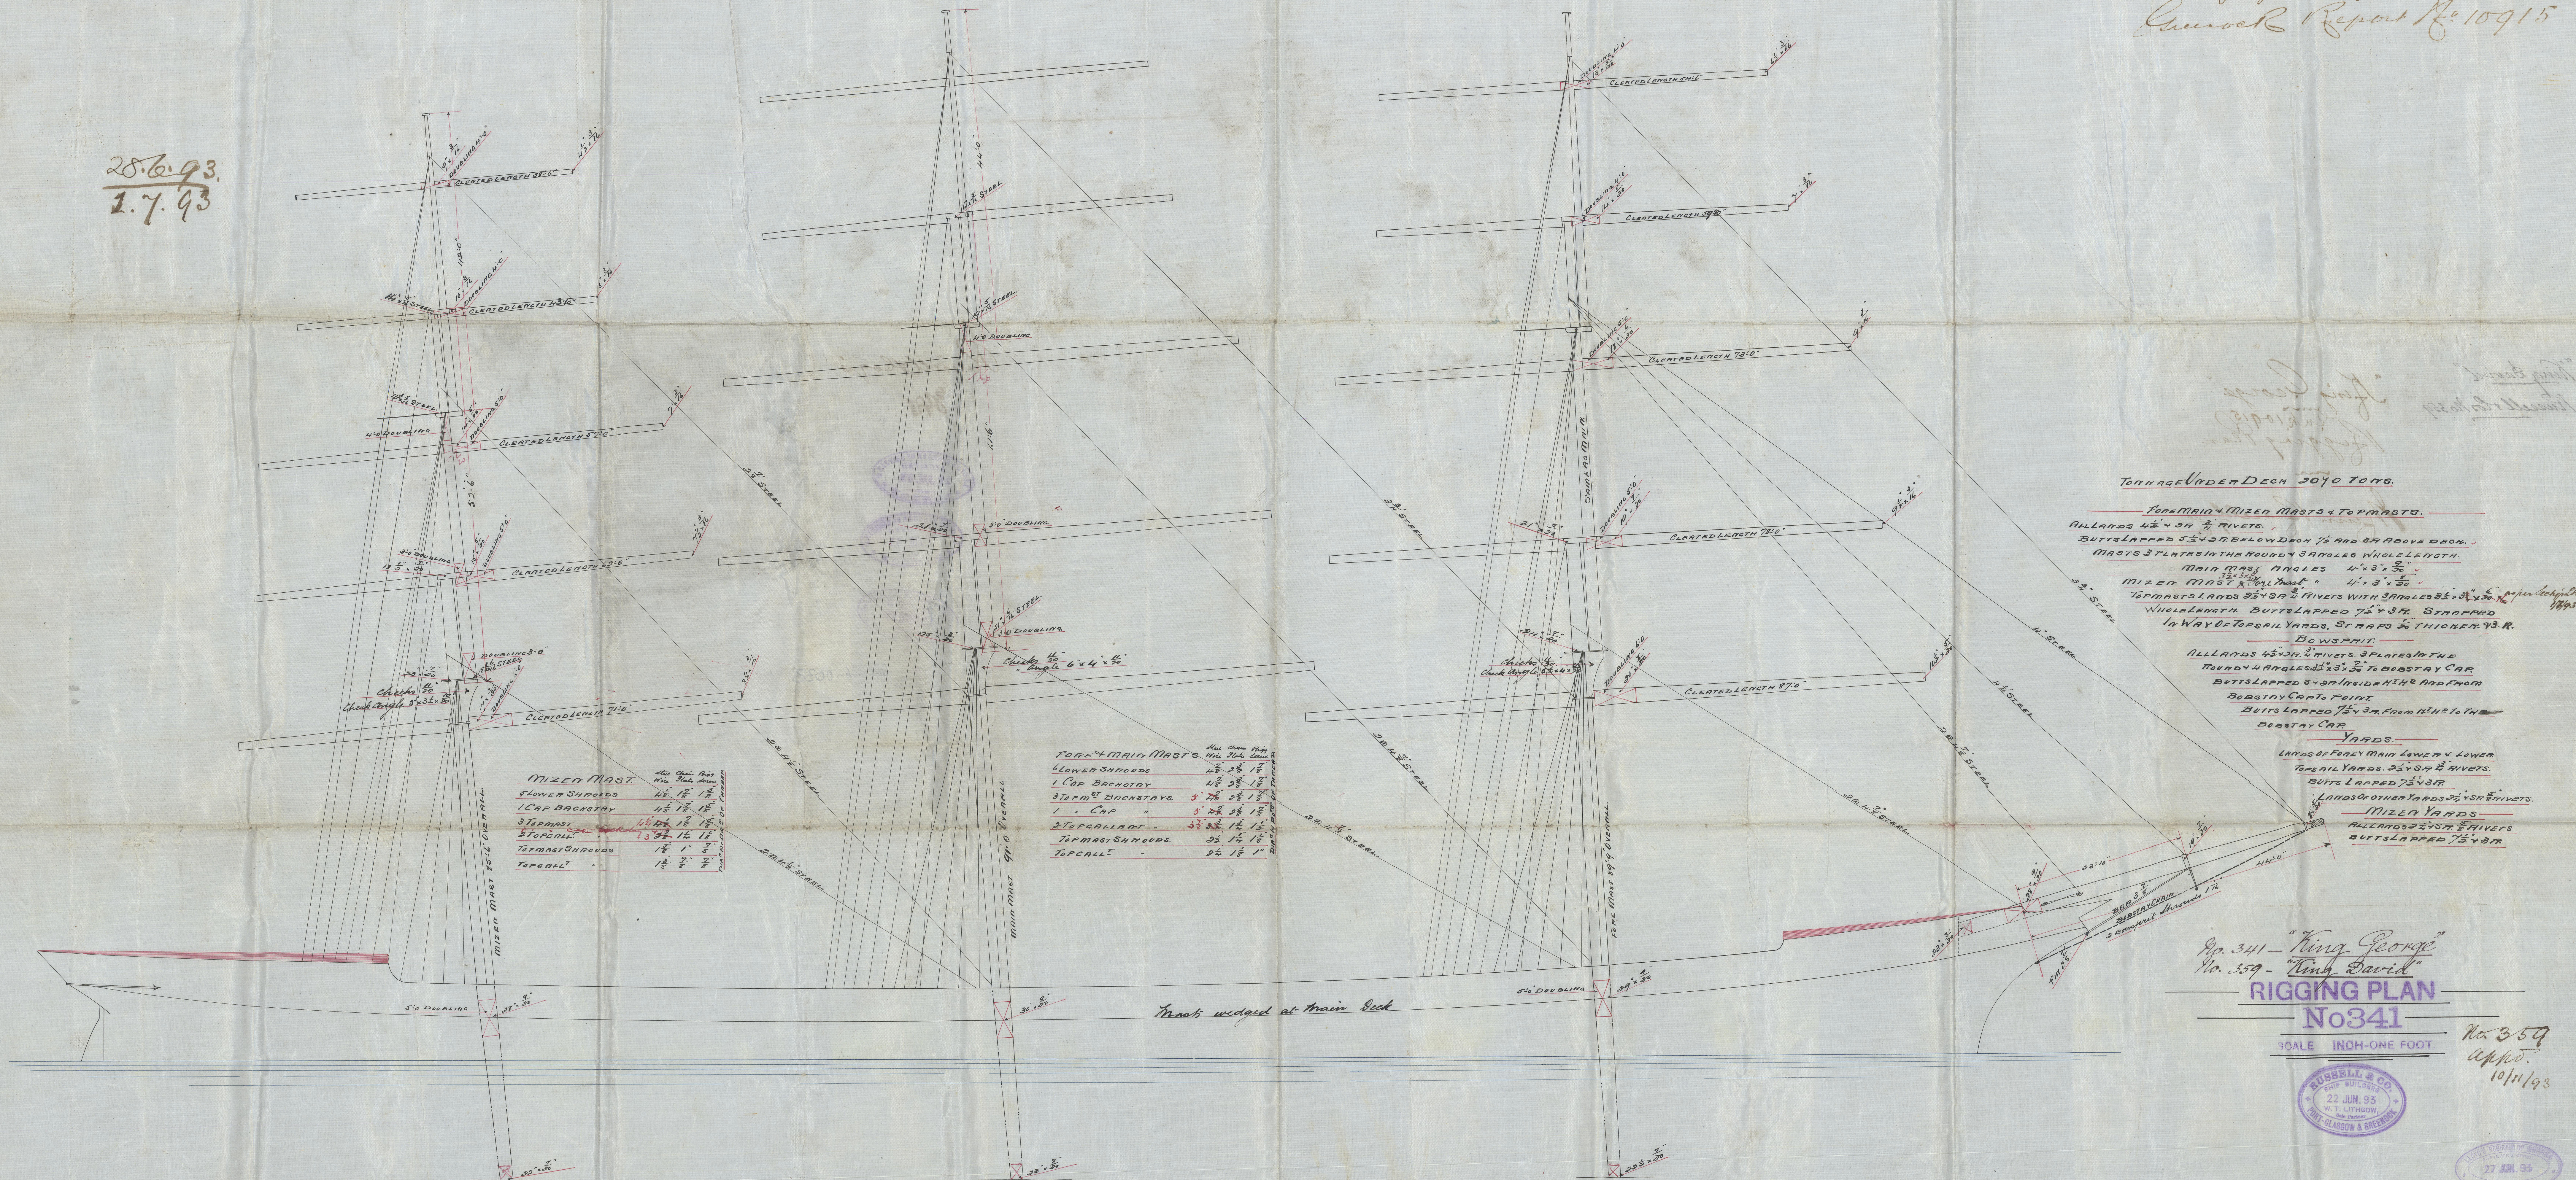

No 341 - "King George"
No 359 - "King David"
RIGGING PLAN
No 341

SCALE INCH-ONE FOOT



No 359
App'd.
10/11/93



George's Report No 10915

18.6.93.
27.93

"King David"
Russell & Co No 359

"King George"
Russell & Co No 10915
Rigging Plan

Russell & Co

RIGGING PLAN
No 341


SCALE 1 INCH = ONE FOOT

No 359
10/11/93



© 2020
Lloyd's Register
Foundation

Russell & Coys
3411

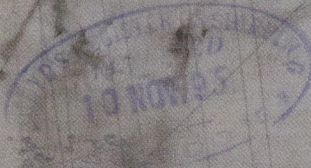

GRK 326-0033

