

Received at

Greenock office 31<sup>st</sup> January 1894

## Lloyd's Register of British and Foreign Shipping.

Greenock (Report on Vessel No. 10966 Port Greenock)

## No. 2656.a. SHIP FORGINGS OR CASTINGS.

I have to report that the undermentioned Iron or Steel Forgings or Castings, manufactured by Imp<sup>r</sup> G & W Reed Co. of Sunduland for the Vessel No. 37, being built by The Campbeltown S & Co. of Campbeltown have been inspected by me as set forth below, and found to be, so far as can be seen, sound.


Mark on Forgings.

Lloyd's

No. 2656.a  
R.C.Hugh Cameron  
Sunduland  
30.1.94

	STERN FRAME.	RUDDER FRAME.	STEM.
Material* ...	Scrap iron	Scrap iron	Scrap iron
How made ...	Faged	Faged	Faged
Dimensions ...	8 1/2 x 5'	7 - 3 1/2	8 1/2 x 2 1/2
Progress on Inspection	Faged Smoothed	Faged Smoothed	Faged
Date when Inspected	Nov 11 N to Dec 4/93	Dec 9/93 to Jan 25/94	Dec 4/93

SKETCHES OF FRAMES SHOWING POSITION AND DESCRIPTION OF WELDS OF FORGINGS, OR PARTICULARS OF TESTS APPLIED TO CASTINGS.

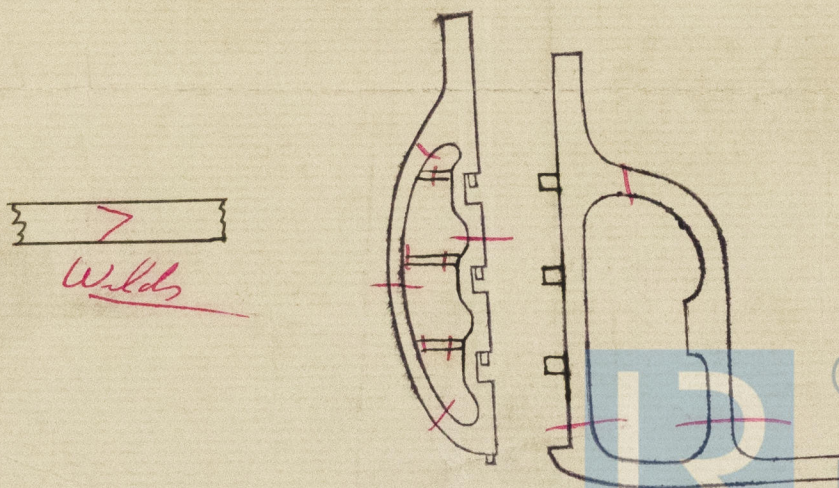

© 2019

Lloyd's Register  
Foundation