


See also to
 G.R.K. 27.12.93.
 2000-558192

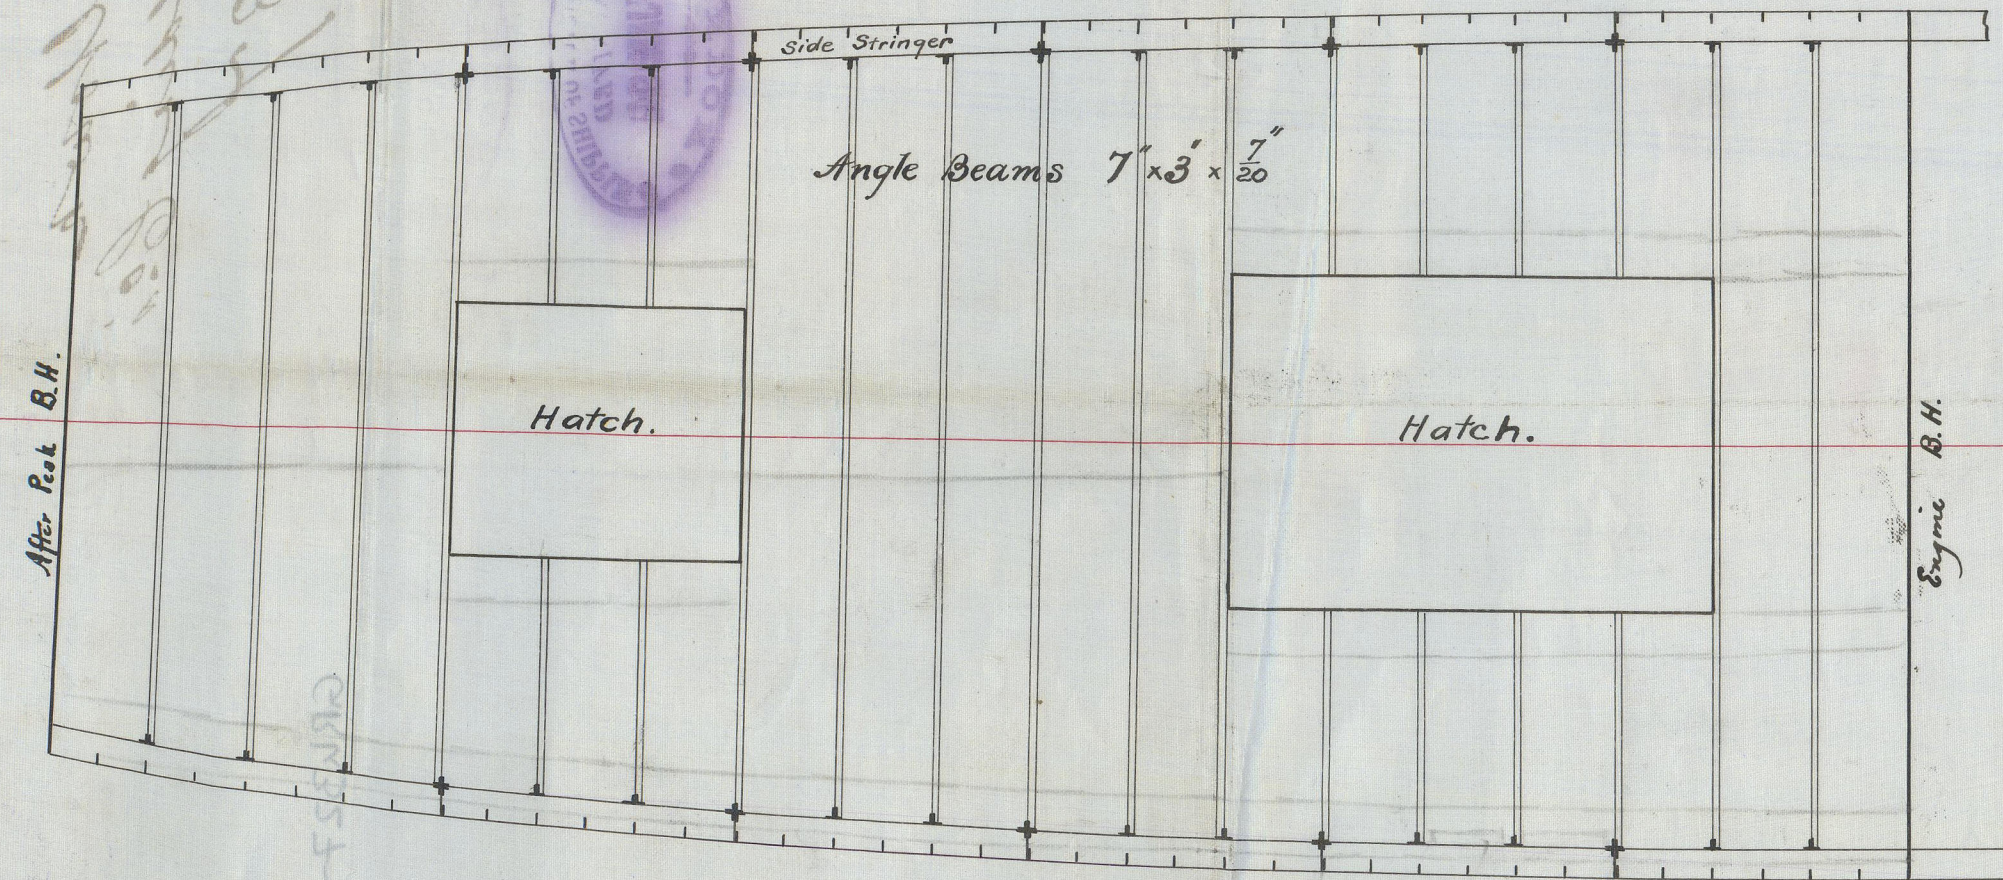

Plan of Proposed Tween-
 -Deck Beams.

S. S. No. 37
 Scale 8" = One Foot.



Cancelled -
 see Amended Plan
 of 10/1/94




Greenock
 27.12.93
 Register
 Foundation
 GRK327-0005

Plan of proposed
sweep deck beams

Campbelltown
Shipbuilding Co.
No 37

GRK327-0005

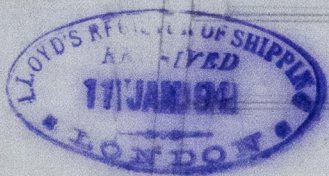

Hatch









© 2021

Lloyd's Register
Foundation