


Campbeltown shg. boys
nosy.

Pumping plan

S S "Guillemot"

GRK327-0007

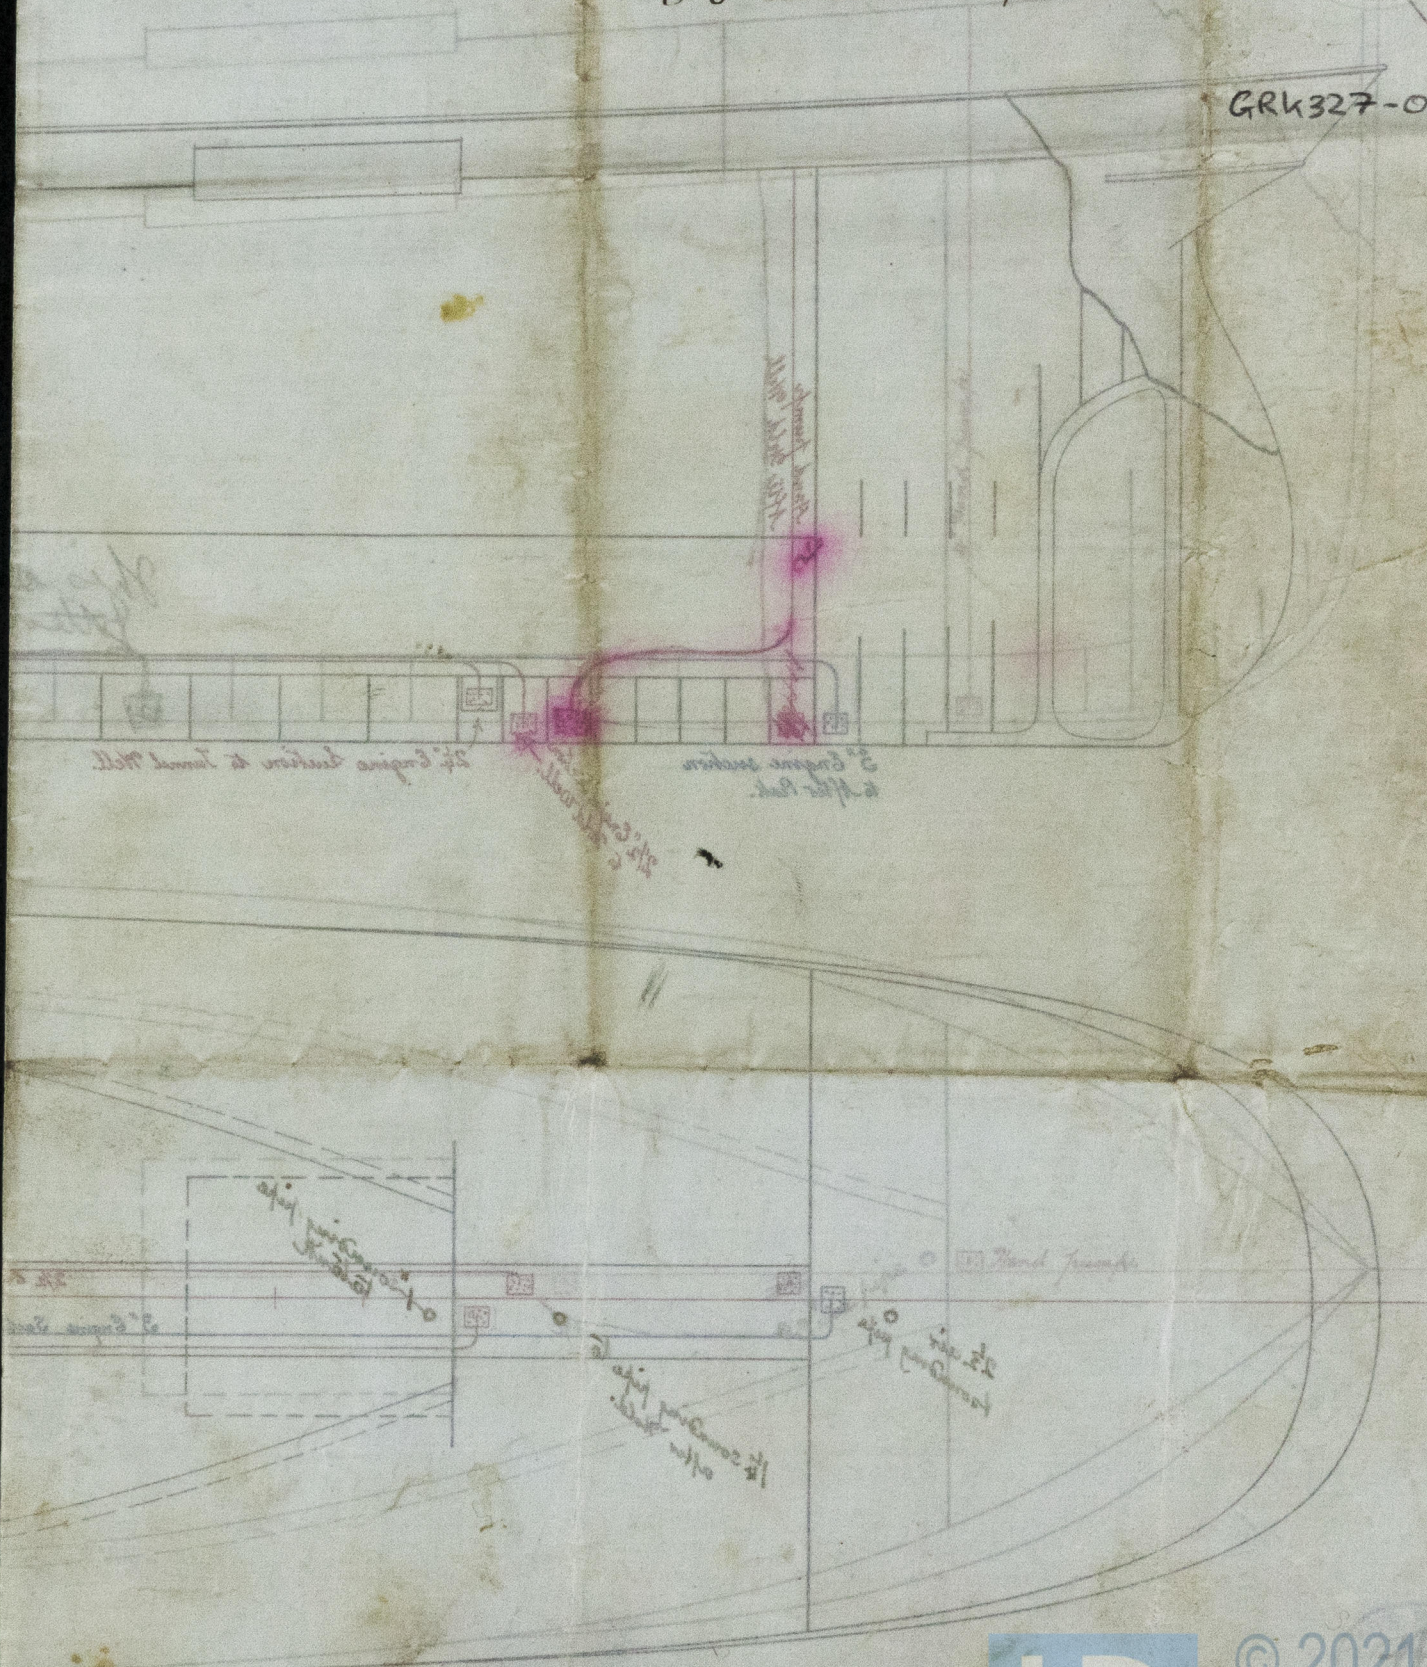

© 2021

Lloyd's Register
Foundation