



CAMPBELL TOWN

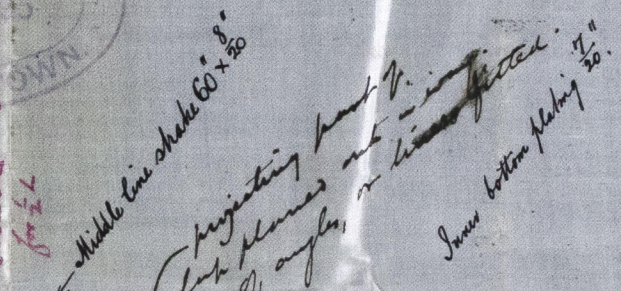

JP. 2/4/94

Flat plate steel  $36" \times \frac{16}{20}$ 

Solid floors on every frame in way  
of engine.


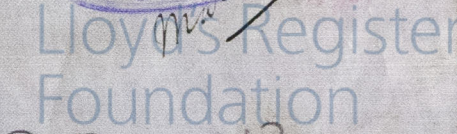


GRK 327-0013



GR1327-0013

London

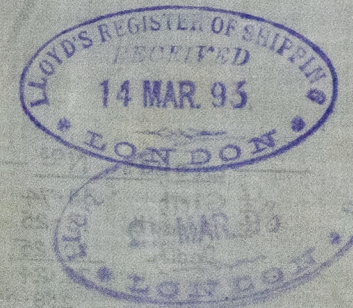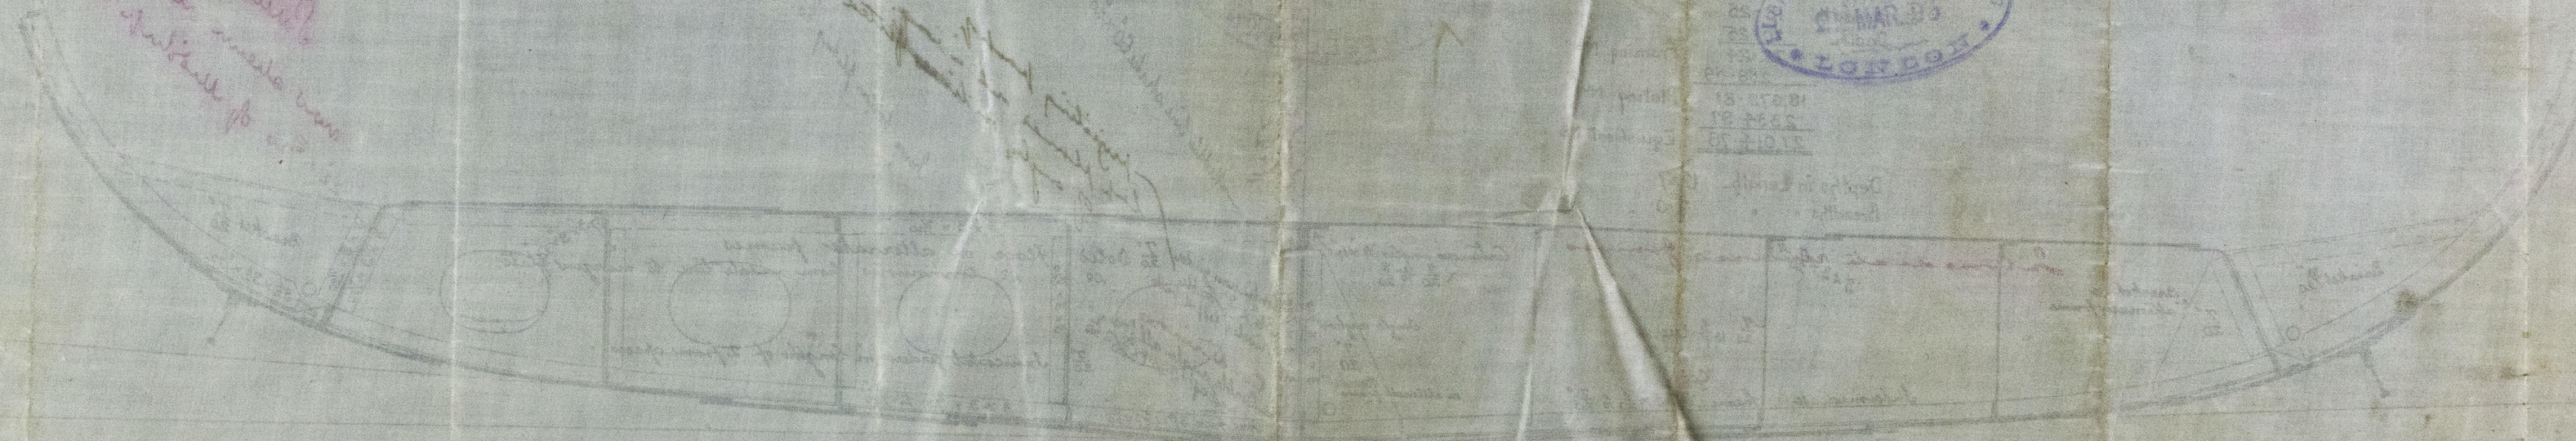

© 2019

Lloyd's Register  
Foundation