




Boilers No 183 Two off

W. P. = 165 lbs

Scale $\frac{3}{4}$ " = 1 Foot.

$HS = 2430$ square feet

RANKIN & BLACKMORE,
ENGINEERS & IRONFOUNDERS
EAGLE FOUNDRY,
GREENOCK

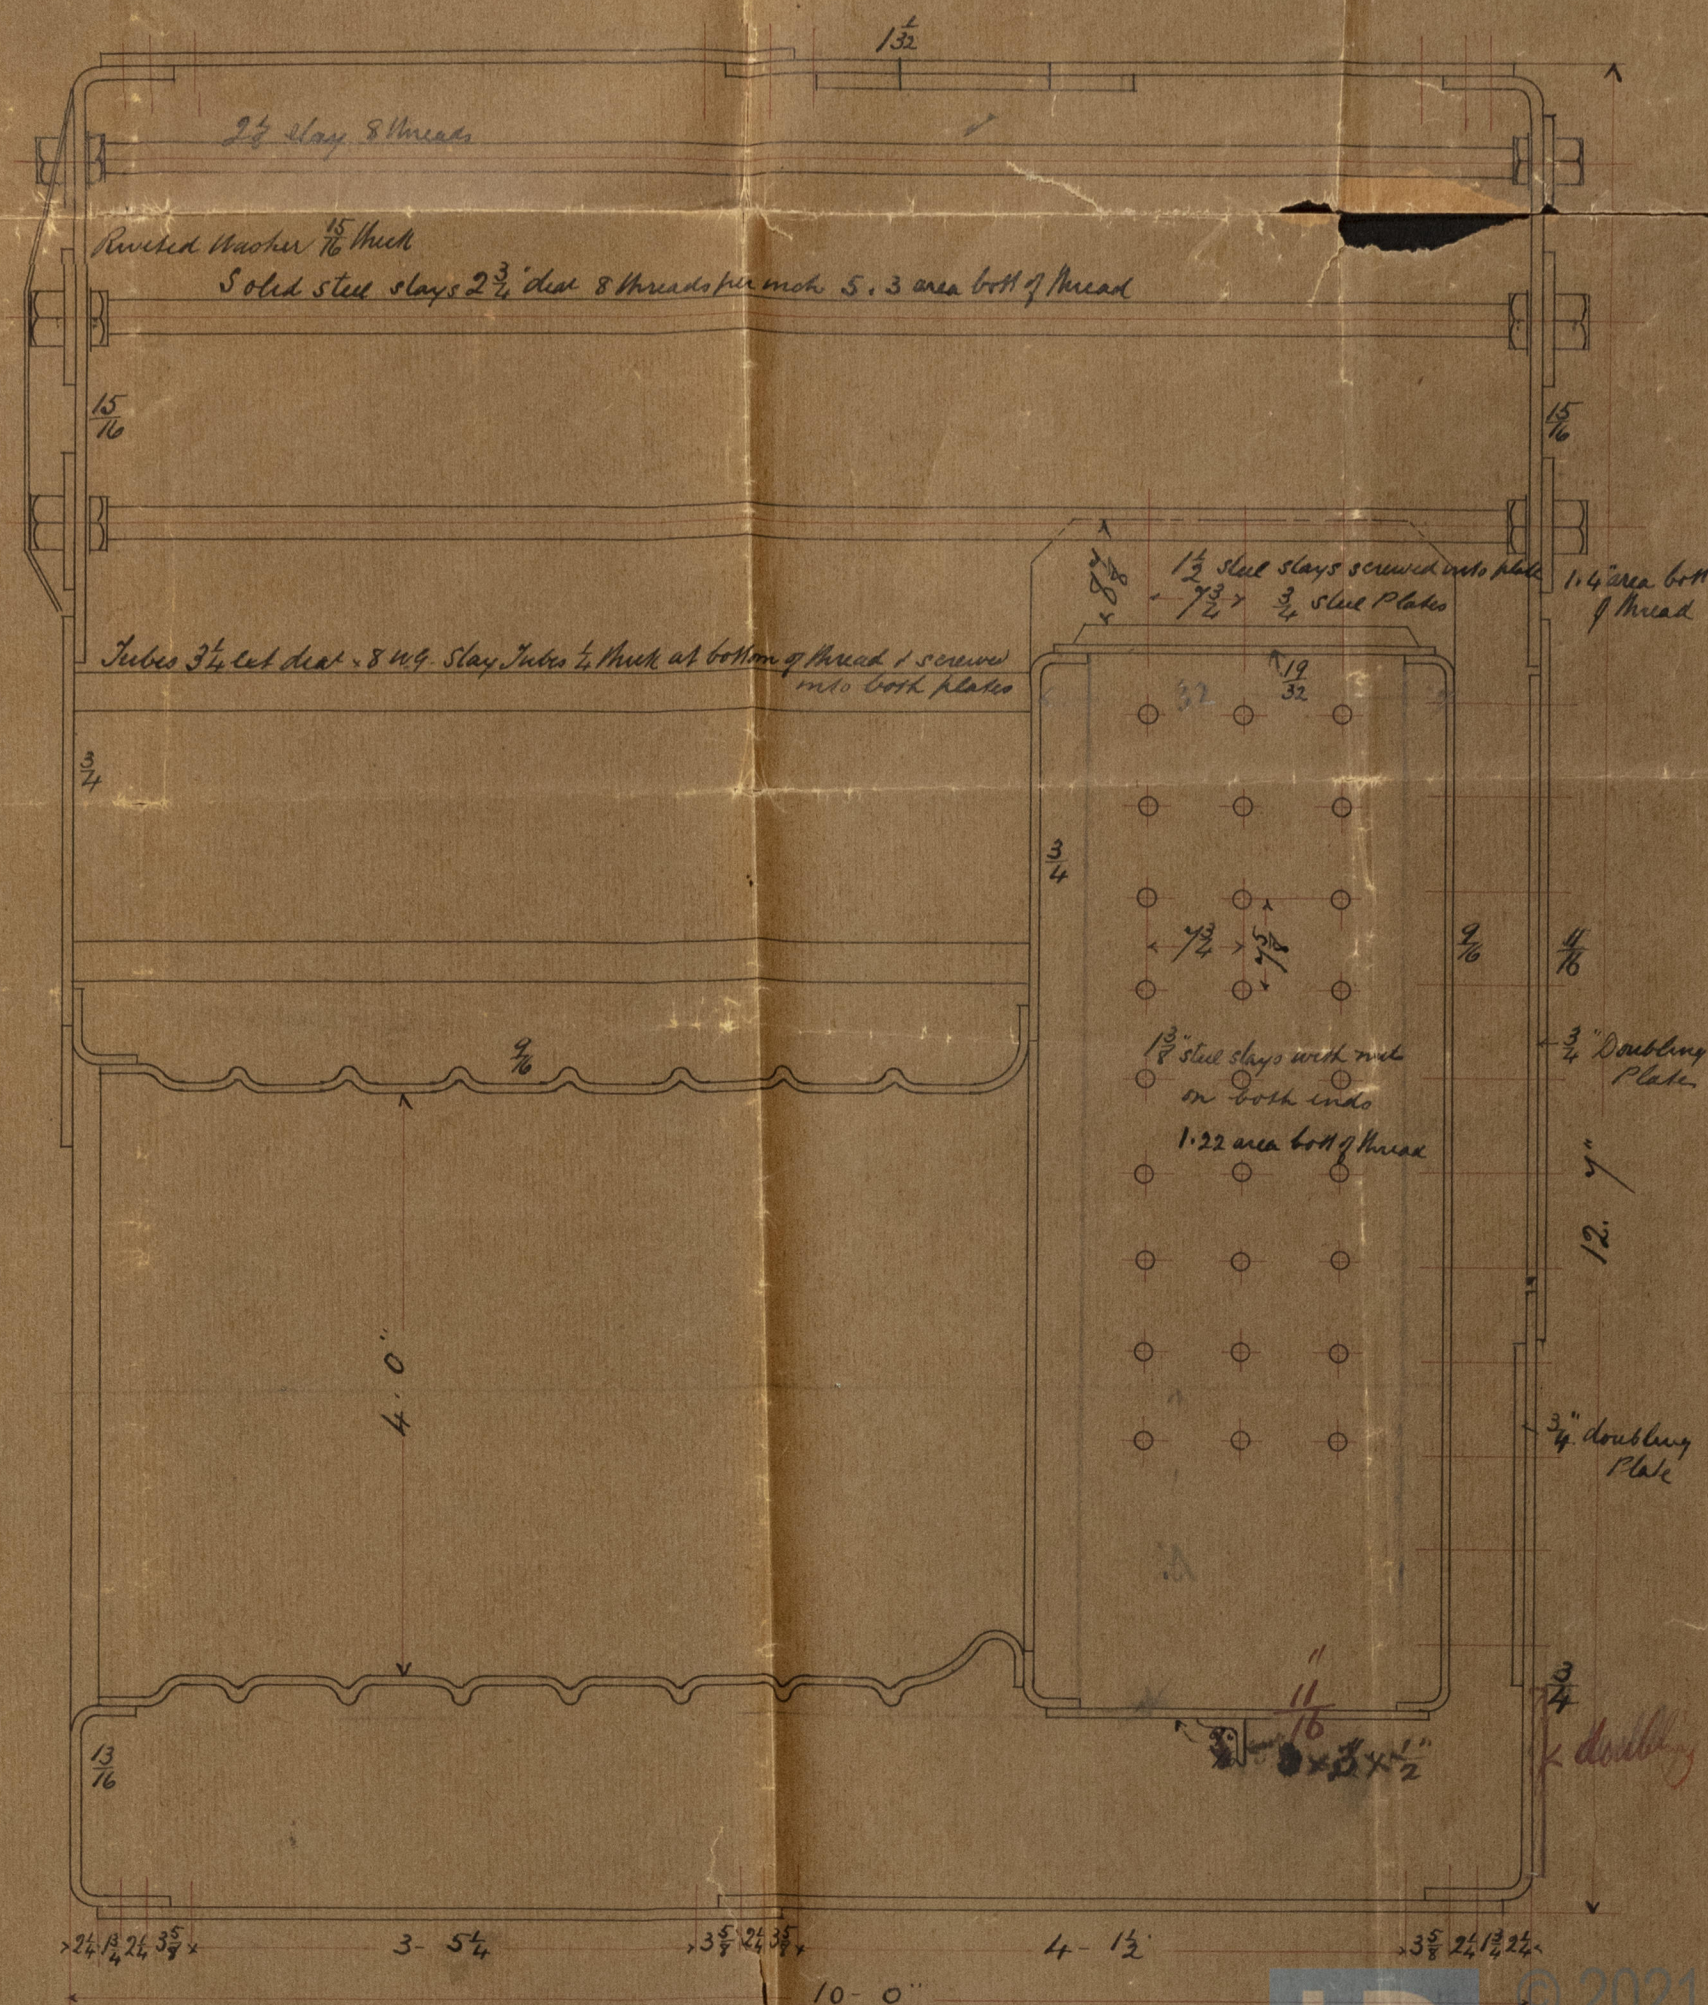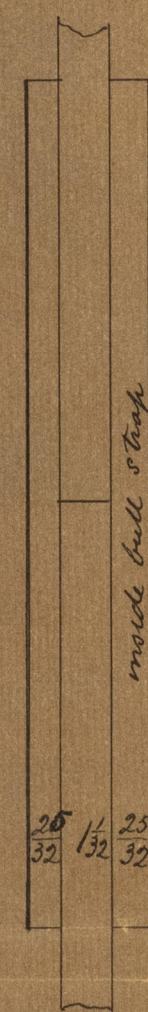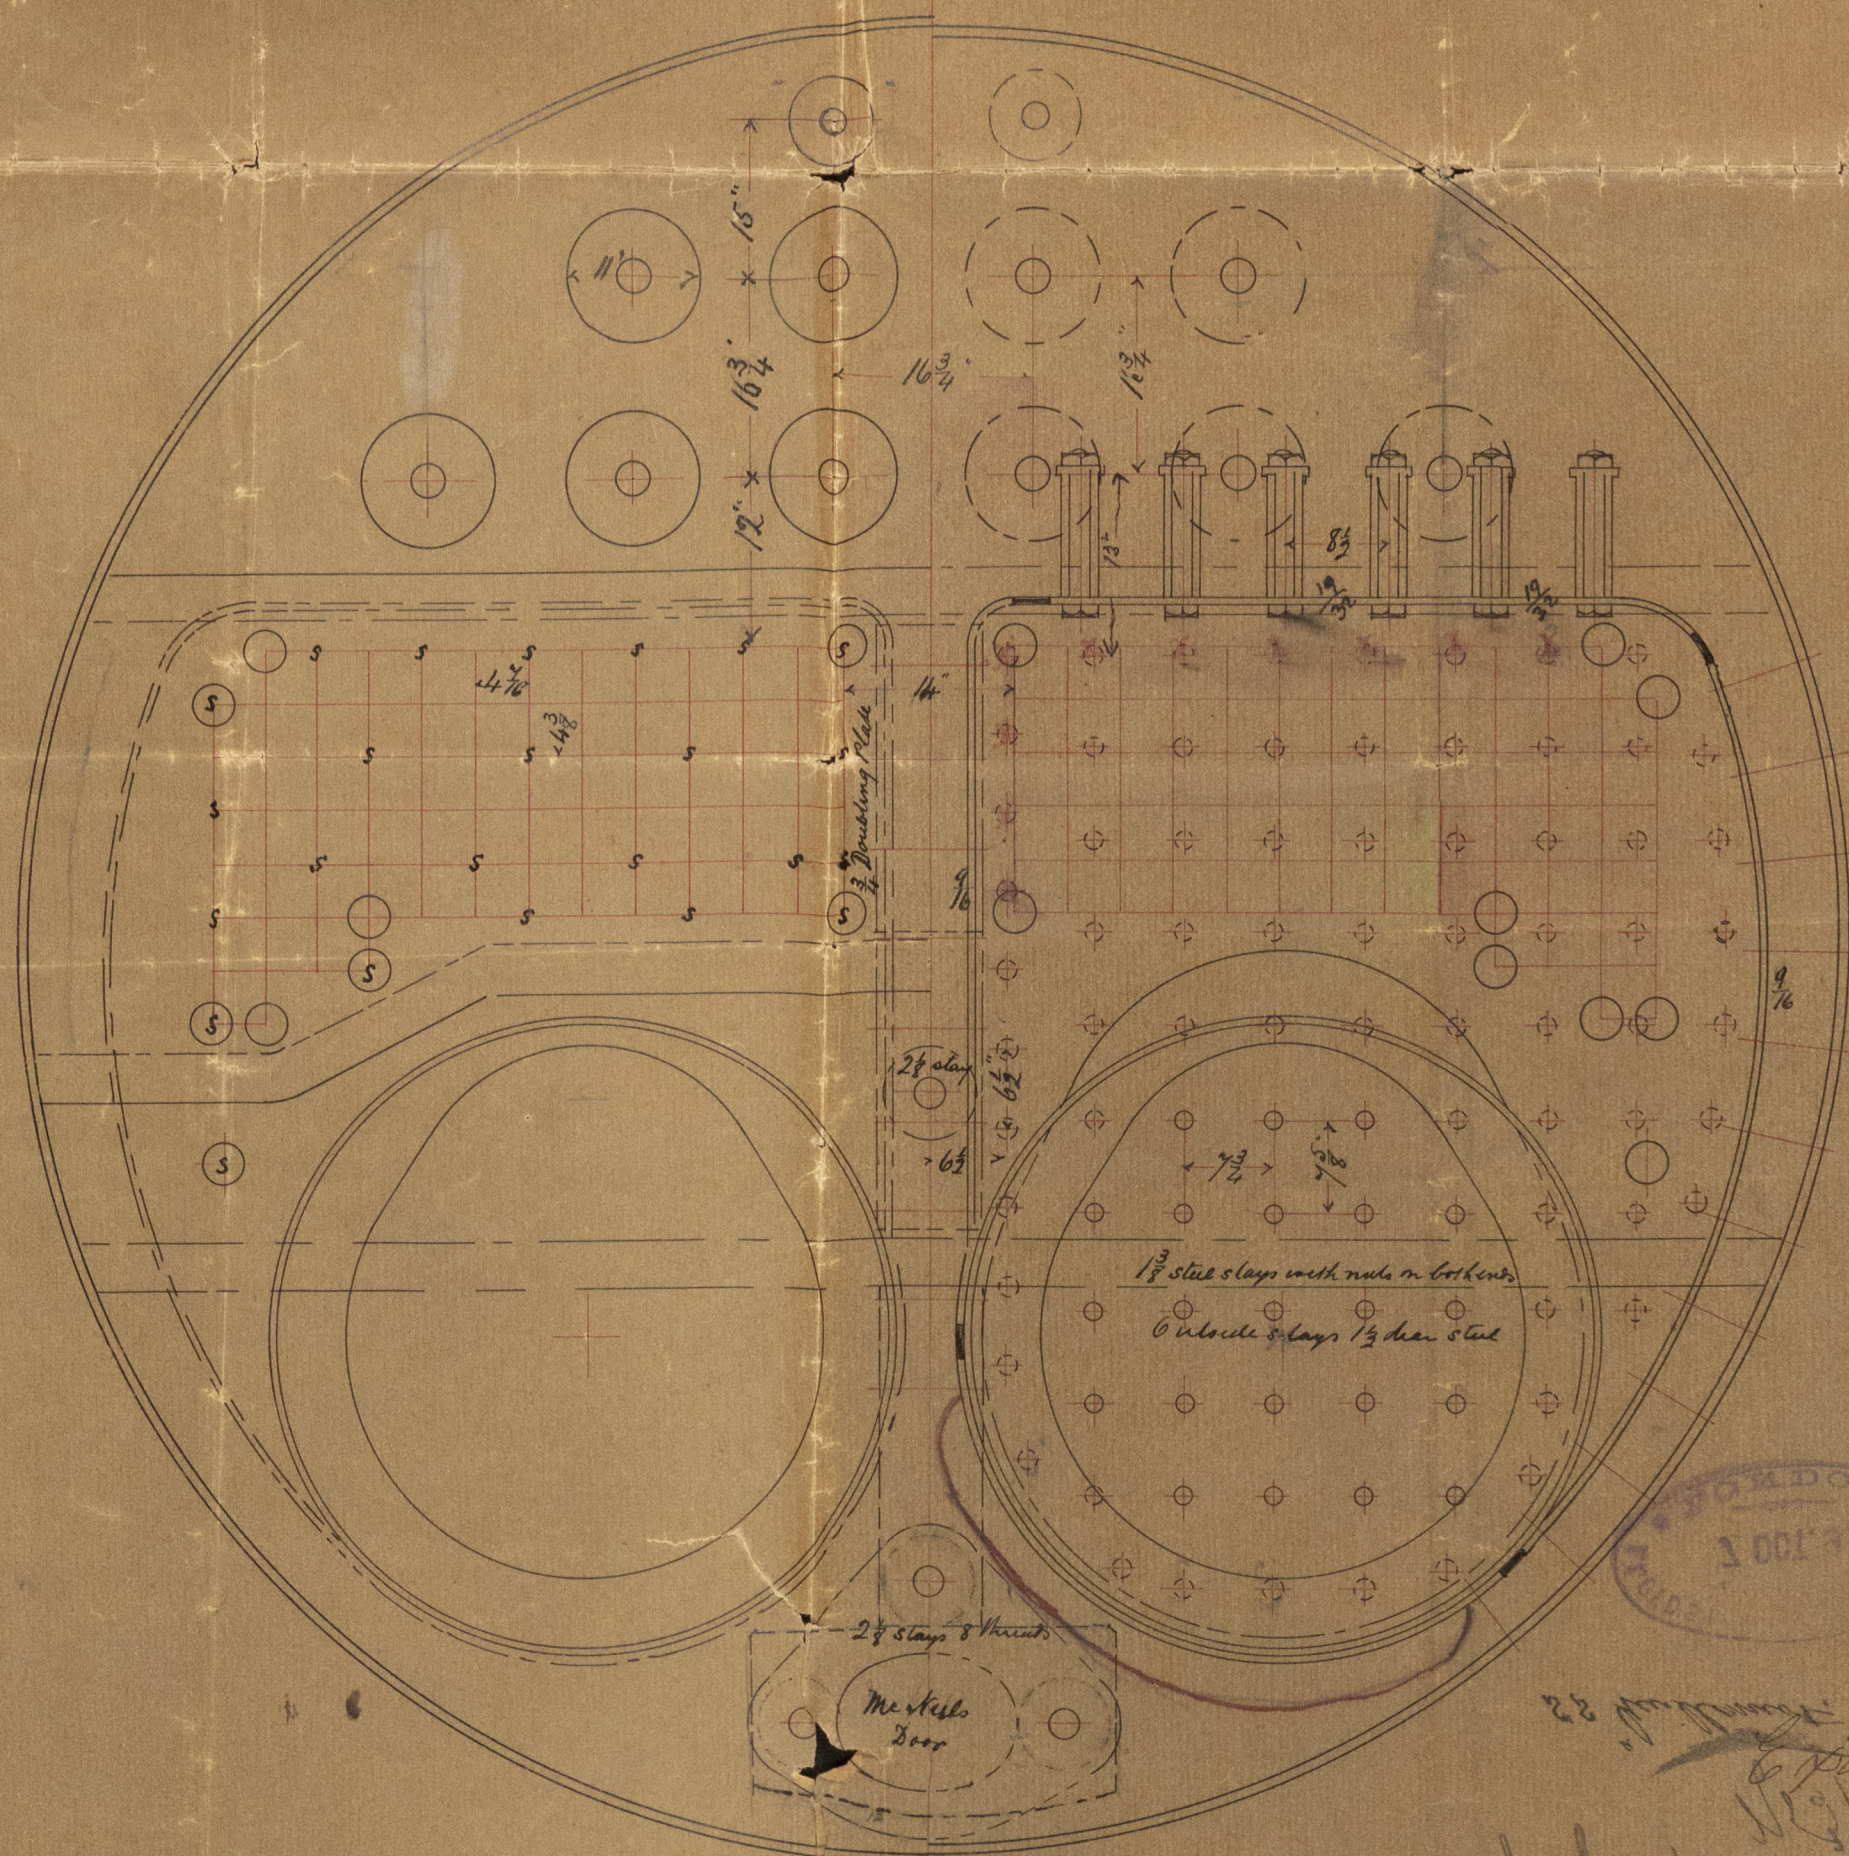


N.A.
10-10-93

Main Boiler
for
The Camp - 8 13 Coy, S.S. 1637

Rankin & Blackmore
Boiler No 183
for Campbelltown
No 37.

S.S. "Gullomet."

7 OCT. 95
LONDON

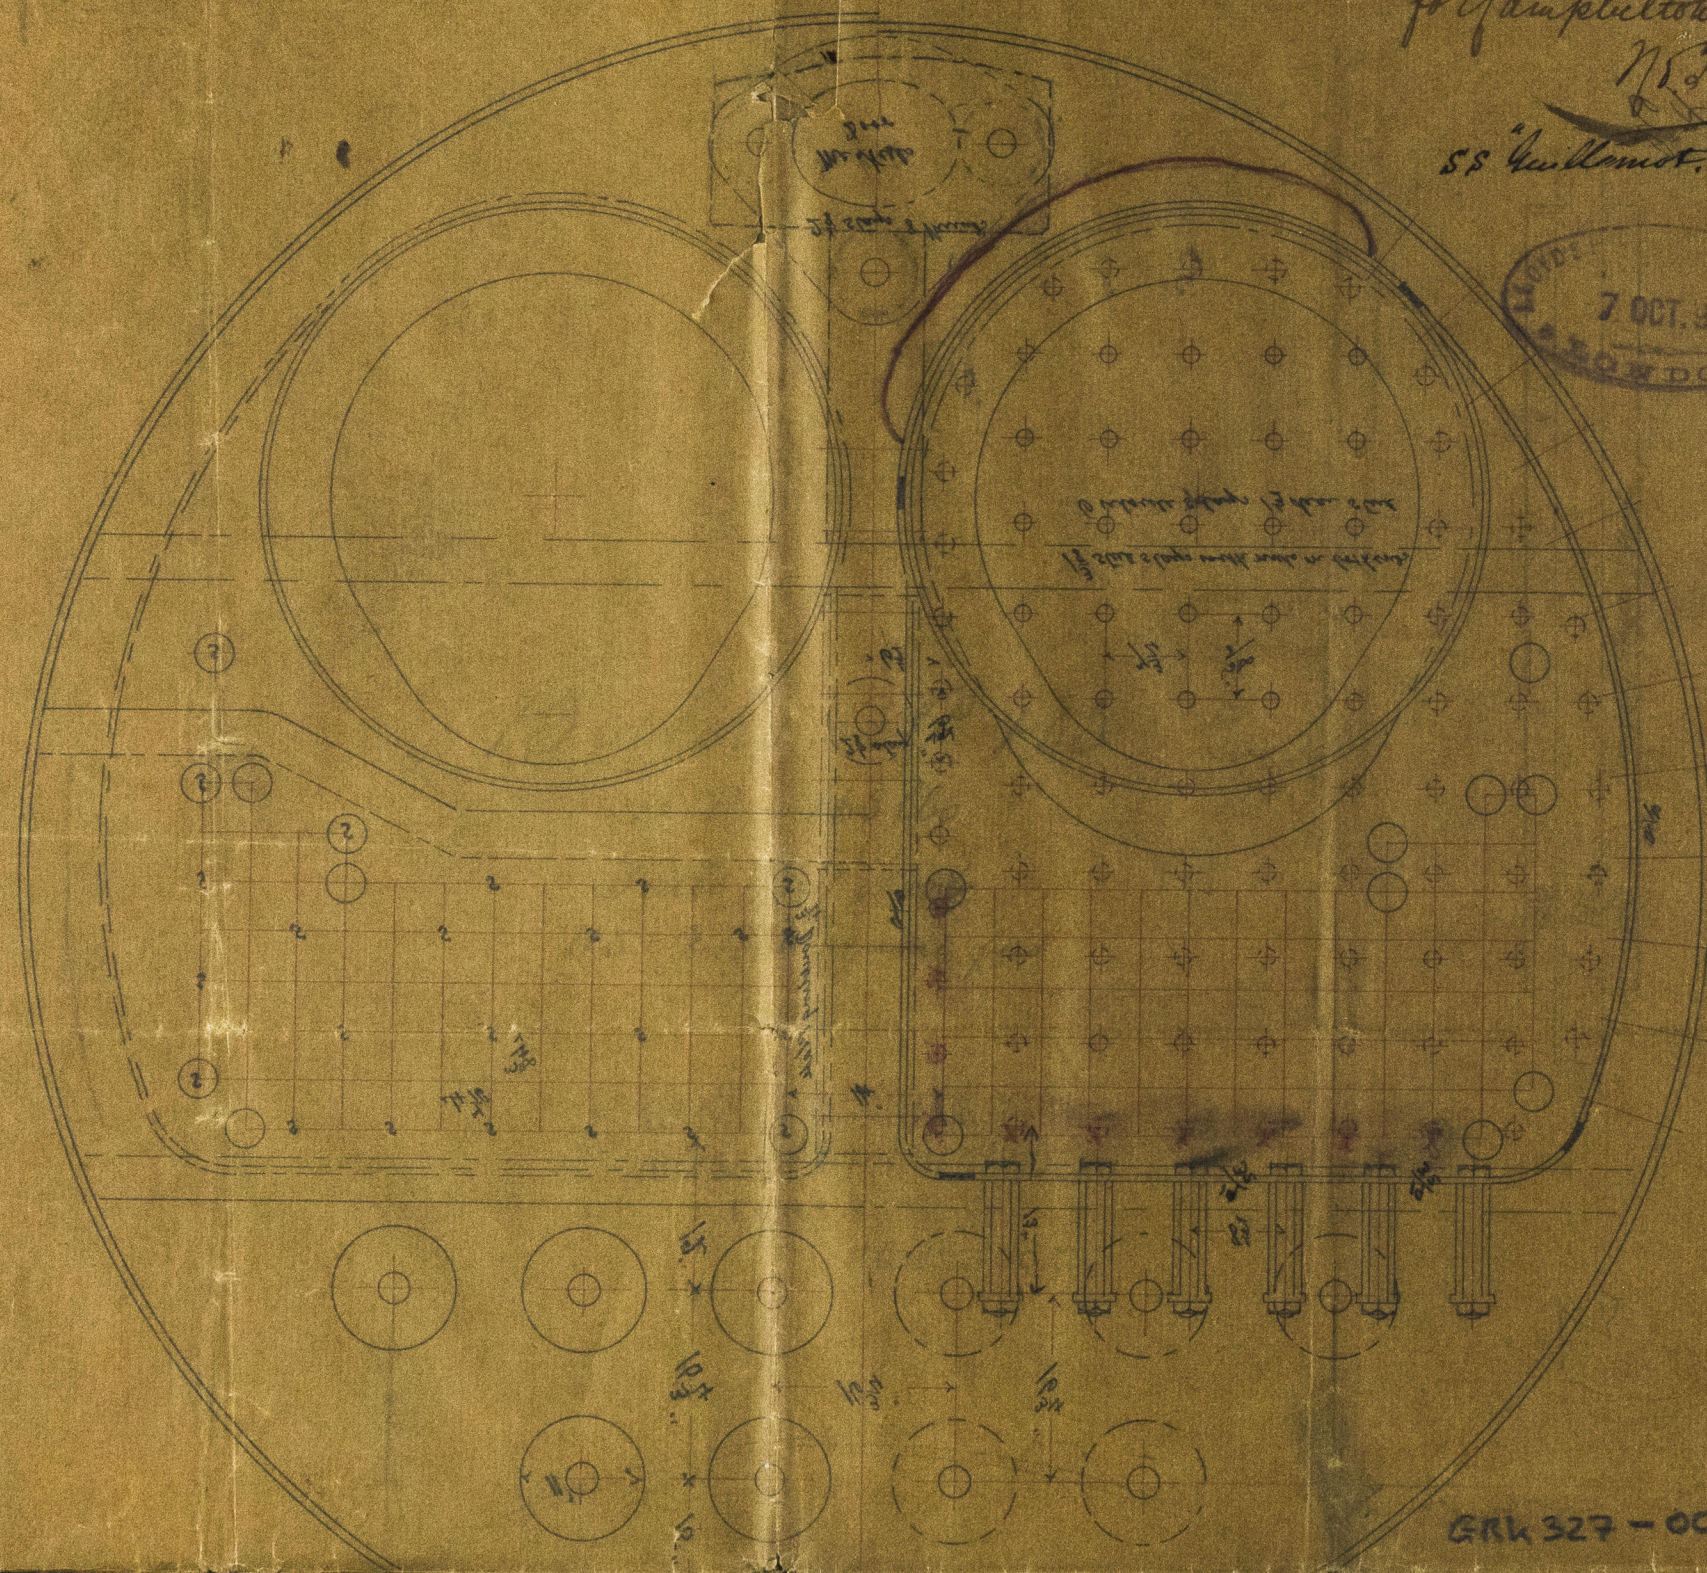

GRK 327-0015

10-10-13
J. G.

WEEPCOCK
POLICE
REGISTERED
10-10-13

