

Received at Greenock Office, 13th January 1894

Lloyd's Register of British and Foreign Shipping.

(Report on Vessel No. _____ Port _____)

No. 1818

SHIP FORGINGS OR CASTINGS.

The words FORGINGS or CASTINGS, IRON or STEEL, should be struck out as may be required.

I have to report that the undermentioned Iron ~~or Steel~~ Forgings ~~or Castings~~,
manufactured by The Farrow Forge & Co
of Farrow for the Vessel No. 350, being built
by Messrs Russell & Co of Greenock
have been inspected by me as set forth below, and found to be, so far as can be seen,
Sound

Mark on Forgings.




Lloyd's
No. 3010B
JG

John C Craig
Newcastle

9/1/94

	STERN FRAME.	RUDDER FRAME.	STEM.
Material* ...	<u>Scrap Iron</u>	<u>Scrap Iron</u>	<u>Scrap Iron</u>
How made ...	<u>Forged</u>	<u>Forged</u>	<u>Forged</u>
Dimensions ...	<u>9 - 2 1/2</u>	<u>6 1/4 - 3 1/4</u> <small>bushes</small>	<u>9 - 2 1/2</u>
Progress on Inspection	<u>Inspected</u>	<u>Forged & Smithed</u>	<u>Smithed</u>
Date when Inspected	<u>October 5/93</u>	<u>Oct 27 Nov 8-16-21-27</u> <u>Dec 9/93 January 2/94</u>	<u>October 5/93</u>

SKETCHES OF FRAMES SHOWING POSITION AND DESCRIPTION OF WELDS OF FORGINGS, OR PARTICULARS OF TESTS APPLIED TO CASTINGS.

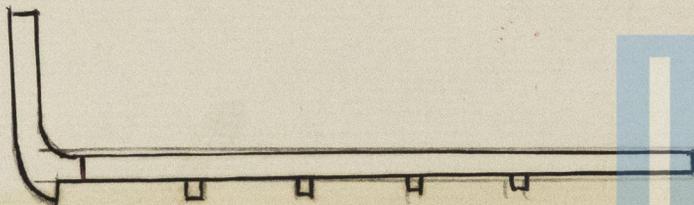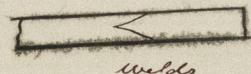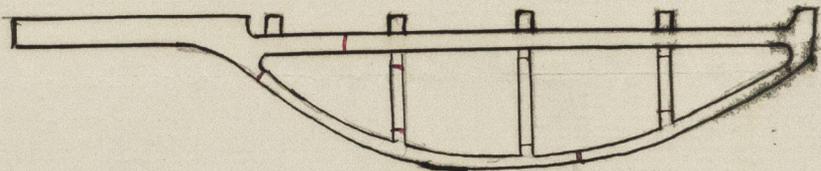

© 2019

Lloyd's Register
Foundation

* If of Iron, state whether scrap or puddled Iron.