



Oct. 4. 93.

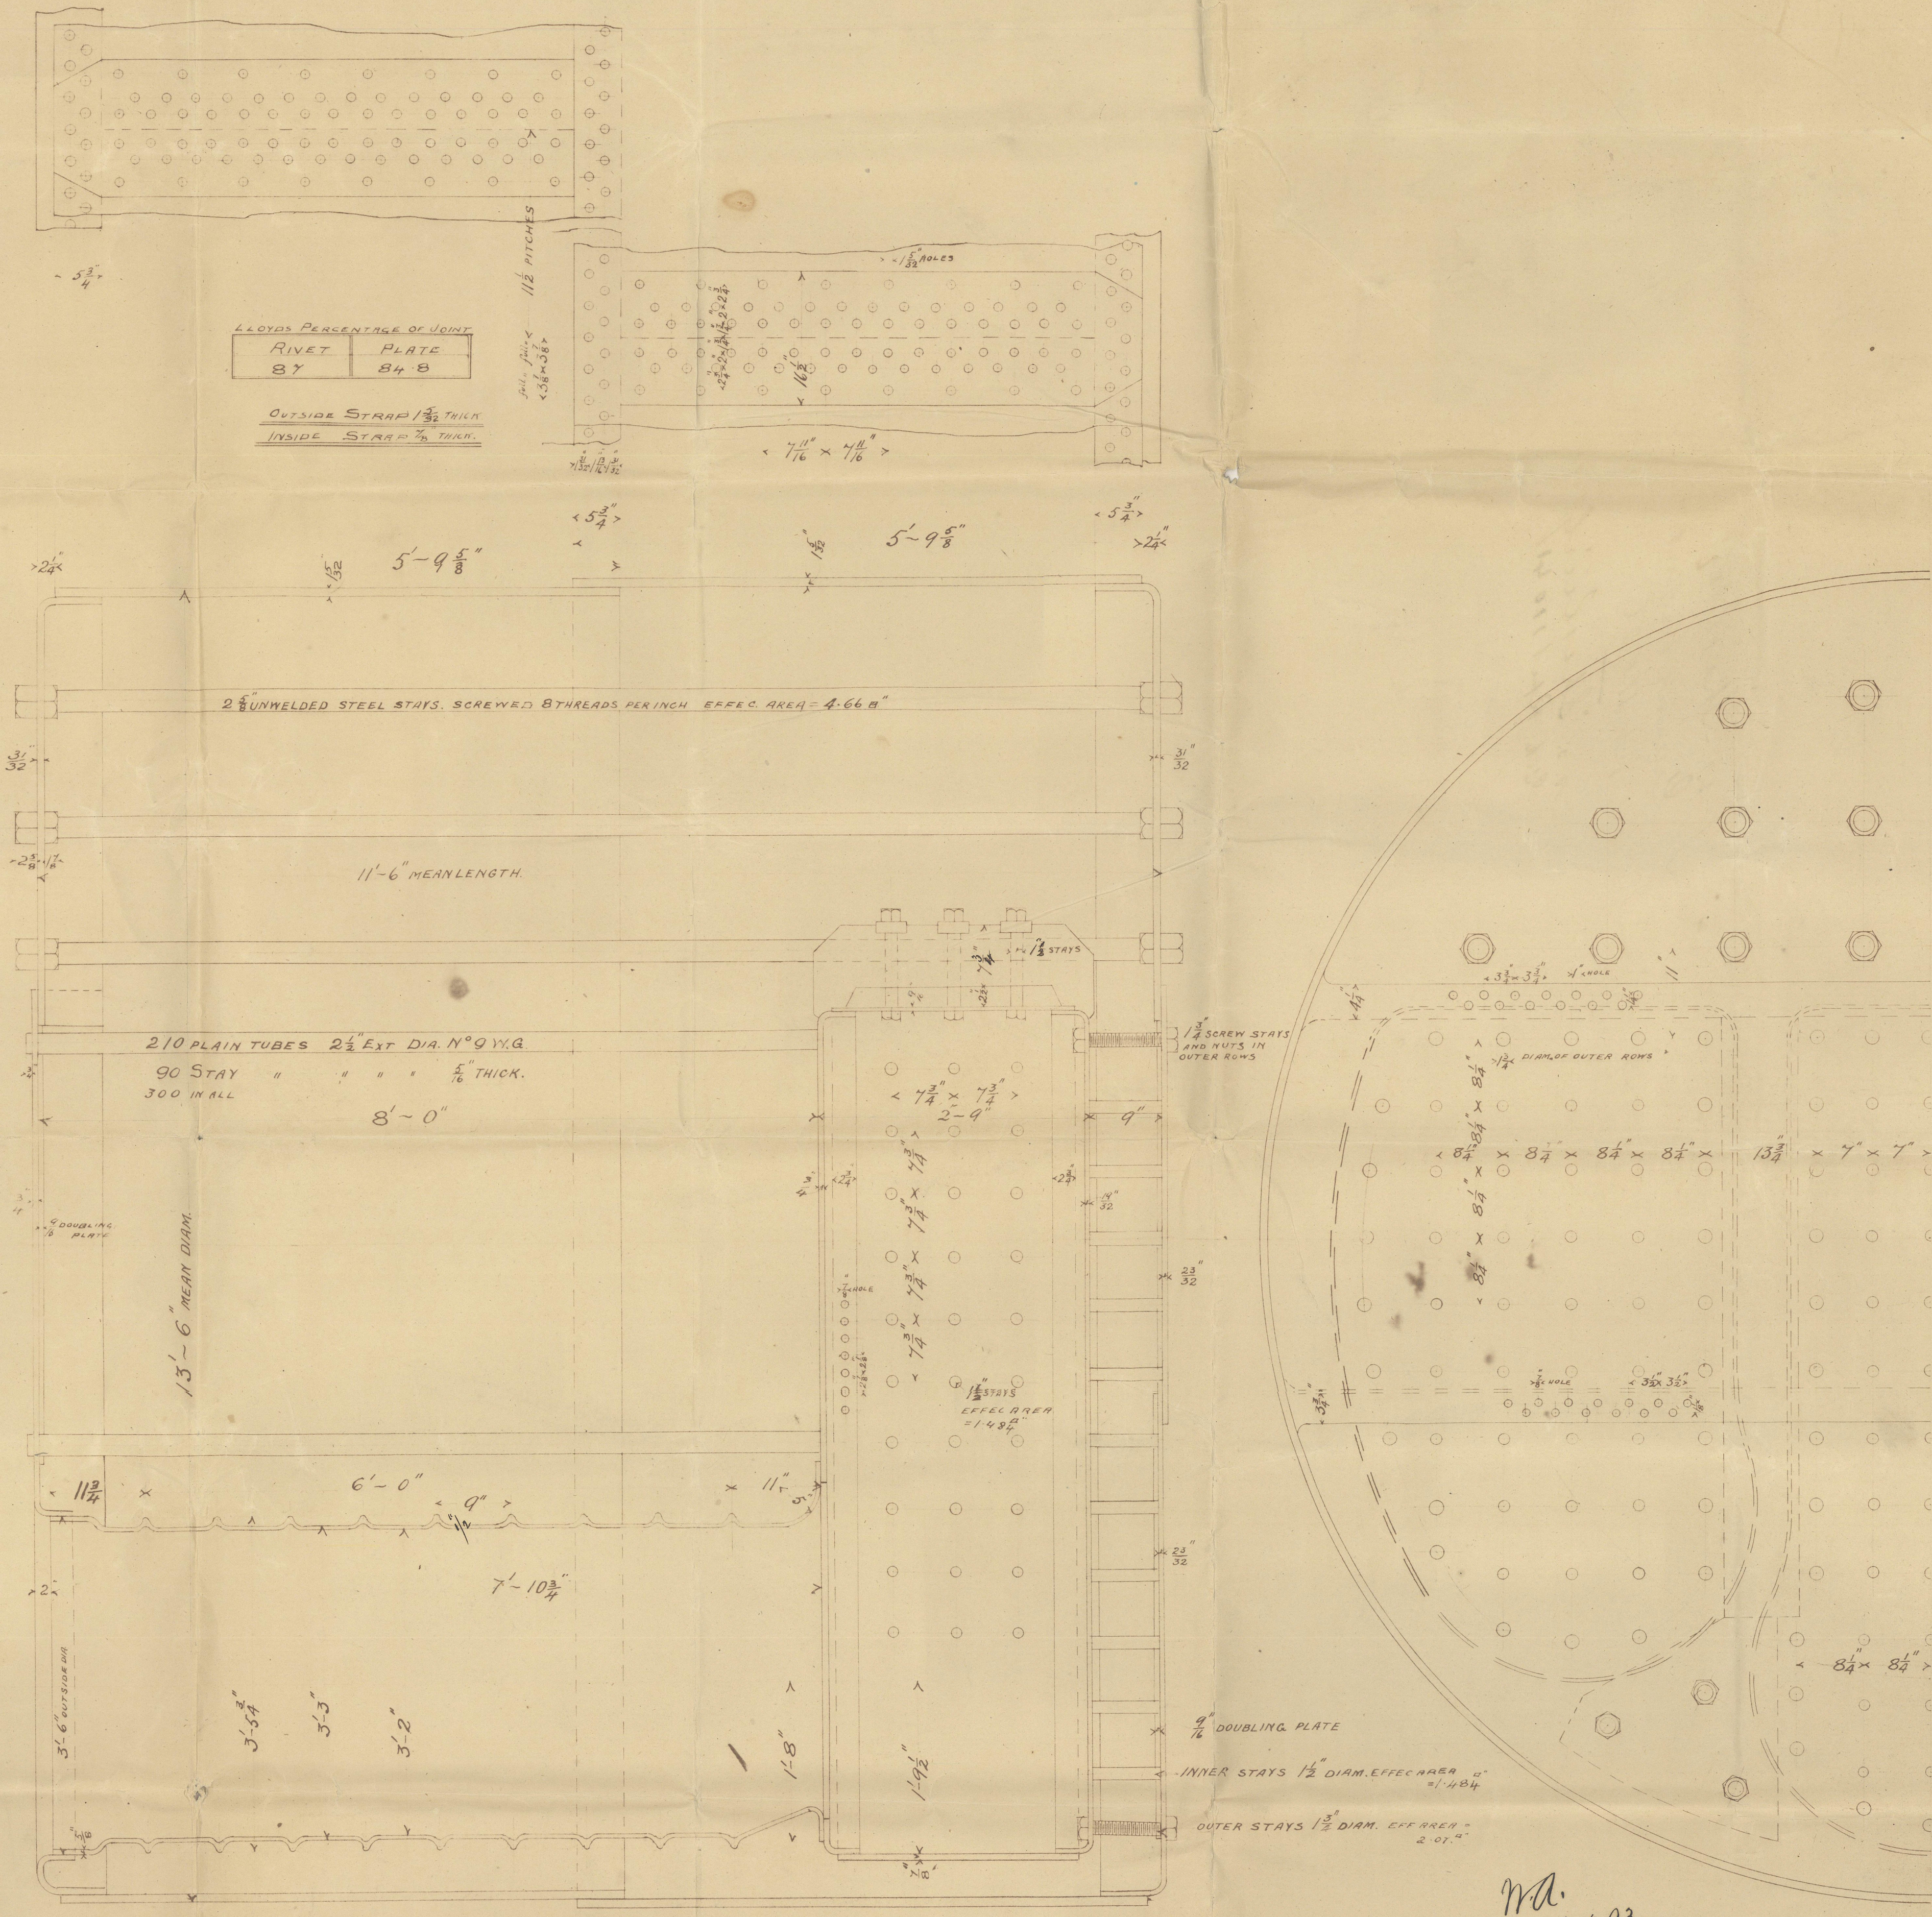

HEATING SURFACE

FURNACES	107.9
CHAMBERS	209
TUBES	1569
TOTAL	1885

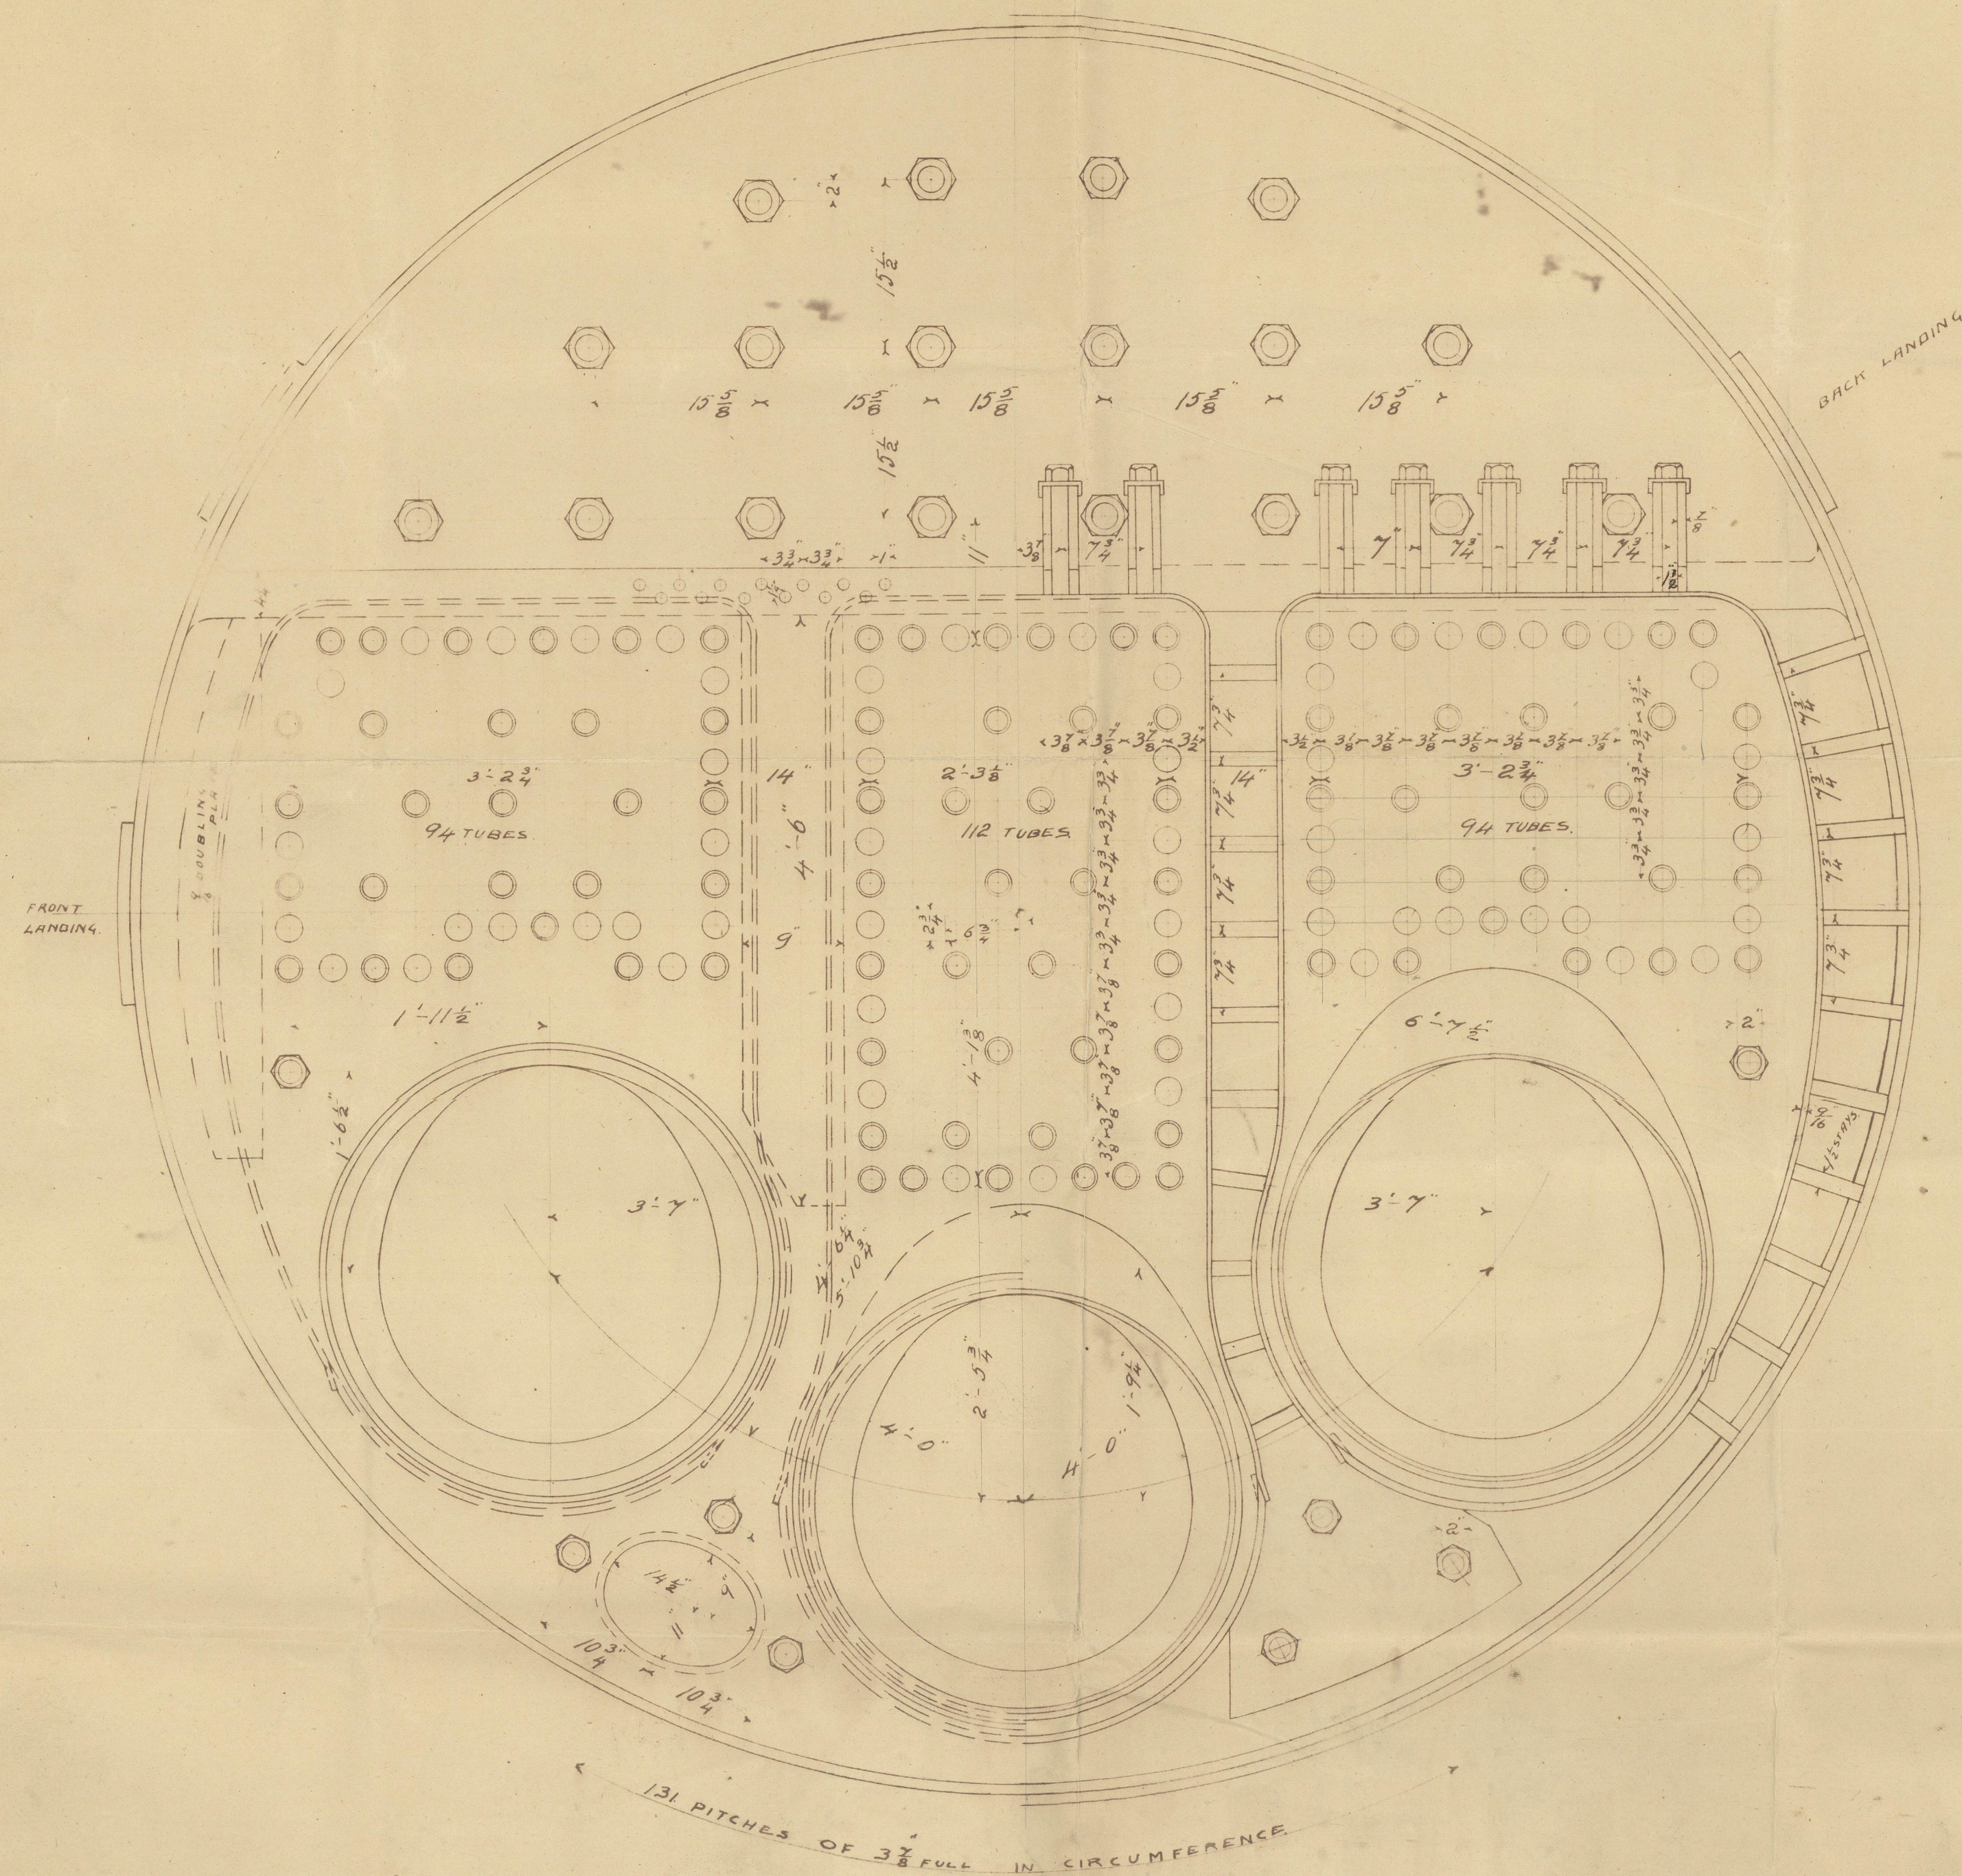

MAIN BOILERS N<sup>os</sup> 312 AND 313, for Russell & Co's S.S. Nos 343 & 344,

— 3 OFF FOR EACH N<sup>o</sup>. —

— TO PASS LLOYDS FOR 170 LBS W.P. —

— SCALE 1" = 1 FOOT —

— ALL STEEL EXCEPT TUBES. —

MA.  
4.7.93




Blackwood Gordon's  
main boilers for Russell's  
7437344.



s.s. "Sheshing"  
Greenock Report  
No. 11006

s.s. "Sheshing"  
Grk. Rpt 11041

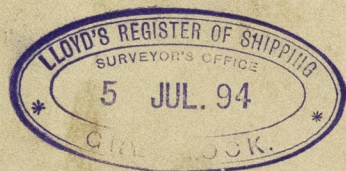

© 2021

Lloyd's Register  
Foundation

GRK 327-0070