

Nos 343 & 344  
Midship Section  
Scale 1/2 inch = one foot

"Starhtay" (No. 343)

344 Starhtay

11.8.93.  
24.10.93.

Bridge 58' long

7/16 Deck Butts lapped + 2.11

45' 2.9  
54' 2.0 Strungers  
Butts lapped + 2.11

7/16 at post. Bridge + 1/16  
Butt shape 2.11

7/16 Bulwarks  
7/16 at post. Bridge + 1/16  
Post ends of bridge

Strungers 57' 2.0 for 1/16 at ends.  
Butts lapped + 3.11 fore & aft

Strungers 57' 2.0 for 1/16 at ends.  
Butts lapped + 3.11 fore & aft

Shrouds 57' 2.0 for 1/16 at ends.  
To be increased 5/16 for 1/16 at ends.  
Doubled at ends of bridge  
Straps 3.11 all fore & aft.  
5/16 thick for 1/16 at ends.

46' 13-10  
To be increased 5/16 for 1/16 at ends.  
Straps 3.11 all fore & aft.  
5/16 thick for 1/16 at ends.

54' 12-9  
Butts 3.11 lapped

54' 13-10  
Butts 3.11 lapped

54' 12-9  
Butts 3.11 lapped




46' 13-10  
Butts 3.11 lapped

54' 12-9  
Butts 3.11 lapped




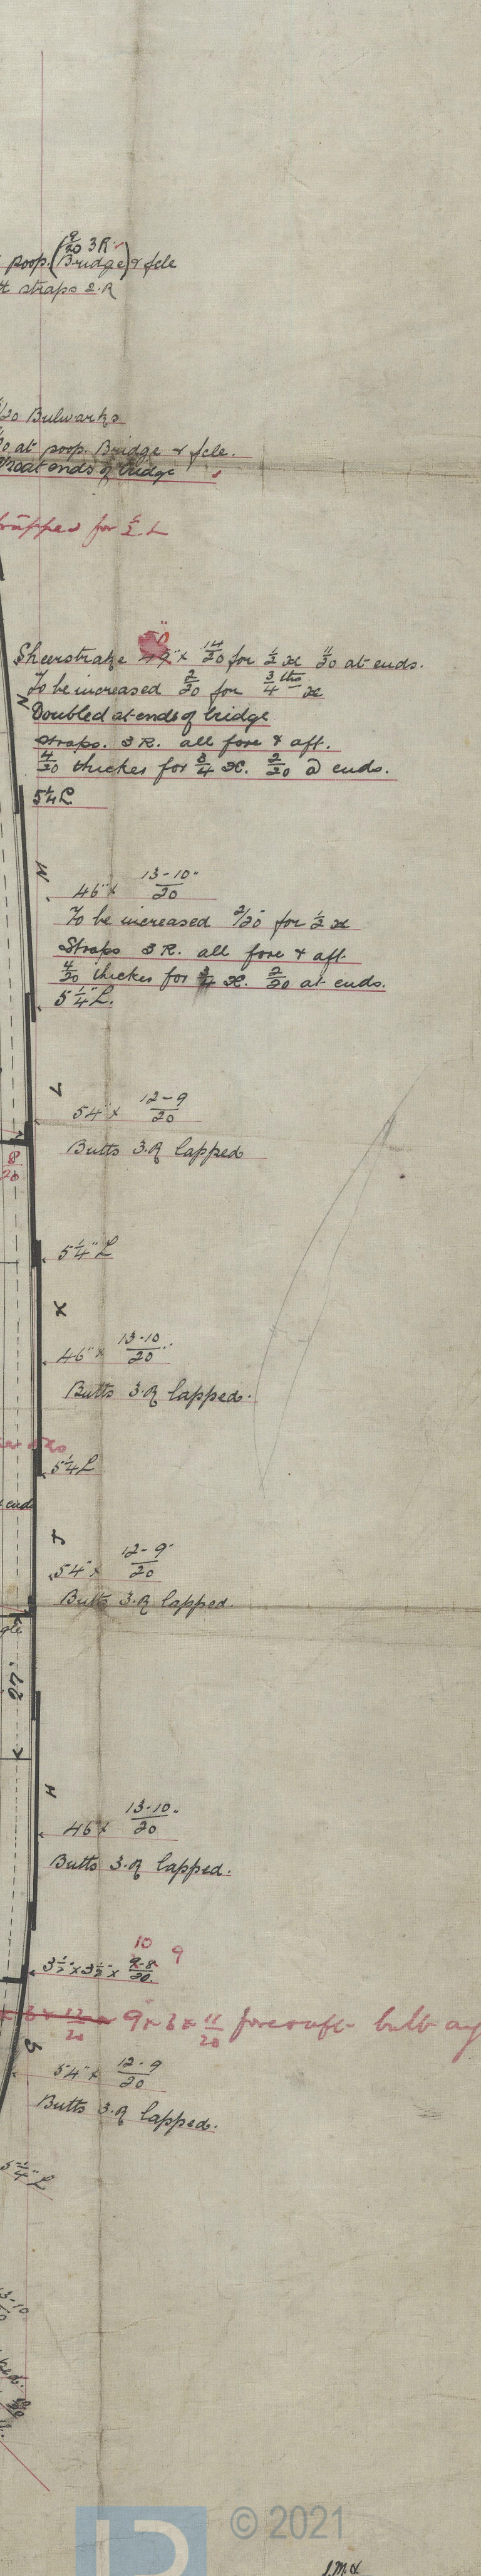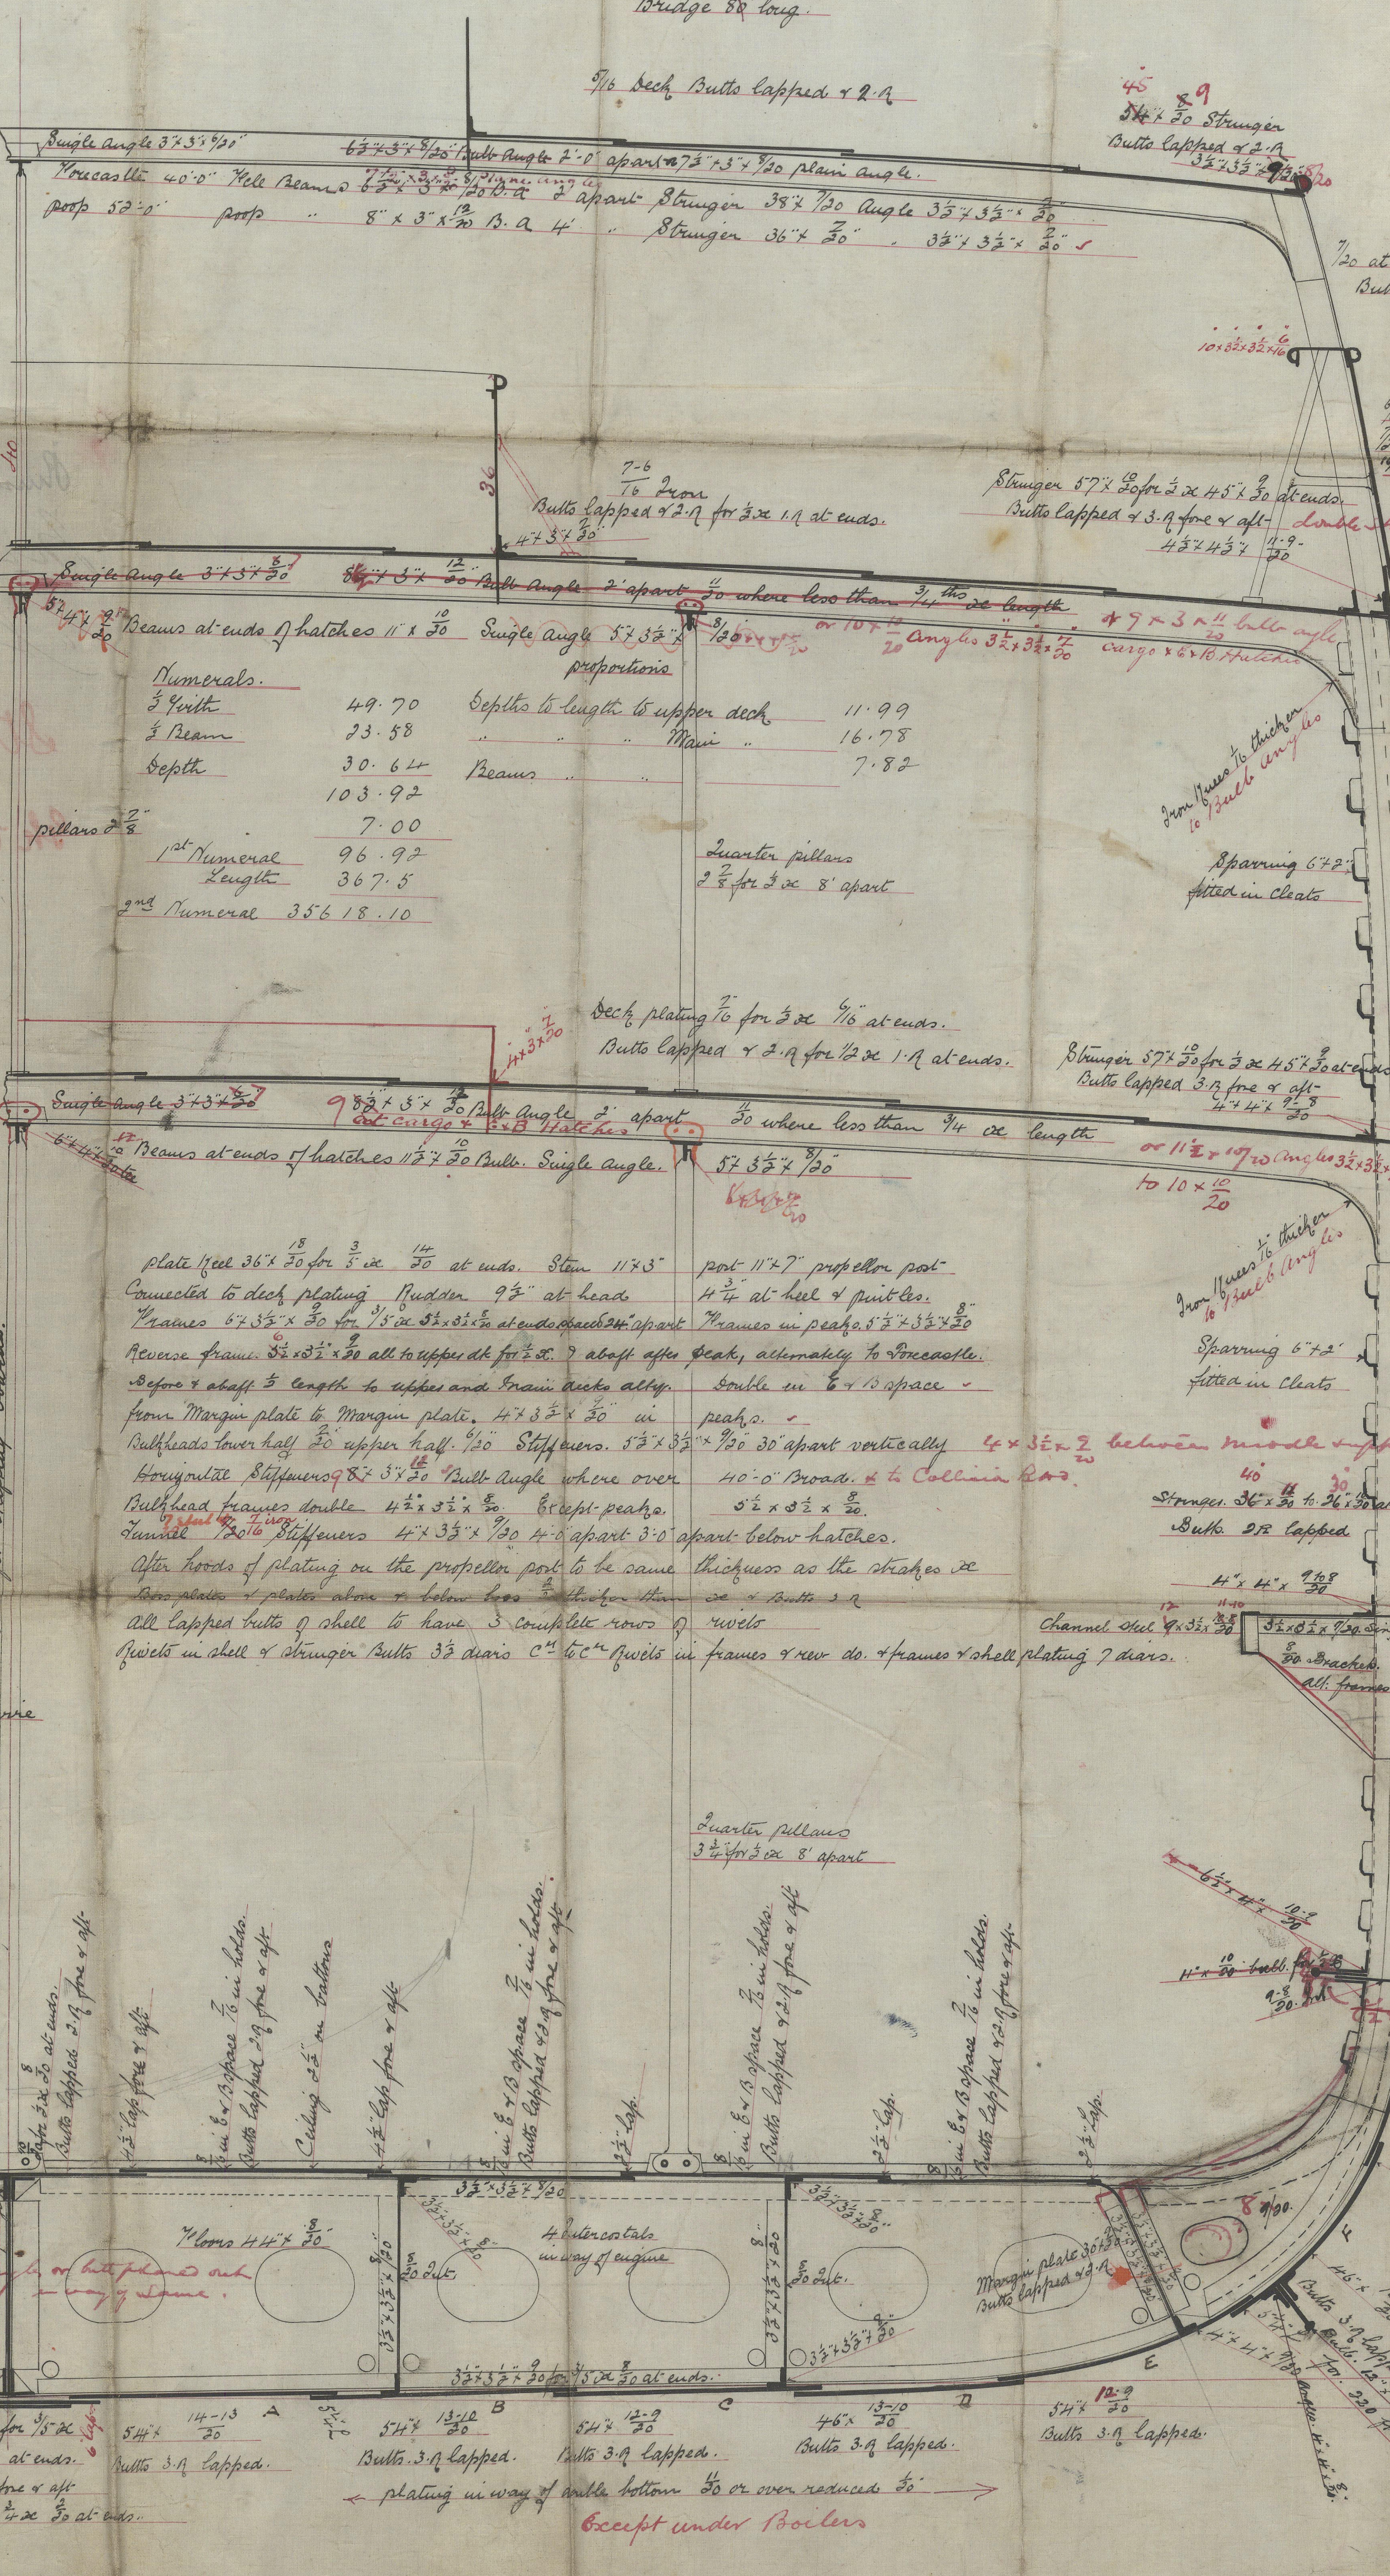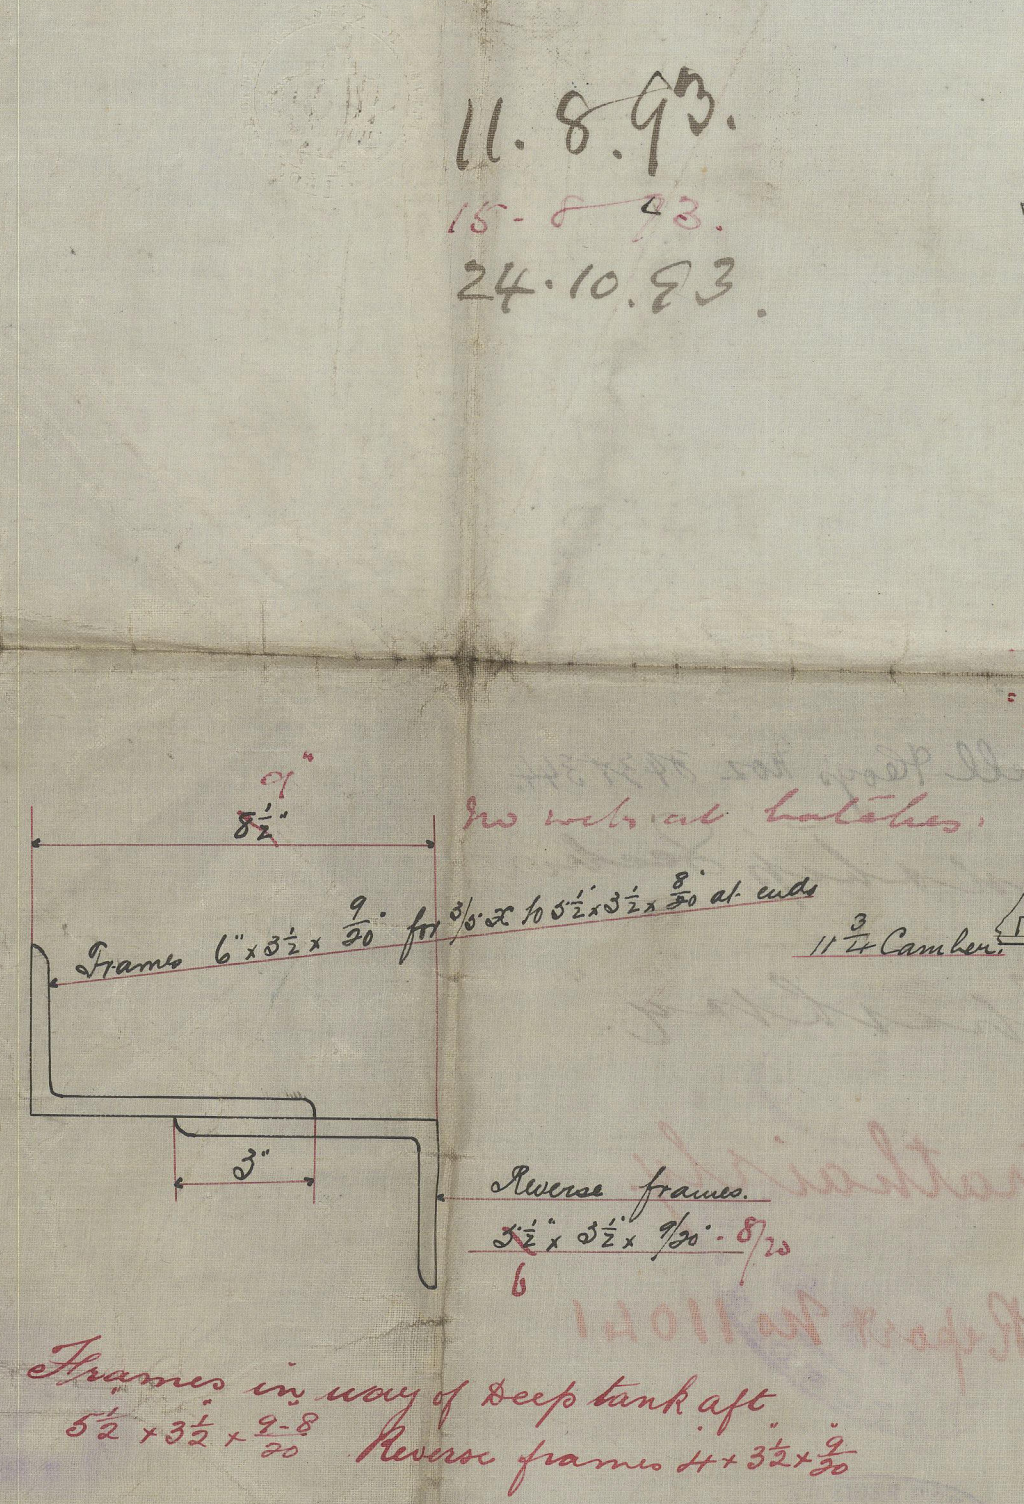

Equipment etc



1/2 Beam	23.58
1/2 Width	49.70
Depth	30.64
Length	103.92
Exterior	38190.6
Equipment etc	2219.9

Equipment etc 40410.5

2 Bow Anchors	4 1/2 Cuts ex stock
1 "	4.0
1 "	36 3/4
1 Stream	12 3/4
1 Edge	6 3/4

270 Fathoms 2 7/8 Stud chain Cable 608-2-14

90 "	1 1/2 to stream 60-0-16 Stud link or 1 1/2 Stud wire
120 "	1 1/2 to stream or 1 1/2 Stud wire
90 "	1 1/2 to stream or 1 1/2 Stud wire
90 "	1 1/2 to stream or 1 1/2 Stud wire

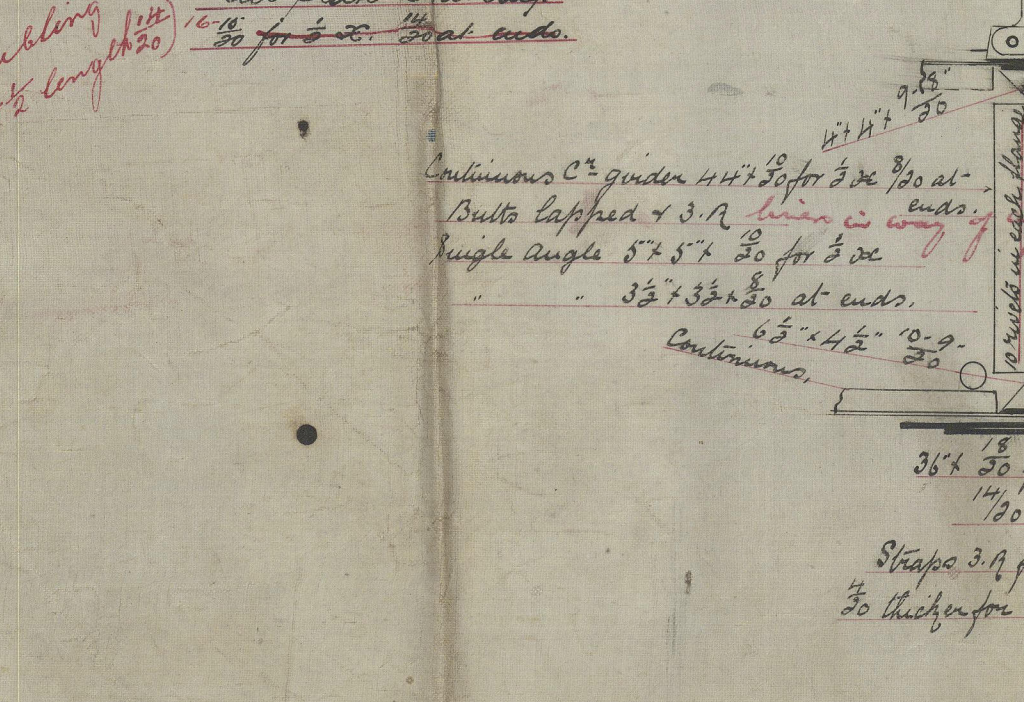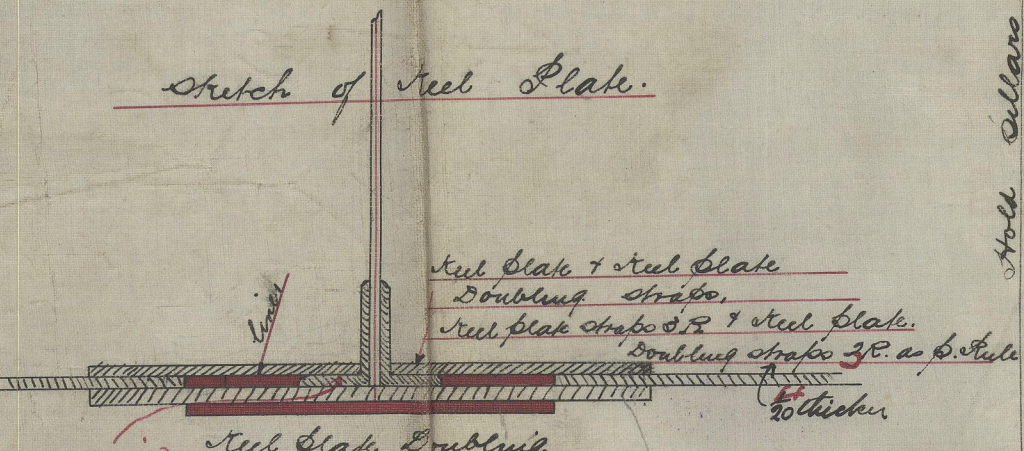



93 Russell Hoys Nos 3438344

Friendship Sealer

"Shushay"

Strathairly

Gk Report No 11041

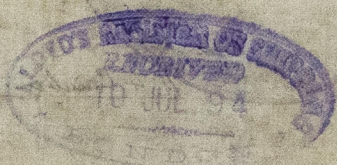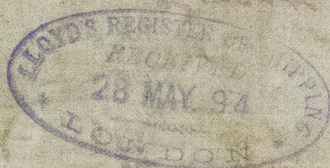

910 B



© 2021

Lloyd's Register

GRK327-0075