






No. 343 - "Skathelay"
No. 344 - "Skathelay"

Profile & Deck Plans of S.S. No. 343 & 344
Dimensions 370 x 47'5" x 26'11 1/2" Hold 29'8" Mold
Scale 1 inch = one foot.



11.8.93.
15.8.93
24.10.93

Fore & main tracks to have 2 plates in the round
Beams overlapped & single riveted
Batts overlapped and 3/4" above deck, 2 1/2" below deck

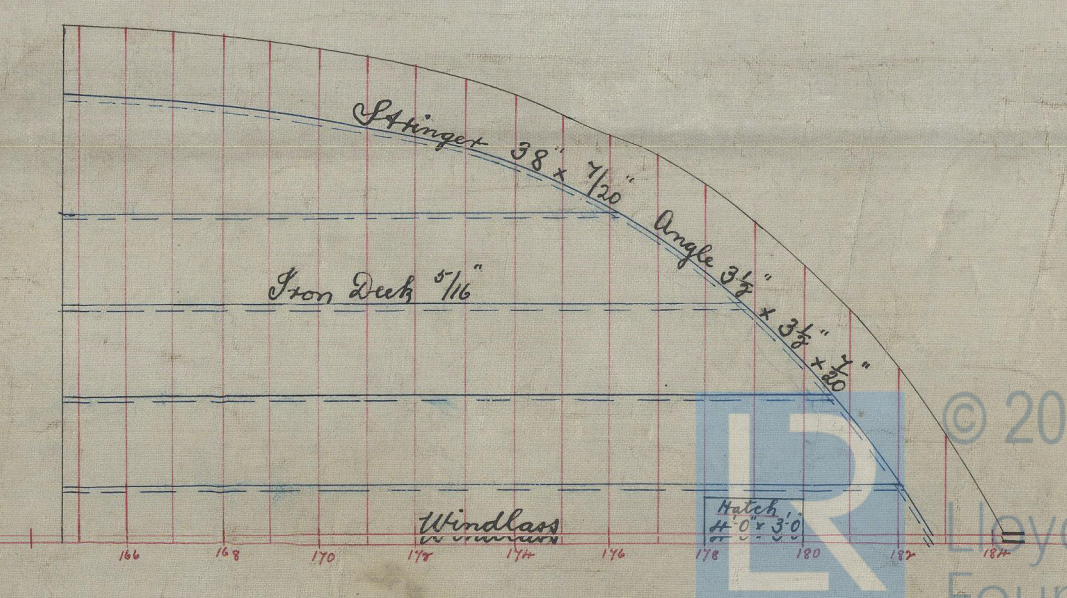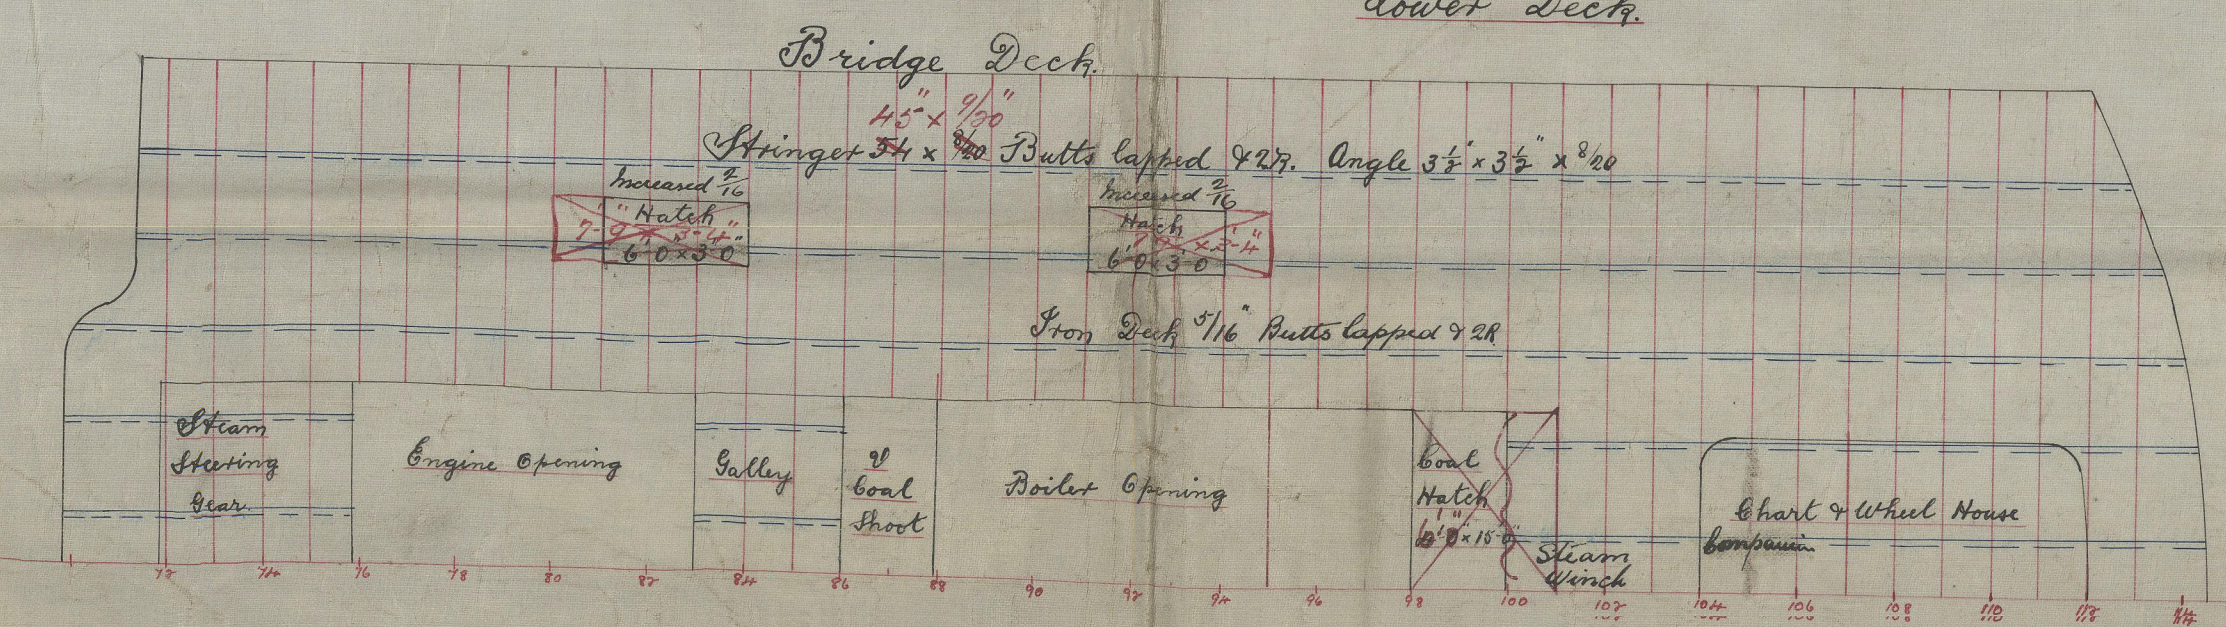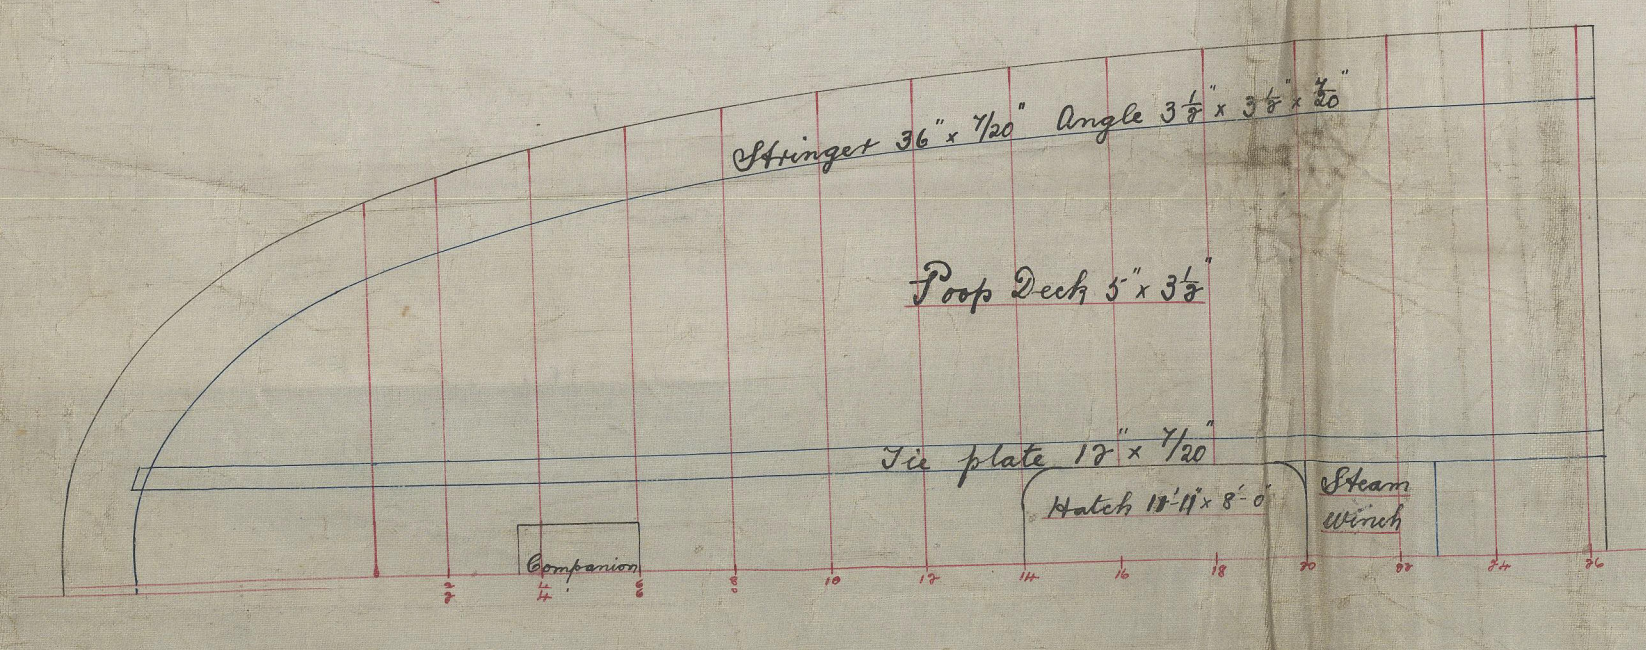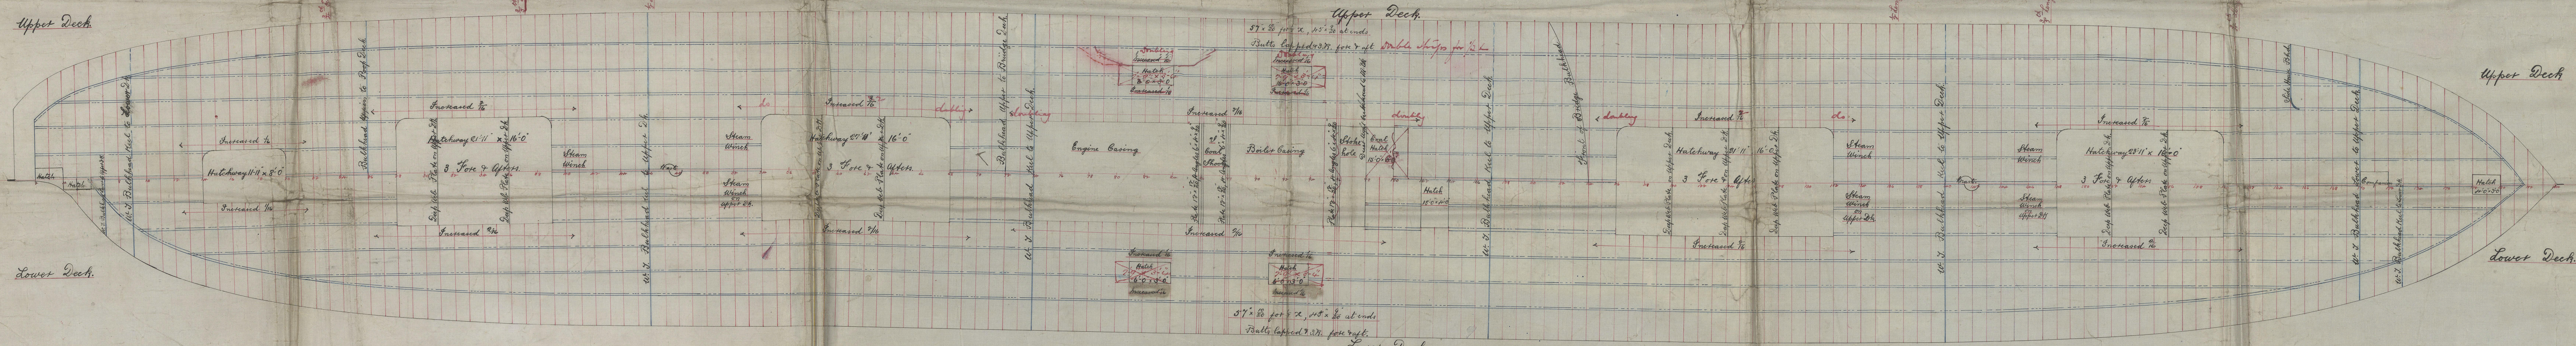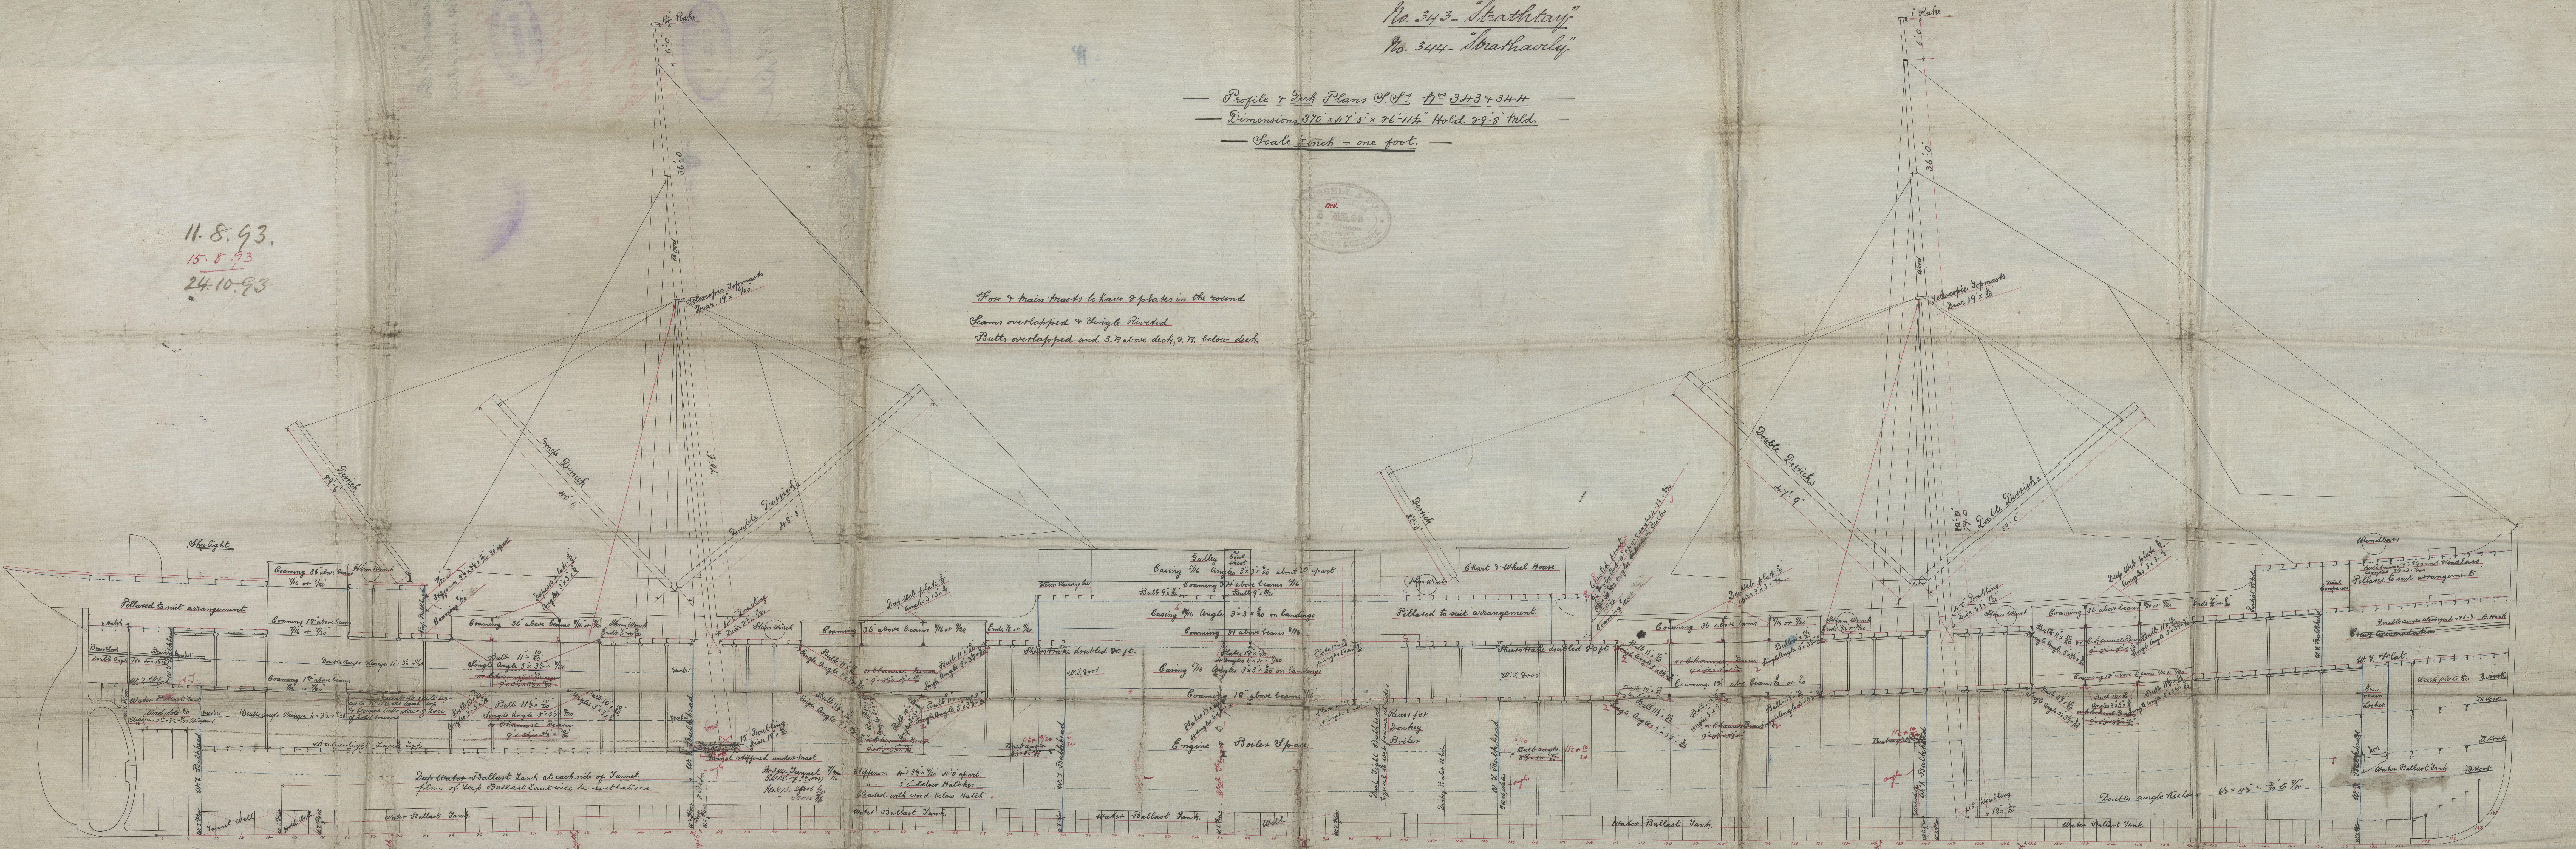

⁷²
Russell & Co's

No 343 & 344

Profile Map



"Shark Bay"

Gen. Rpt. 11006

Shark Bay

Rpt. 11041



909 Ba



© 2021

Lloyd's Register
Foundation
GRV 327-0076