

91




EP. 11.2

James Russell's
Nos. 343 & 44

Deep Ballast
Tank

"Sparktag"
G.L. Rpt. 11086

Sparktag
Rpt. 11086

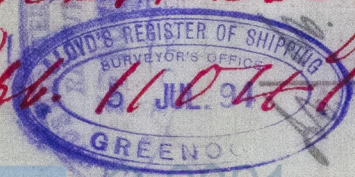

908 Bk

GRU 327 0077



