

28.9.93

Sketch showing compensation for openings in


Tank top under Boilers

S. S. No 343 + H

Scale $\frac{1}{4}$ inch = one foot.





Not adopted

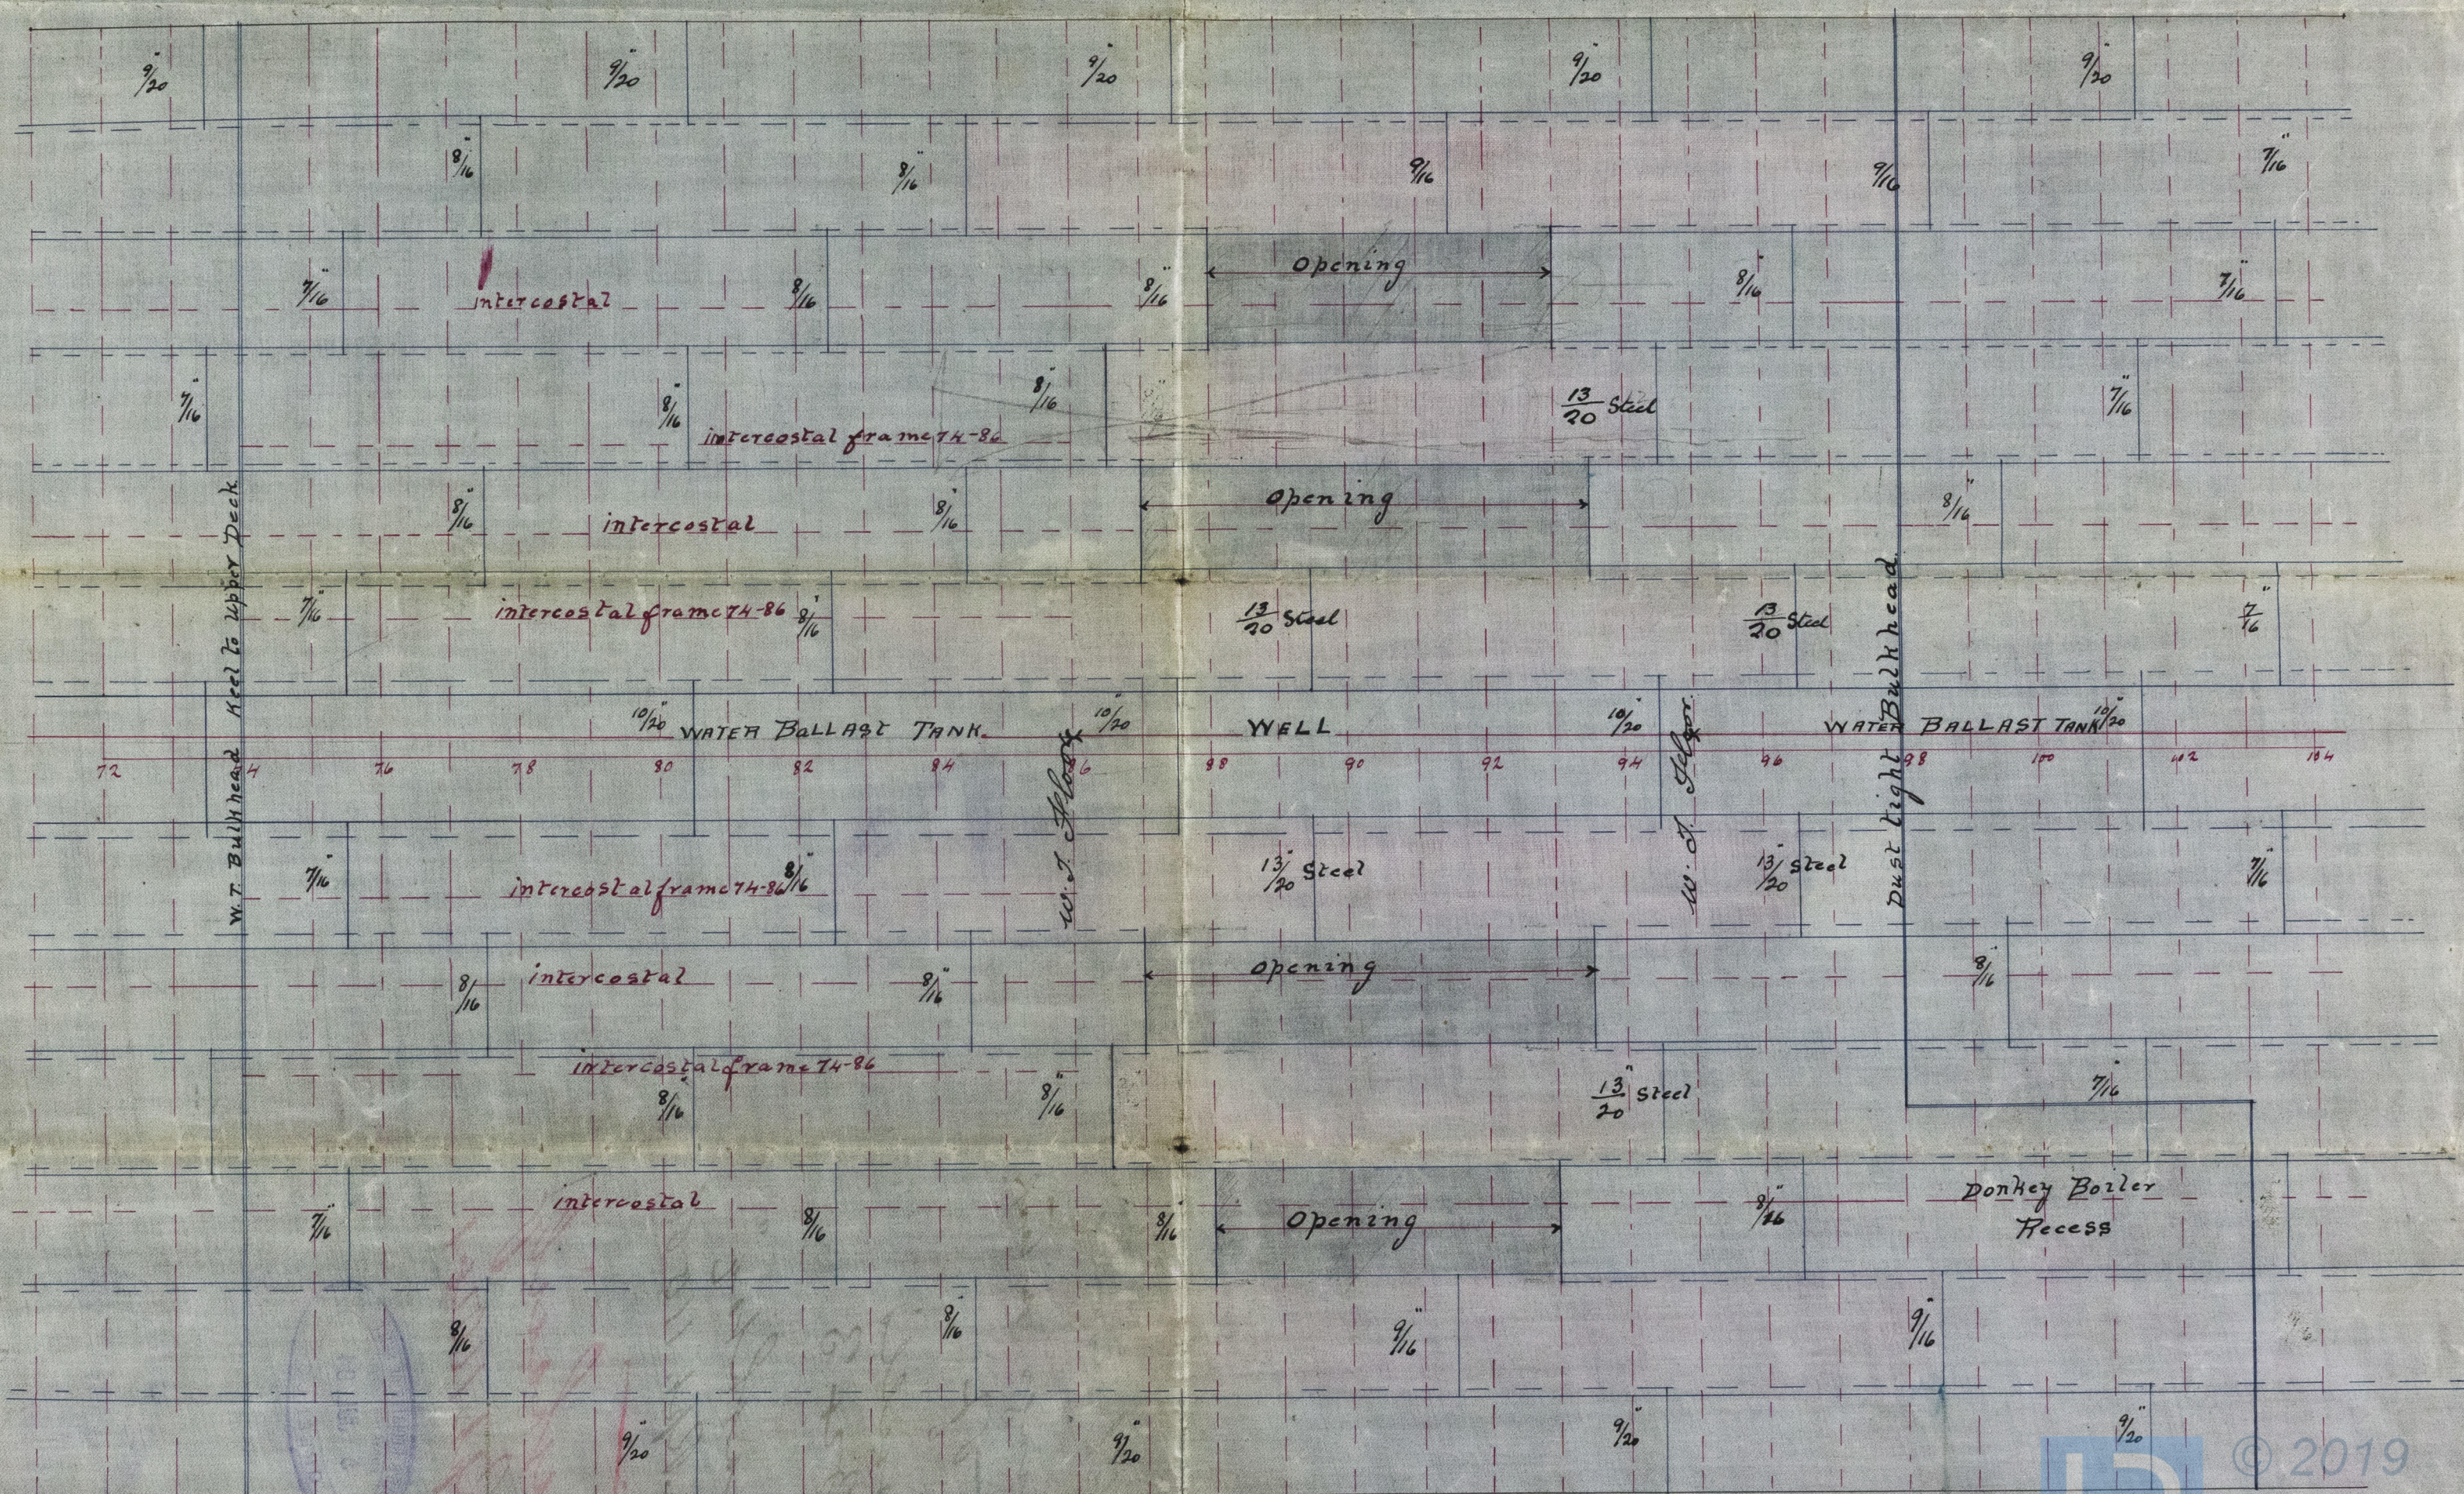

89.
Sketch showing
openings in tank
top of
Russell's
3243

"Shark" ¹²
Guk. Rpt. 11006

Shark
Guk. Rpt. 11001

 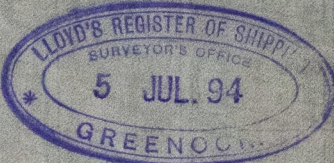

906 Ba
GRK327-0078

