

1 YDC 82


Russell & Coys 85.  
Nos 343 & 344

Section of Shingles  
"Shacktag"  
Gr. Rpt. 11006

Shacktag  
Rpt 11004




902 Ra

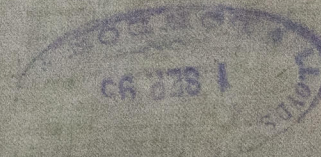




See ltr to Grk.  
2.9.93.

Section of Stringer  
in way of Boilers

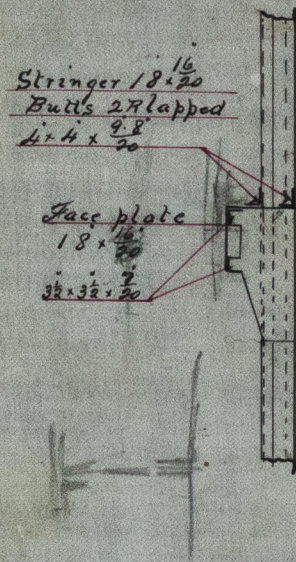


Section of Stringer as passed  
on Midship Section

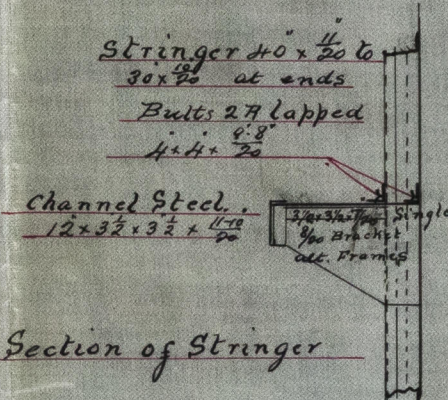


See separate sketch

Sketch of Hold Stringer  
in way of Boilers

S.S. N<sup>o</sup> 343 x 4  
Scale 1/4 inch = one foot

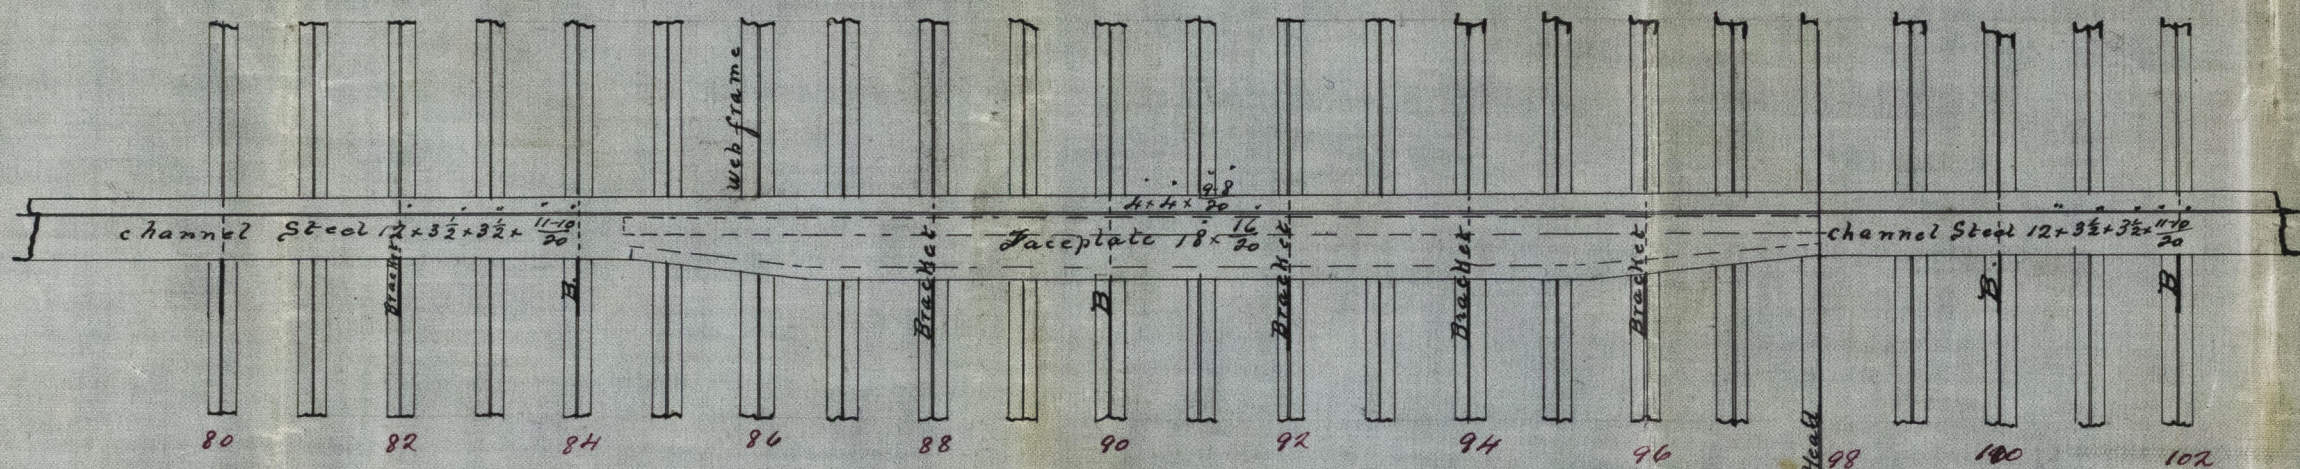

Elevation of Side stringer in way of Boilers

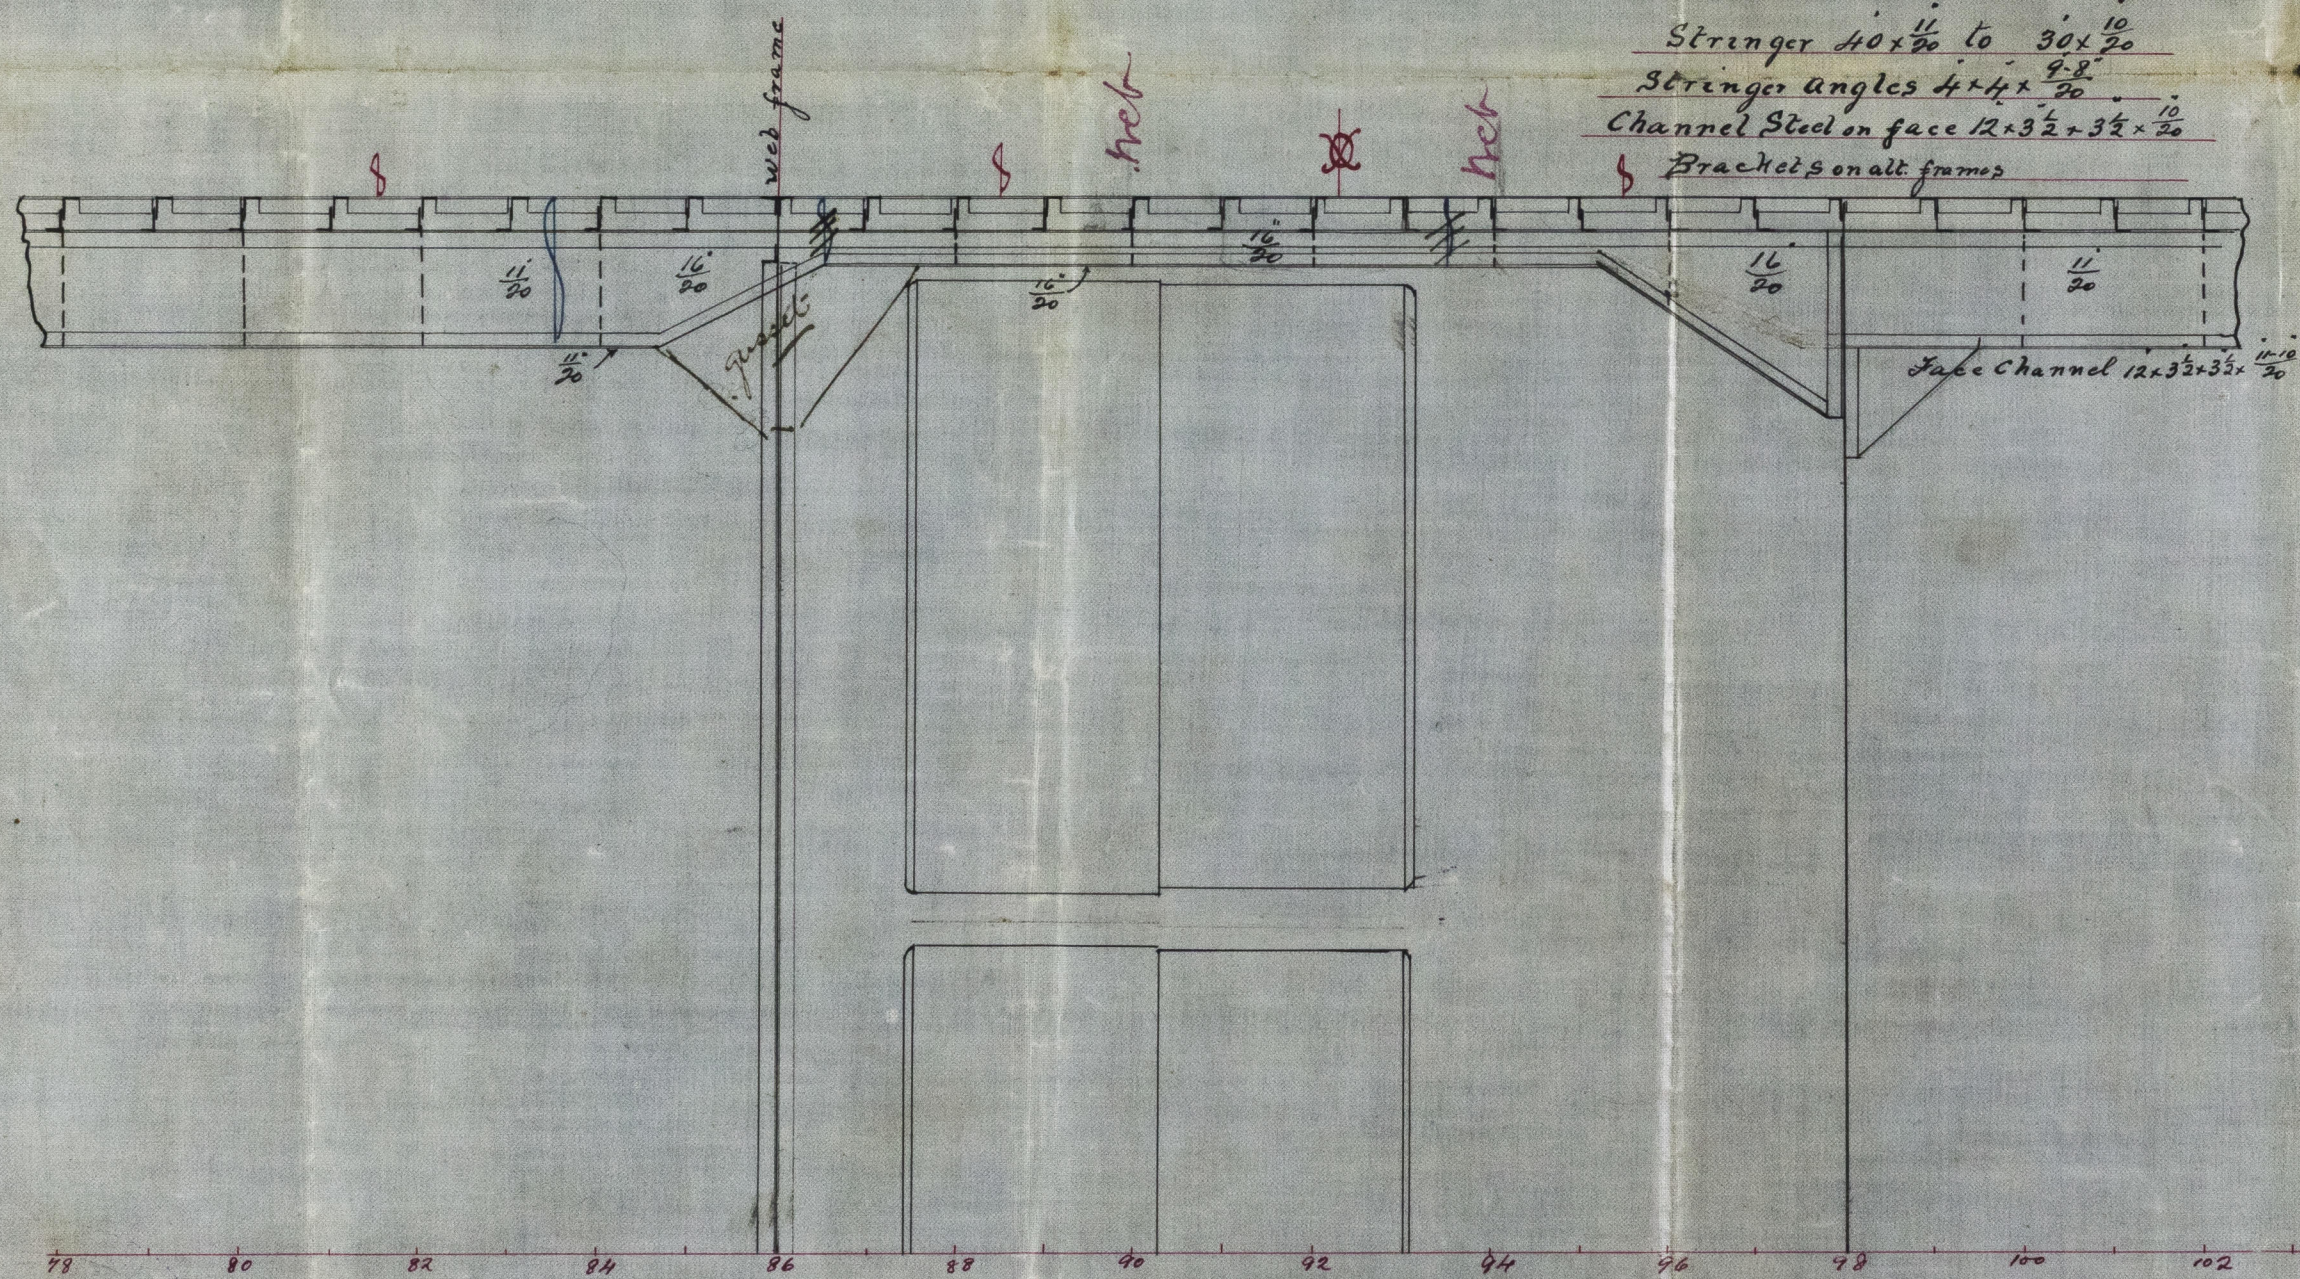

LLOYD'S REGISTER OF SHIPBUILDERS  
31 AUG 93  
GREENOCK

Lloyd's Register  
Foundation  
GRK 327-0079