
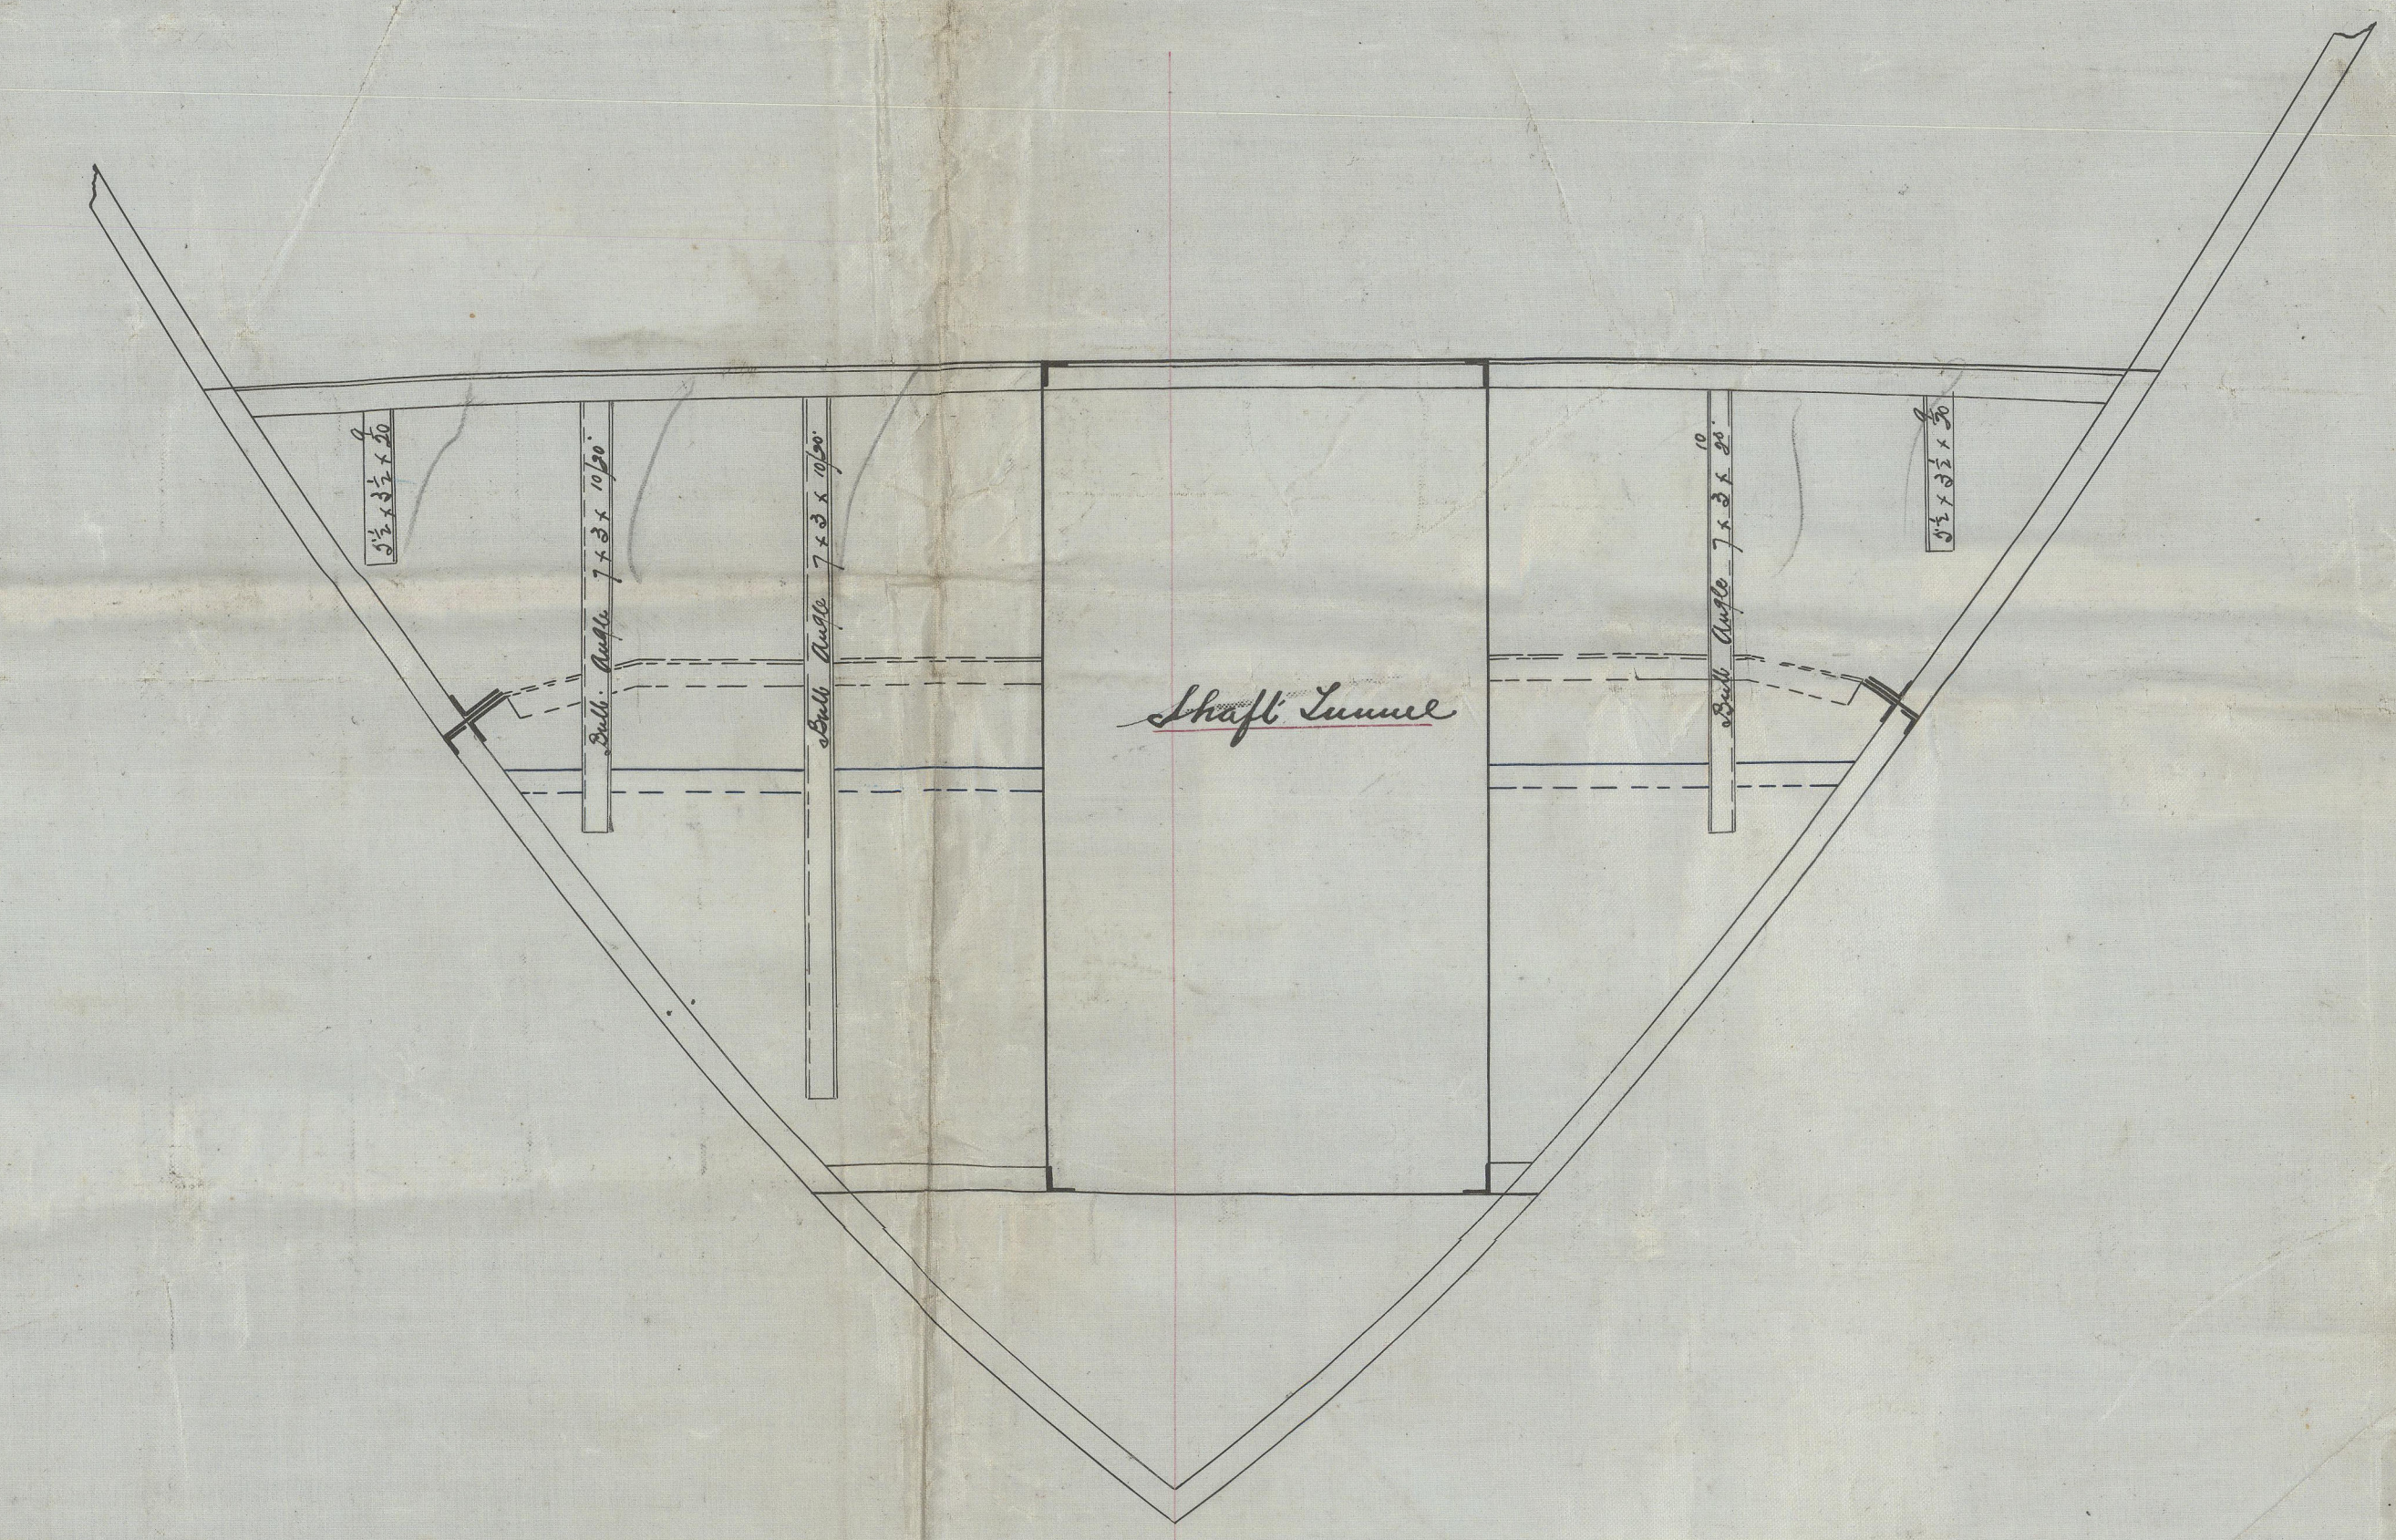
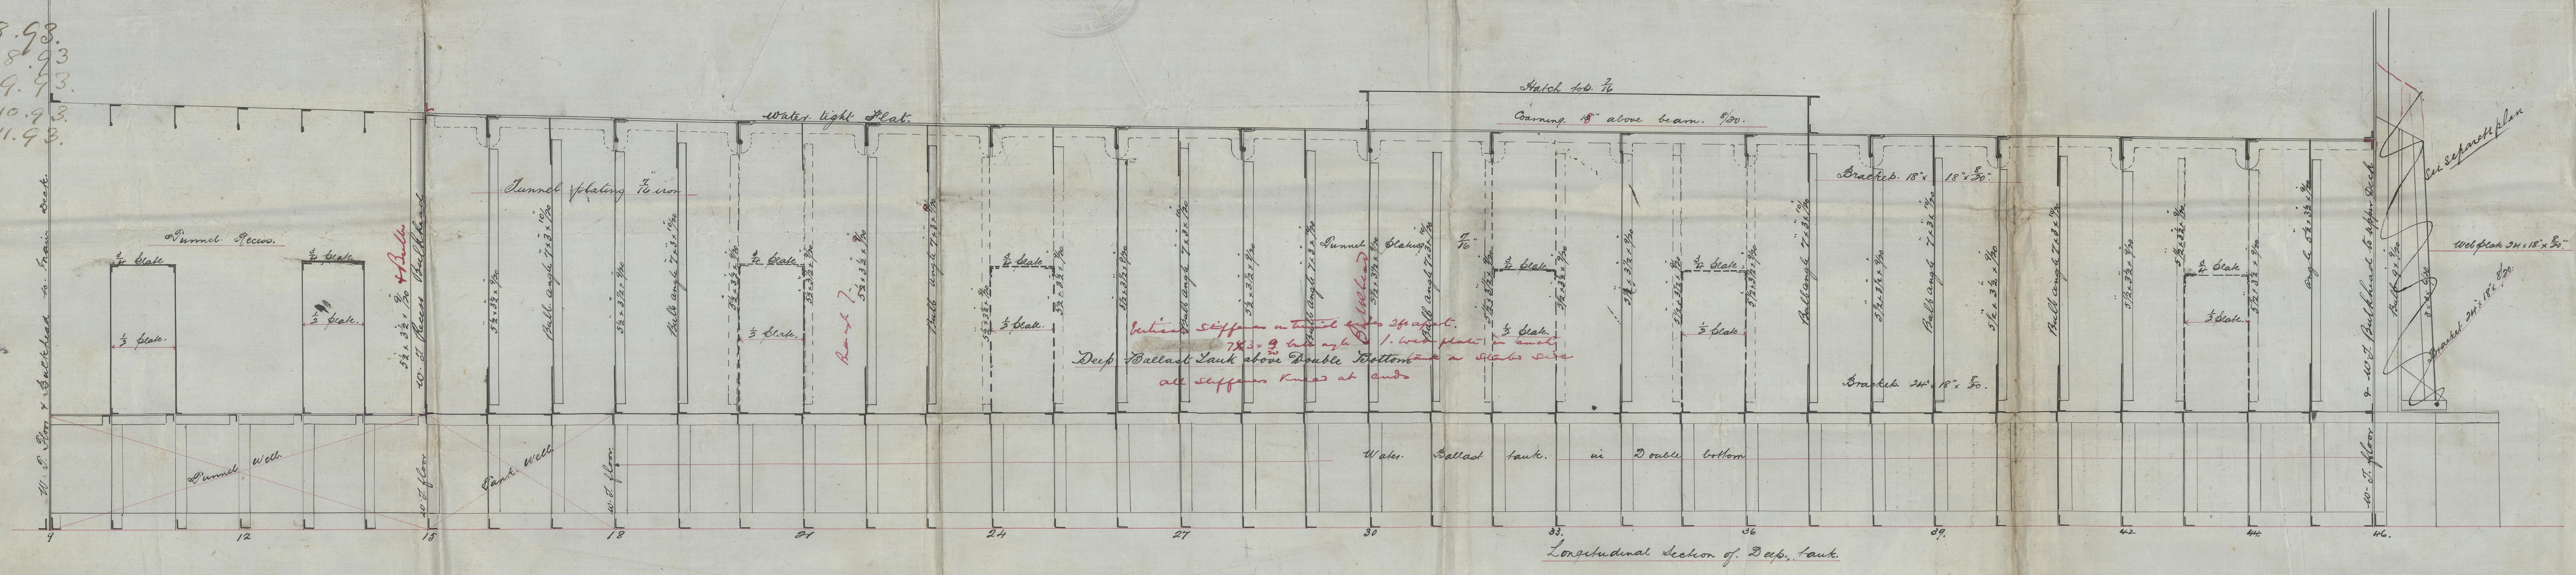


18.8.93
25.8.93
28.9.93
24.10.93
14.11.93


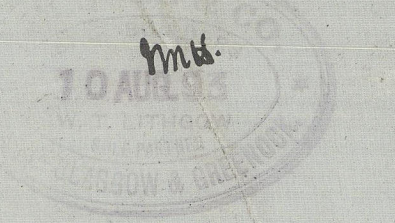


Plan of Deep Water-Ballast Tank

35° 10' 34' 3" 34 1/2"

Scale 1/2" = One foot

No. 343 - "Shanghai"
No. 344 - "Shanghai"

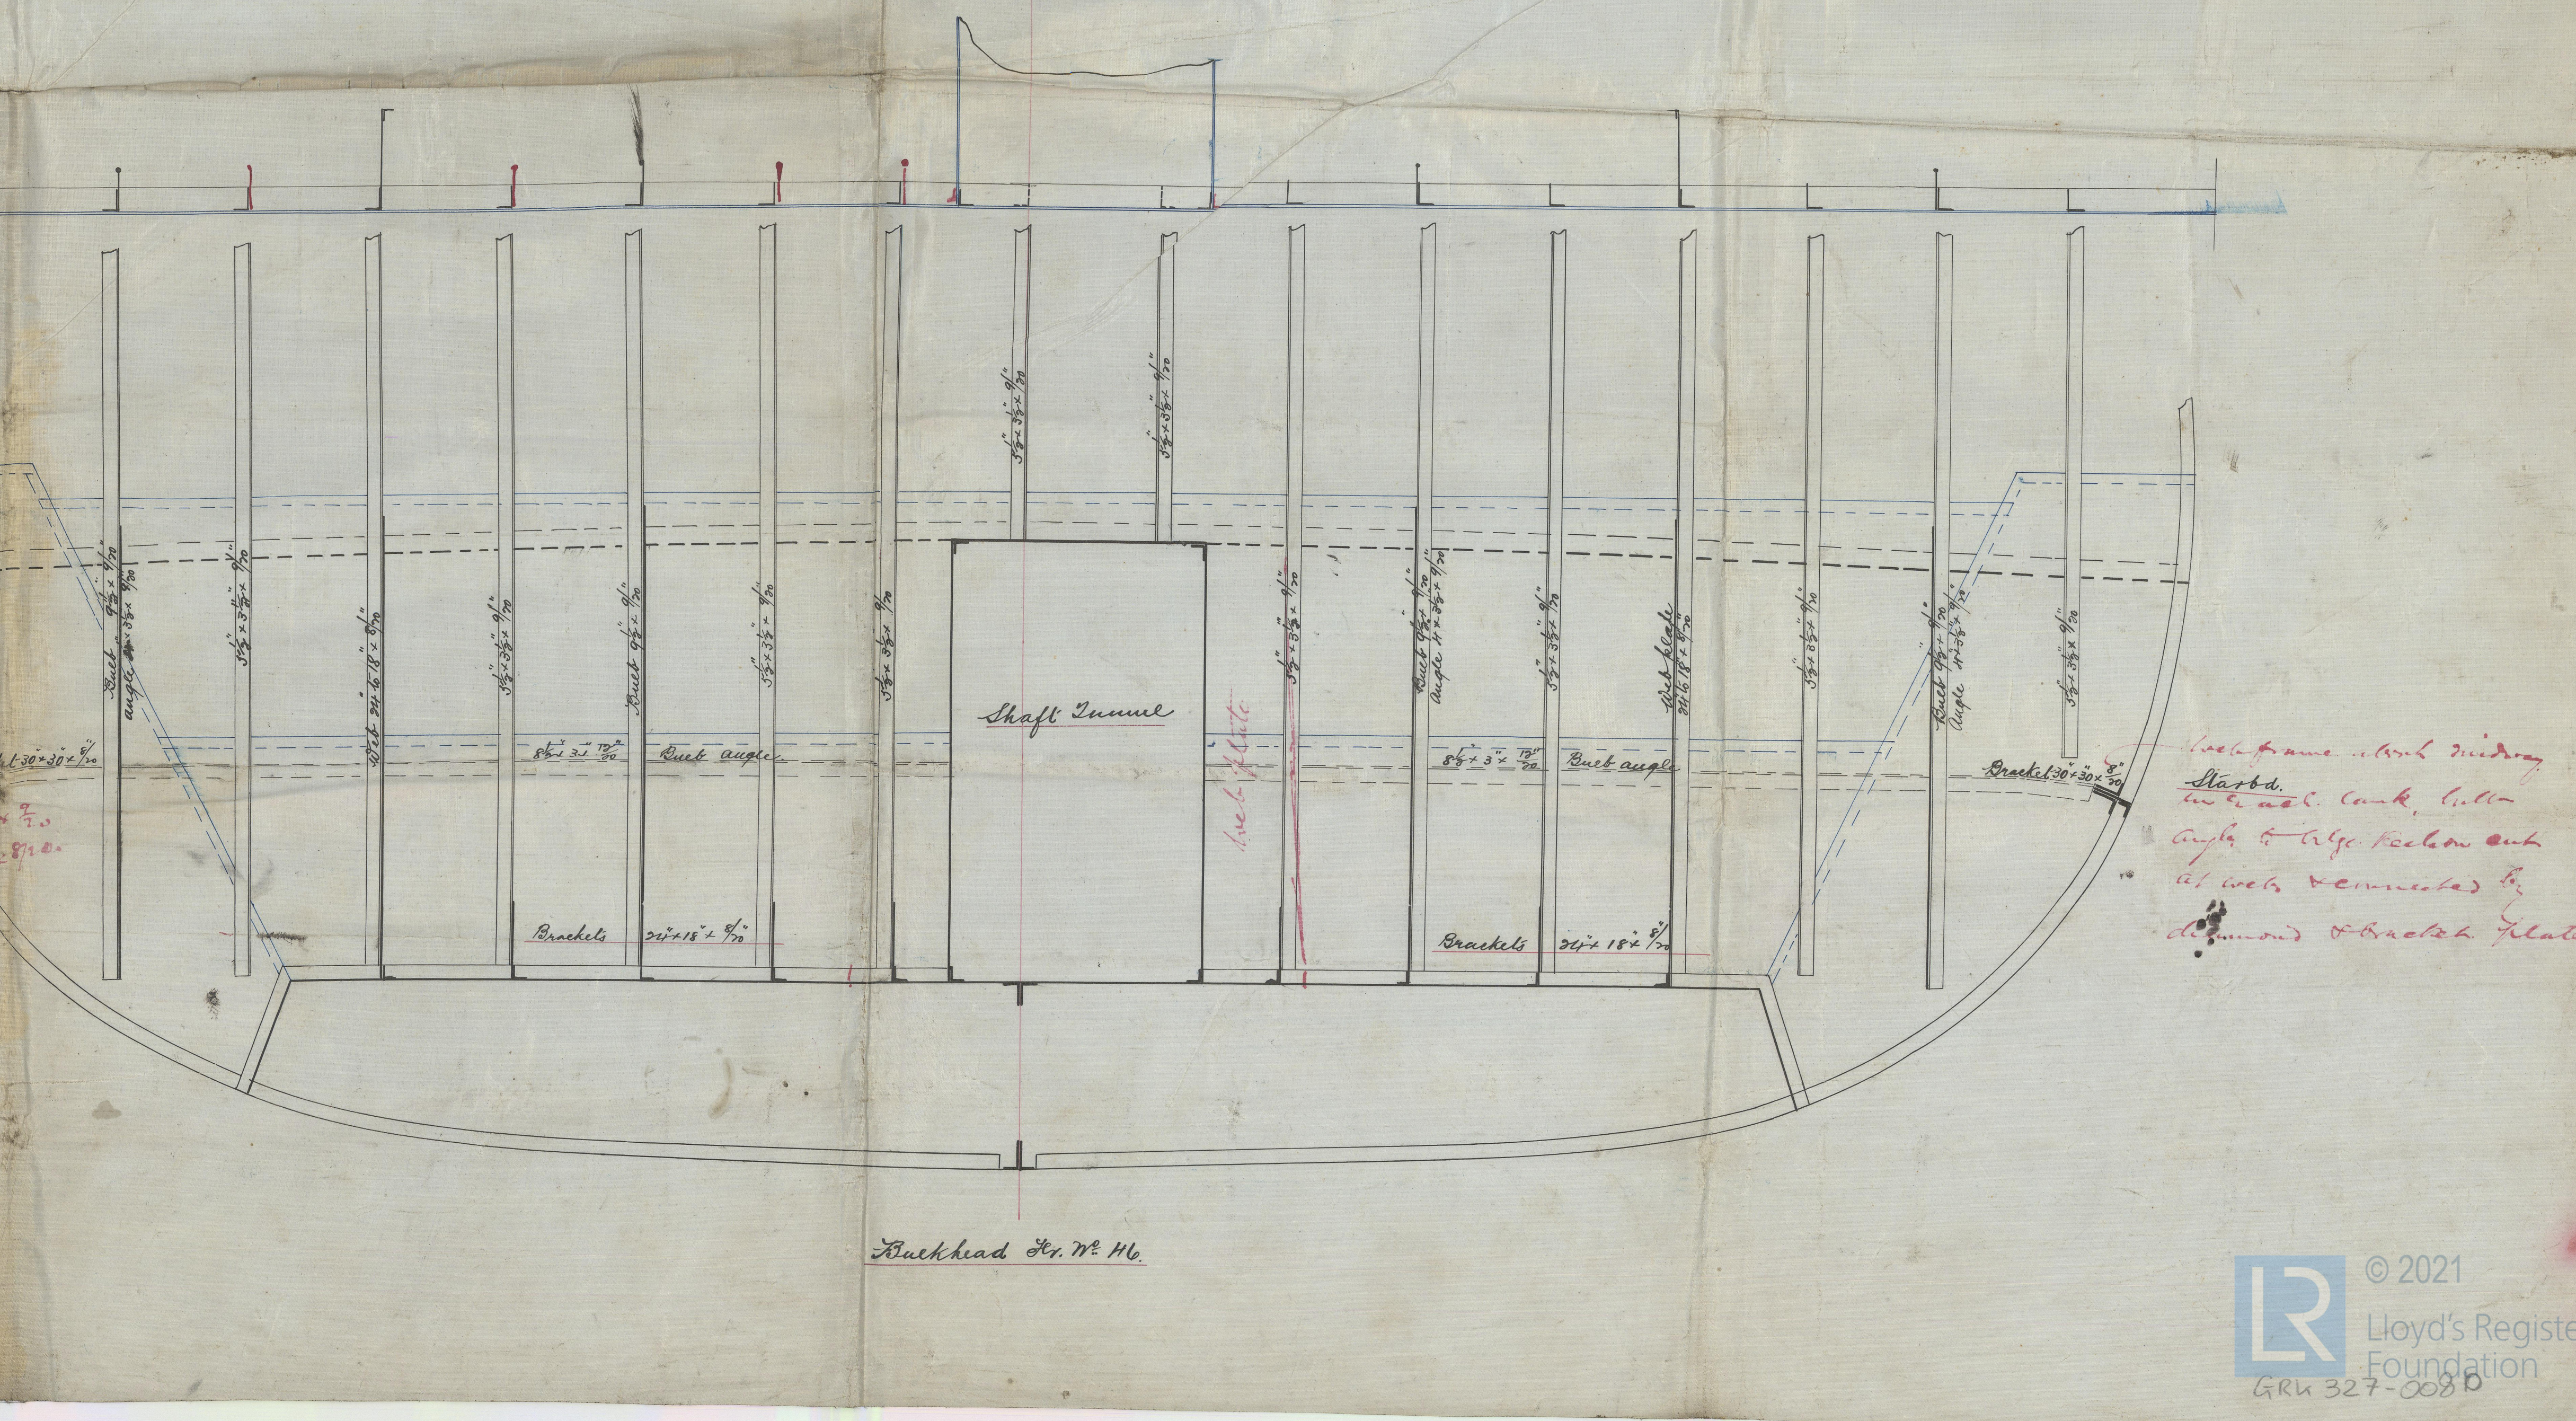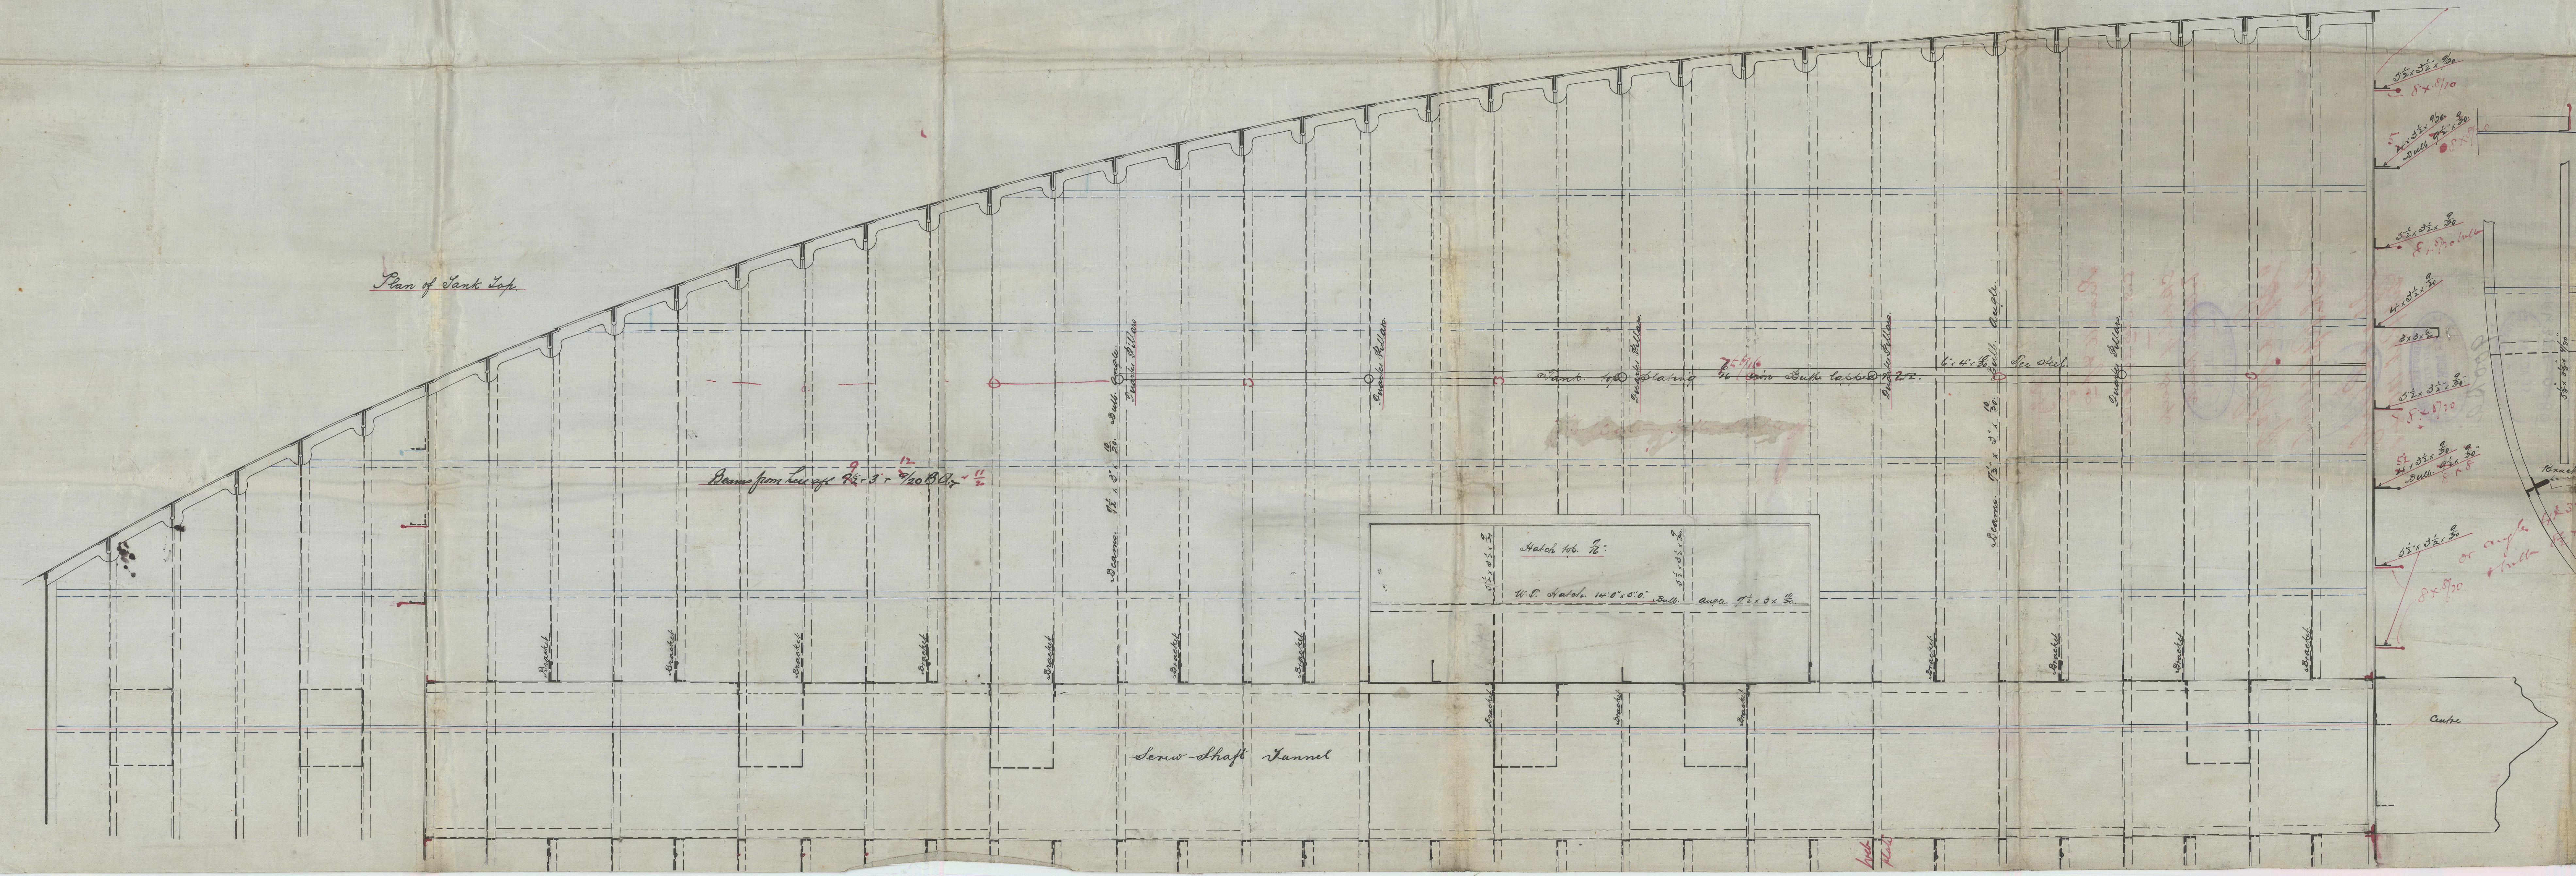

~~83~~
83
Russell & Co

S.S. no 343 + 344

Sketch of Deep
Ballast Tank



"Shark Bay"

Csh. Rpt. 11006

Shark Bay
Csh. Rpt. 11041



900 Ba



GRK 327-0080

Lloyd's Register
Foundation